


Addendum D - General Floor Plan - Page 2 of 2

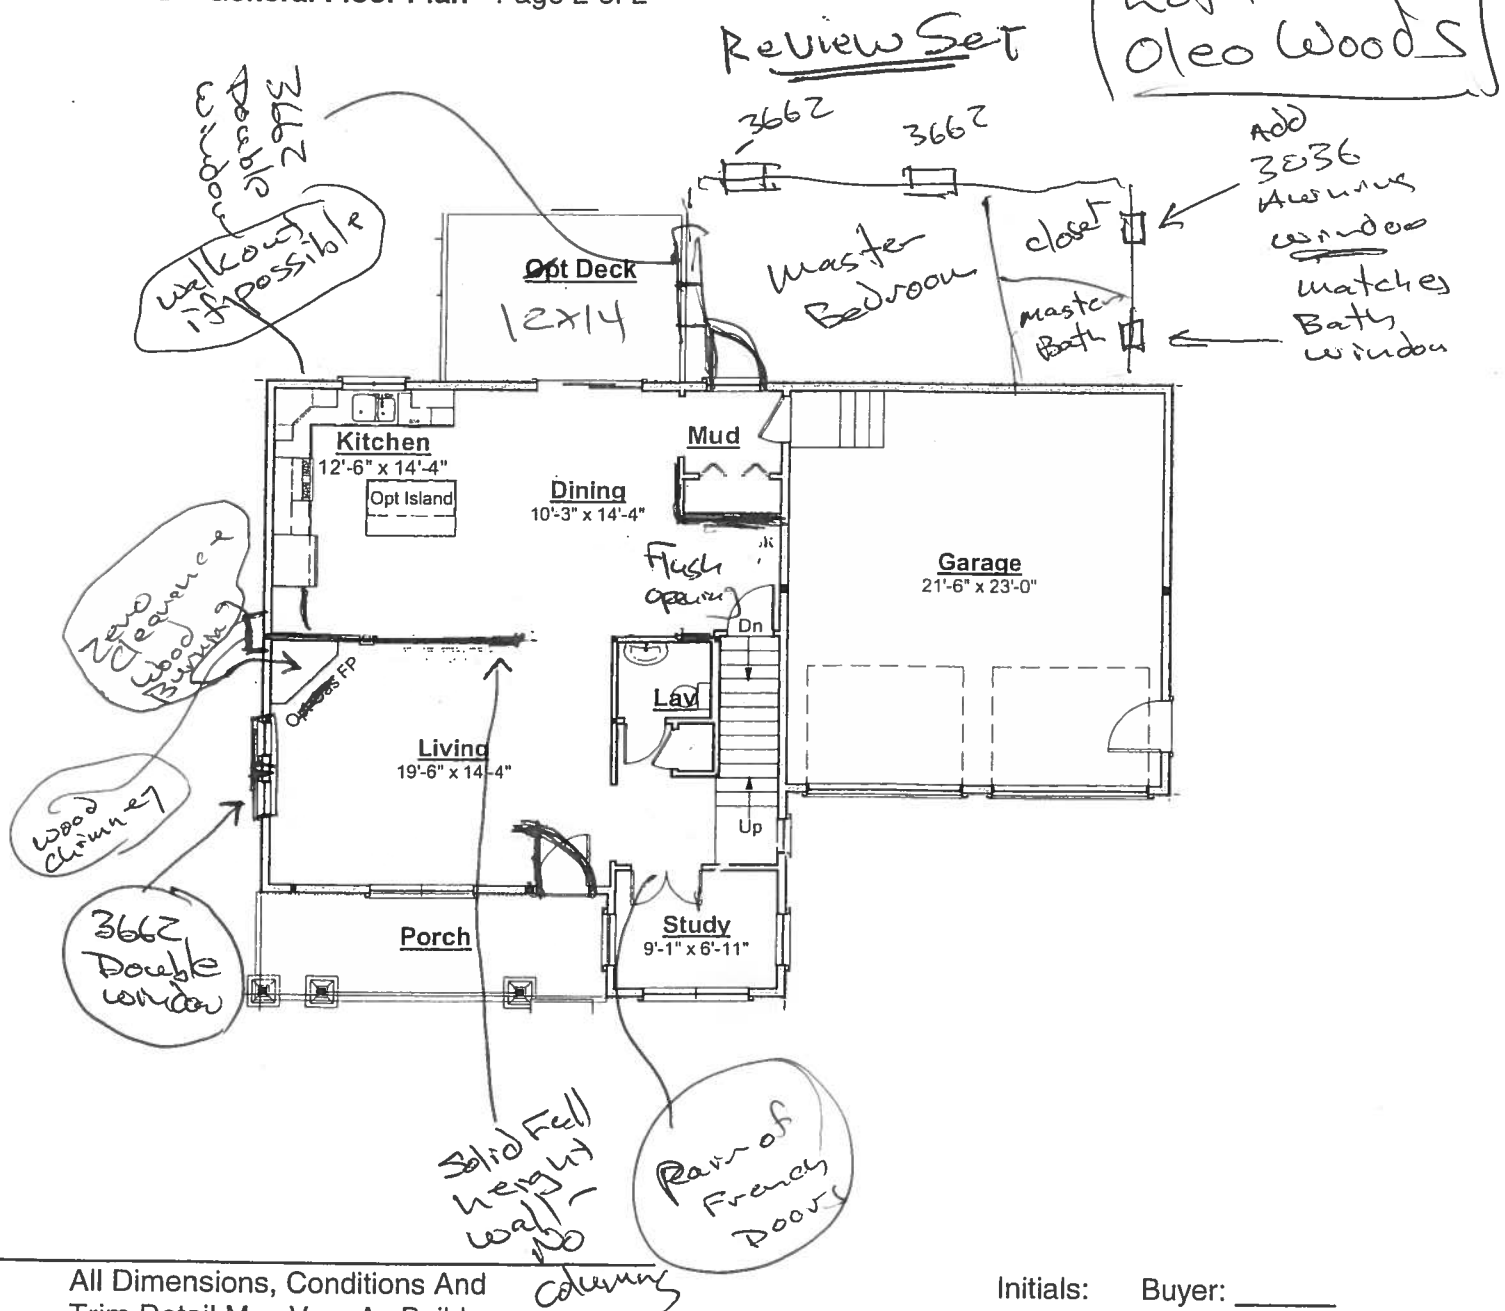


1. All Dimensions, Conditions And Trim Detail May Vary As Builder Deems Necessary In The Field.
2. Scale On Copies From Original Mylar Prints May Vary Slightly.

Initials: Buyer: _____

 Buyer: _____


 Seller: _____

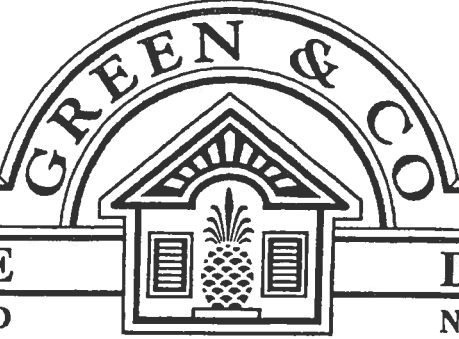

REAL ESTATE 11 LAFAYETTE ROAD PHONE: (603) 964-7572	DEVELOPMENT NO. HAMPTON, NH 03862 REALTORS®	FAX: (603) 964-7574
--	--	---------------------

Addendum D - General Floor Plan - Page 1 of 2

Review Set
Master Below

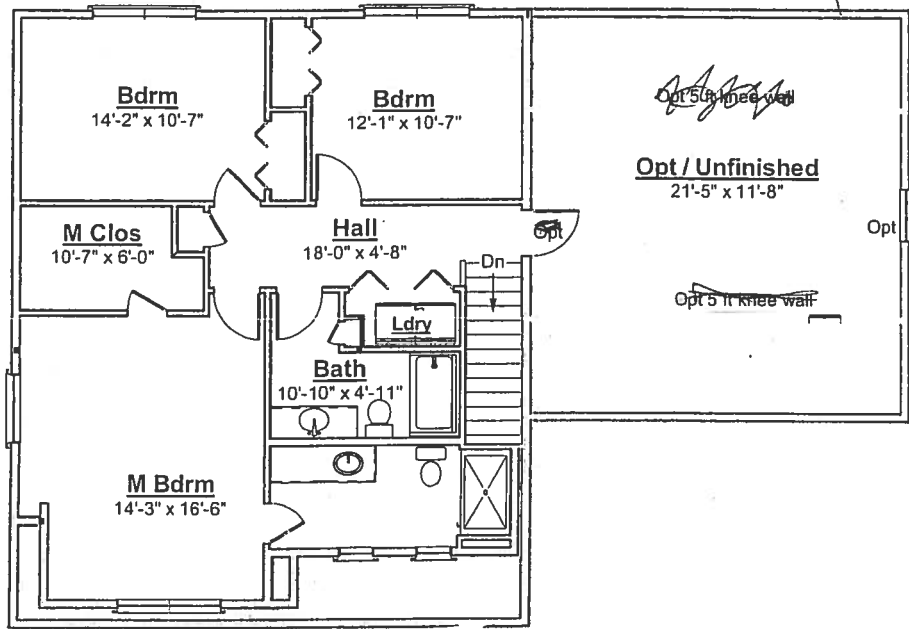

1. All Dimensions, Conditions And Trim Detail May Vary As Builder Deems Necessary In The Field.
2. Scale On Copies From Original Mylar Prints May Vary Slightly.

Initials: Buyer: _____

 Buyer: _____

 Seller: _____