1

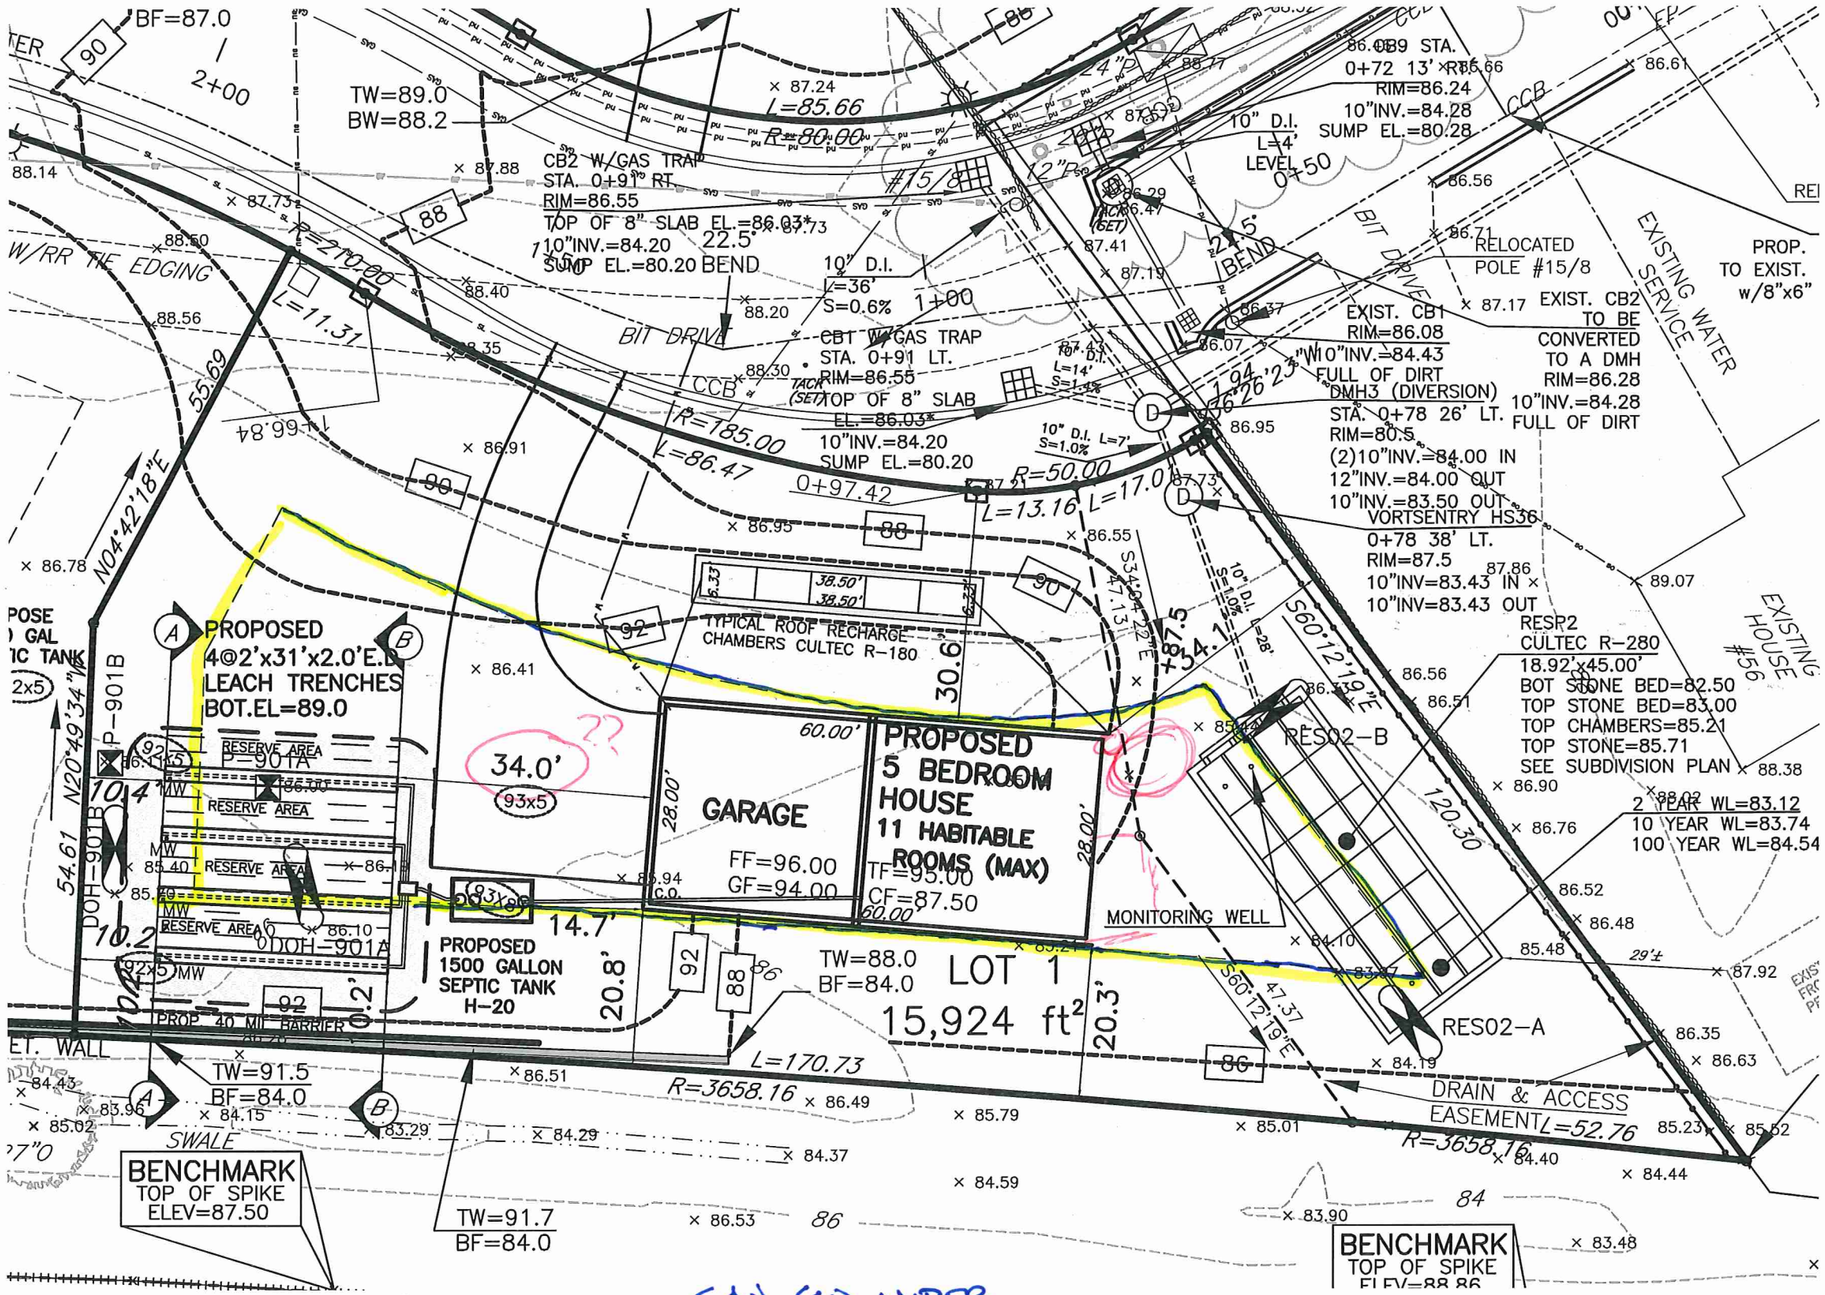

CAN GO WIDER
WITH FRONT ENTRY
BUT NEED TO AVOID TANK.