

Wall Types

Exterior walls 2x6 wood stud
Interior walls 2x4 wood stud, unless noted otherwise

Wall Keys

- 1 2x wood studs on the flat
- 2 2x wood stud wall, 16" oc
- Note: 2x4 wood stud wall, 16" oc unless otherwise noted

Key Notes

- 1 30" x 22" Minimum Allow Access Panel - Insulated (R0 34" x 28")
- 2 Field locate for plumbing or mechanical
- 3 Verify size of fixture or appliance. Adjust dimensions to accommodate
- 4 Center - Place door or window centered on wall
- 5 Smoke Detector
- 6 Heat Detector
- 7 Carbon Monoxide Detector

Dimensions

- 1. Dimensions are to face of stud, unless noted otherwise.
- 2. Closets are 24" clear height, unless dimensioned otherwise.

Square Footages


- 1. Sq ft numbers are in order to room for use in calculating finishes.
- 2. Cabinets and fixtures not subtracted.
- 3. Add for downways when floor finishes run through.

Notes

- 1. Exterior walls 2x6 wood stud @ 16" oc. Provide insulation & vapor barrier conforming to state or local codes. Interior sheathing 1/2" gypsum board. Provide 1/2" exterior rigid sheathing, brace with 2x4s at 16" oc. 
- 2. Interior walls 2x4 wood stud @ 16" oc, unless noted otherwise.
- 3. Roof - see structure for rafter spans. Provide 1/2" exterior rigid roof sheathing, 1/2" roofing felt, ice & water shield at eaves and valleys, aluminum drip edge and asphalt shingles or metal roofing. Structure not calculated to support slate or tile. Flash at penetrations. Provide cricket at any added chimneys.
- 4. Provide roof and/or ceiling insulation per code. Provide soffit and ridge vents where required for insulation strategy. Verify with code officer - closed cell spray foam or double-paneled cellulose installed at eaves and ridge ridge and eaves generally come with eaves vents, but insulation always requires venting.
- 5. Provide smoke, carbon monoxide, and heat detectors where shown and where required by code and where required by local authorities.
- 6. Provide fire resistive materials where required by code, including but not limited to: fireproofing at penetrations, 5/8" Type X drywall on walls and ceilings to separate garage (where garage pressed in design) from dwelling, and separation of dwellings (where more than one dwelling present in design), and protection of flammable insulation materials. See Table R308.6 IRC 2015.
- 7. Compliance with code requirements for room size and clearances, hallway widths, room sizes, and assume 12" crawl on walls and 12" drywall on 3/4" strapping on ceilings. Adjust as required if materials differ.
- 8. Shower is only called out where Continuous Portal Frame will not suffice. See Section R602.10.4 (Pages 177 - 180) of the IRC 2015.

General Design Notes

- 1. Builder shall consult and follow the building code and other regulations in effect for the building use for all construction details not shown in these drawings. Requirements described here are specific to this design and/or are provided as reference. Additional building code or local requirements may apply.
- 2. Builder shall maintain a safe worksite, including but not limited to, provision of temporary supports where appropriate and adherence to applicable safety standards.
- 3. Design is based on the snow load listed on the framing plans, 100 mph basic wind speed, Exposure type II, and soil bearing capacity of 2000 psf and Seismic Category C, unless otherwise noted on the framing plans. Builder shall promptly inform Artform Home Plans of differing conditions.

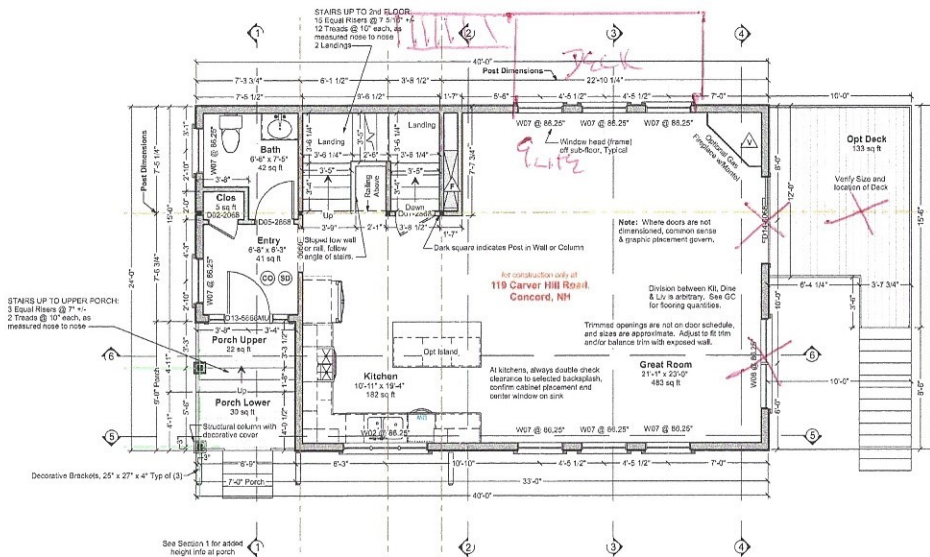

First Floor Plan
Living Area this Floor: 897 sq ft
8ft Finished Ceiling Height

DOOR SCHEDULE									
NUMBER	QTY	FINISH	SIZE	DOOR	HEIGHT	TYPE	REMARKS	COMMENTS	

WINDOW SCHEDULE									
NUMBER	QTY	FINISH	SIZE	WINDOW	HEIGHT	TYPE	REMARKS	COMMENTS	
Door & Window Notes

- 1. **Rated Doors:** Provide fire rated and/or self-closing doors where required by local codes or local authorities.
- 2. **Trimmed Openings:** Trimmed openings not shown on schedule. See Plan.
- 3. **Window Tempering:** Provide tempered windows where required by local codes or local authorities. Tempering columns provided here for convenience. Windows have not been reviewed for tempering requirements.
- 4. **Window R04:** 1/4" or 1/2" on each of 4 sides allowed for window R04, typical. Review framing size vs R04 size. Adjust per manufacturer's requirements and/or builder preference.
- 5. **Egress Windows:** Provide minimum one door or window meeting egress requirements in basement, in each sleeping room, in each potential sleeping room, and other locations required by local code, in size required by local code. Note that egress windows must be provided by manufacturer as meeting IRC 2015 egress requirements typically need to be ordered with specific hardware. Emergency Escape Window Sizes (Section R310.2.1, R310.2.2, R310.2.3, R310.2.4, and R310.2.5). V01 also comply with NFPA 101.
- 6. **Basement Windows:** Add basement windows as required to meet state or local code requirements, including but not limited to egress and light-ventilation.
- 7. **Skylights:** Skylights are not shown on this schedule, but may be required. Consult builder and see floor plan.
- 8. **Minimum window sill height:** IRC 2015 requires that floor window sills be 24" from floor. Confirm bottom of window opening relative to frame. Conform to IRC 2015 R312.1.

Dragonfly



Dear Code Officer,

These are pre-engineered home plans, designed to bring good design and construction drawings to people at more affordable prices and faster time frames than traditional architecture. Where traditional "custom" home plans exist in all regions, they are all responsibility between us (Artform) and the owner. We encourage the future homeowners to use a quality builder who can assist them with this. They are responsible for thermal and moisture details and for meeting code in ways that a quality builder should know without an explicit callout. We are responsible for things that are directly related to the design and/or that a quality builder would reasonably figure out or that we explicitly call out in the following IRC 2015 code sections:

- 1. Return Airs (Section R104)
- 2. Ceiling Height (Section R305)
- 3. Floor Joists & Ceiling Height (Section R305)
