

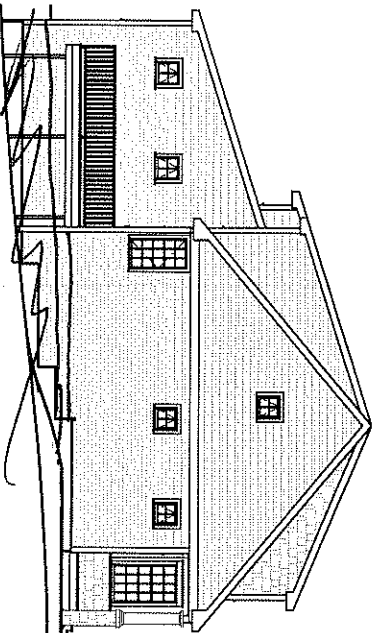
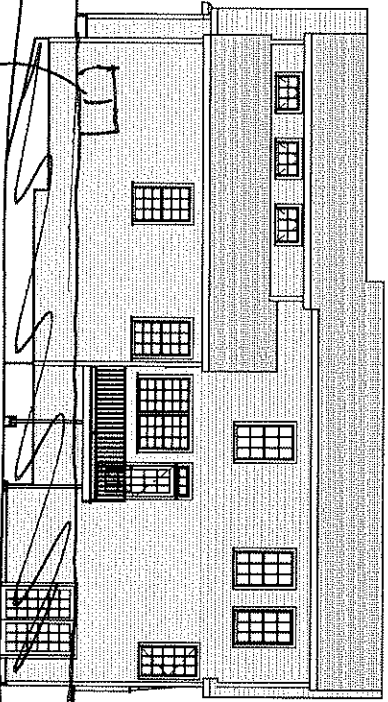


July Calla Premier 489.001

© 2012 Wendy Welton, all rights reserved. You may not build this design without purchasing a license, even with changes. Some Artform designs have geographic restrictions. Contact the Builder or RE Agent or call Artform at 603-431-9559

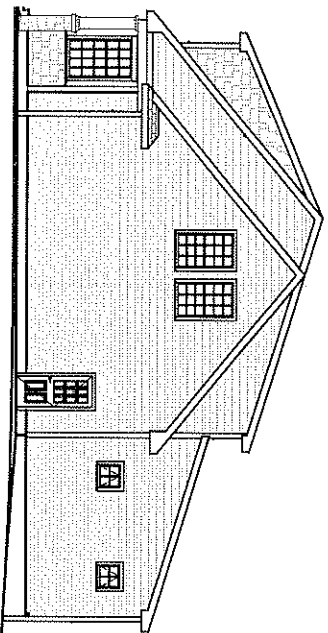

Chinburg Builders 603-868-5995

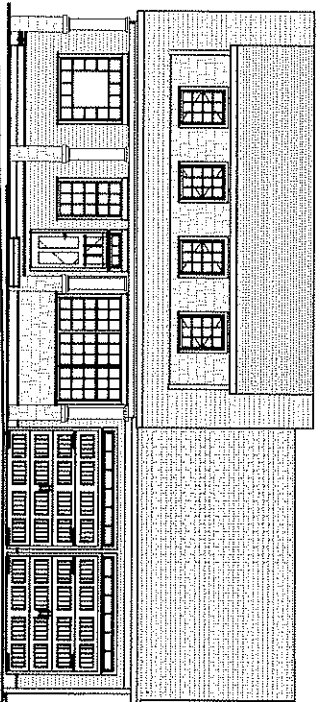

bulkhead

Builder's written specifications
always govern. Some items shown
are optional or may vary, including
but not limited to:

- Gas fireplace and surround
- Kitchen - island, cabinet style & trim, counter material, etc.
- Bath - vanity size, number / style of sinks, tub or shower...
- Other built-ins.
- Door styles and trim
- Window grilles and trim, window treatments
- Stair balusters or low walls at stairs
- Lighting
- Material selections (flooring, siding, roofing, paint colors...)
- Landscaping, paving and walkways
- Gutters, shutters and other exterior trim components
- Deck - size, railing style, stair location, etc.
- Amount of exposed basement and/or wood framed walls at basement.

These images are not of any specific building site. Sun and view through windows will vary, as will the site surrounding the house and the slope of the land.


July Calla Premier
489.001

© 2012 Wendy Welton, all rights reserved. You may not build this design without purchasing a license, even with changes. Some Artform designs have geographic restrictions. Contact the Builder or RE Agent or call Artform at 603-431-9559

Artform Home Plans

Chinburg Builders 603-868-5995

First Floor

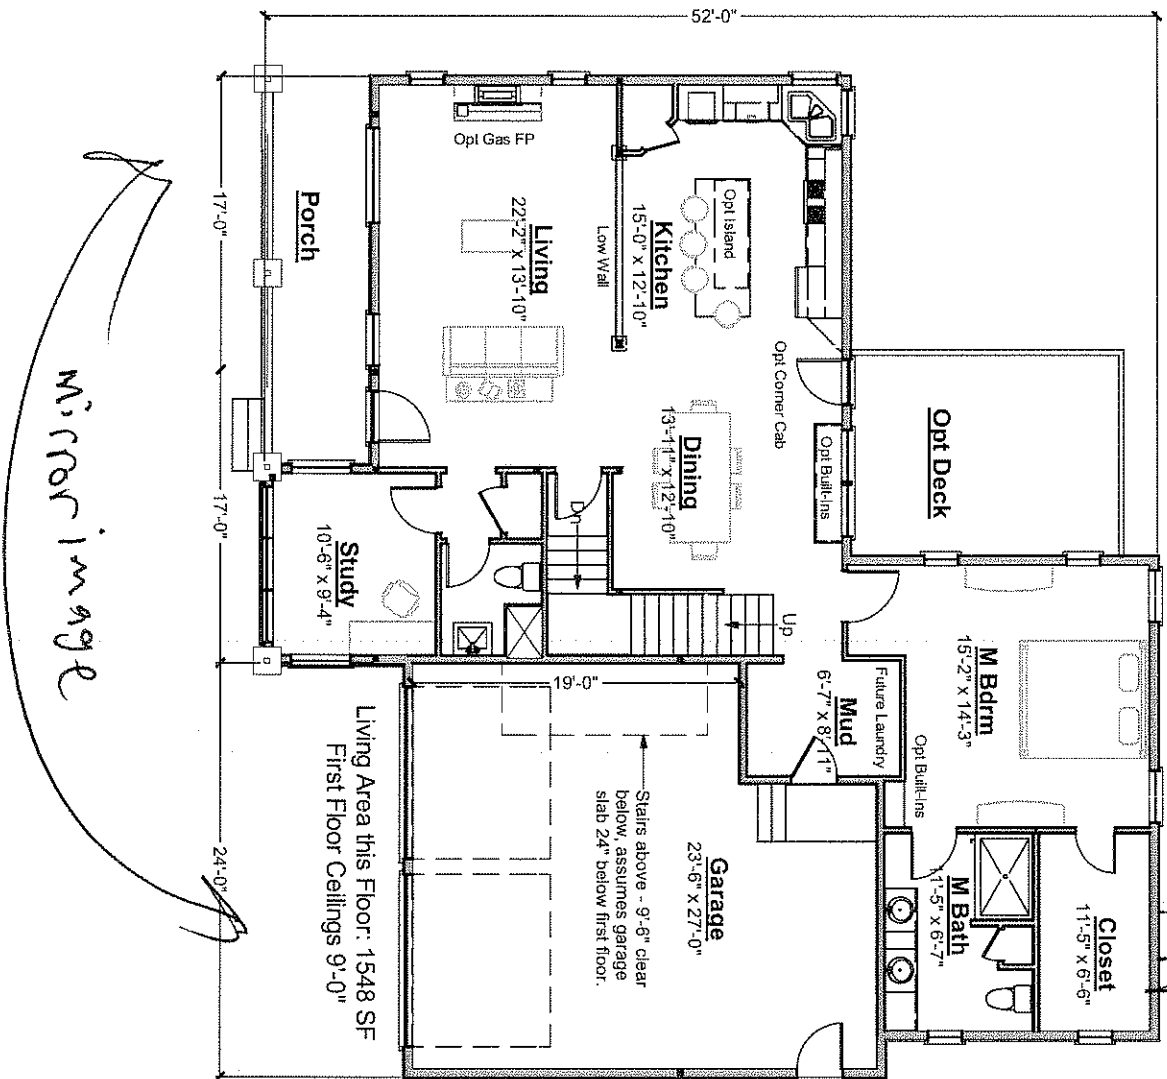


July Calla Premier 489.001

© 2012 Wendy Welton, all rights reserved. You may not build this design without purchasing a license, even with changes. Some Artform designs have geographic restrictions. Contact the Builder or RE Agent or call Artform at 603-431-9559

 **Artform Home Plans**
Chinburg Builders 603-868-5995


Second Floor

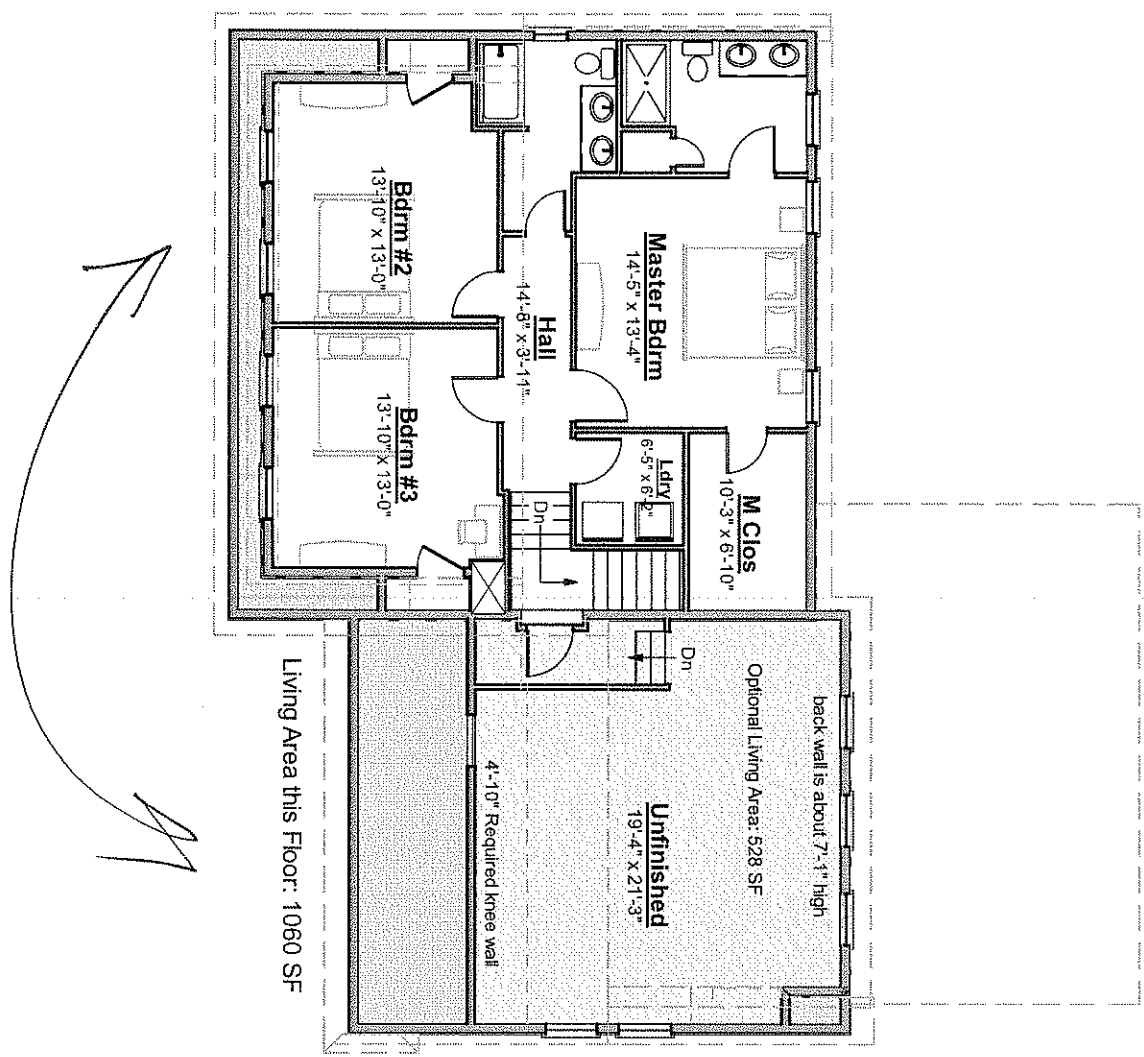

July Calla Premier 489.001

© 2012 Wendy Welton, all rights reserved. You may not build this design without purchasing a license, even with changes. Some Artform designs have geographic restrictions. Contact the Builder or RE Agent or call Artform at 603-431-9559

Lower Level

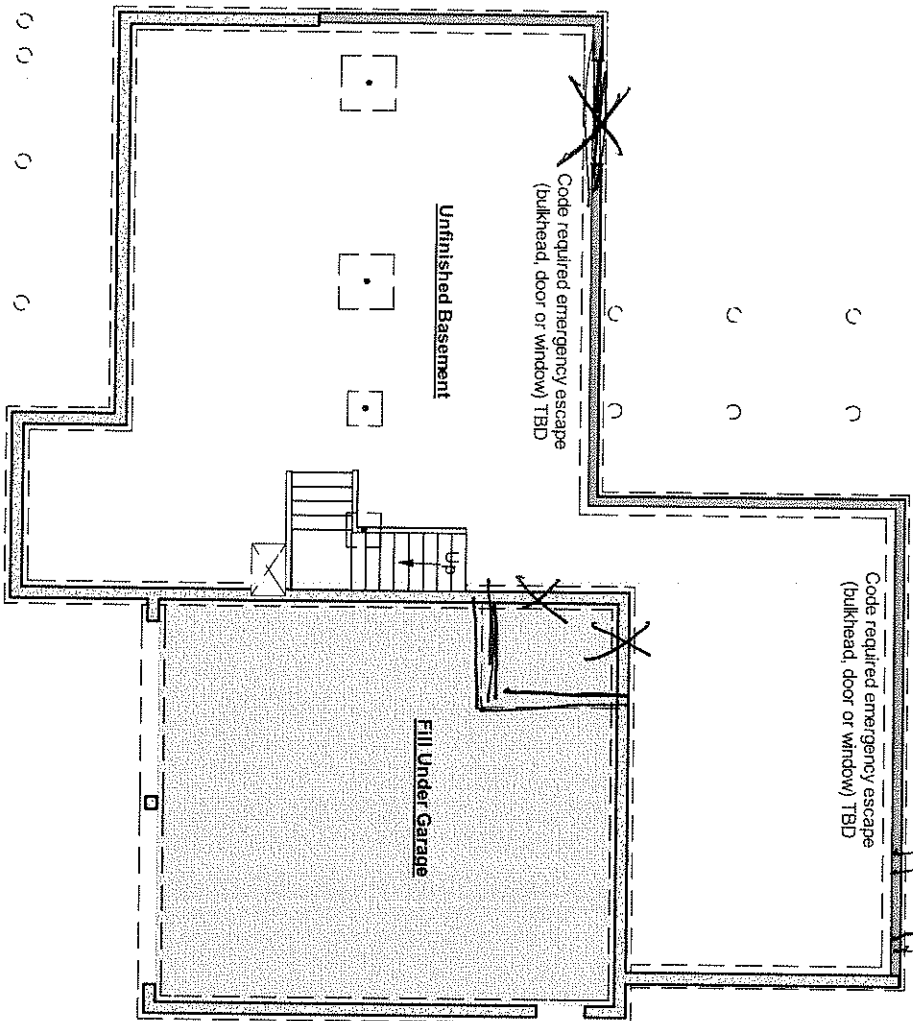

Artform Home Plans

Chinburg Builders 603-868-5995

bulkhead