

1/23/2018

Bosun Classic

400.124.v9 GL


© 2009-2018 Art Form Architecture, all rights reserved. You may not build this design without purchasing a license, even if you make changes. This design may have geographic restrictions.



603-431-9559

First Floor Plan

Scale: 1/8" = 1'-0"

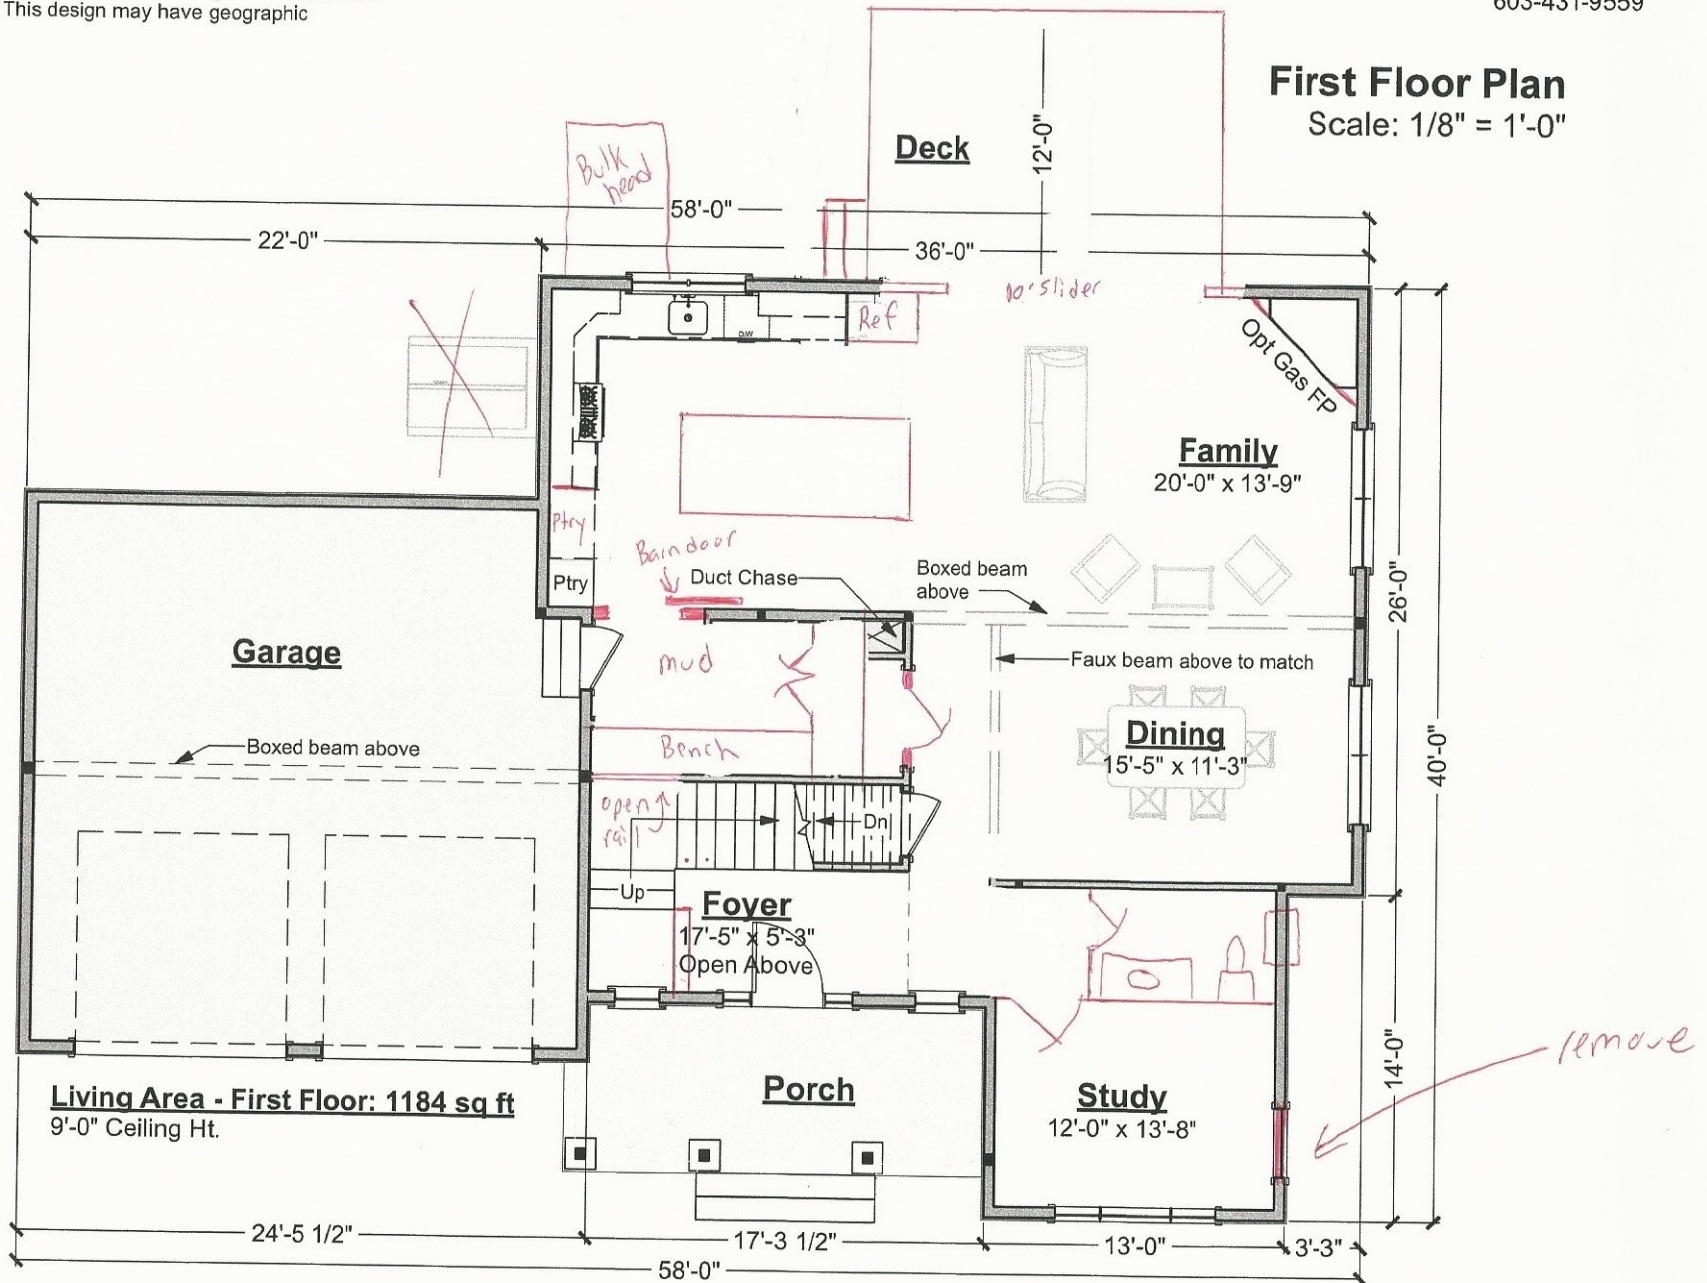

1/23/2018

Bosun Classic

400.124.v9 GL

© 2009-2018 Art Form Architecture, all rights reserved. You may not build this design without purchasing a license, even if you make changes. This design may have geographic restrictions.



603-431-9559

Second Floor Plan

Scale: 1/8" = 1'-0"

