


Brandywine
260.124.v6 KL

© 2008-2016 Art Form Architecture, all rights reserved . You may not build this design without purchasing a license, even if you make changes. This design may have geographic restrictions.

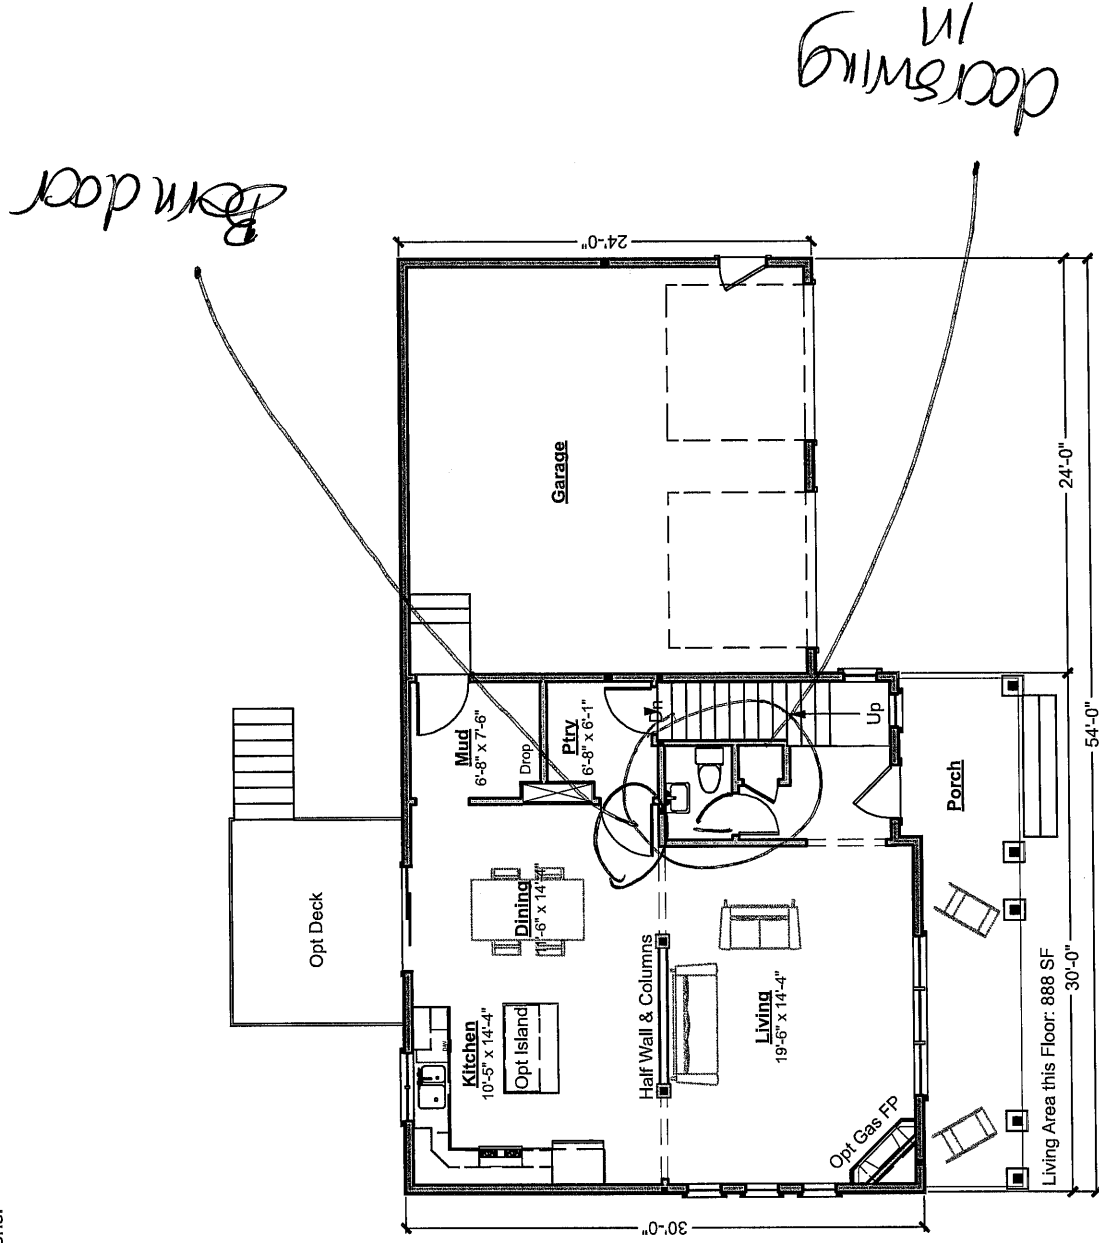


First Floor Plan

Brandywine

260.124.v6 KL

© 2008-2016 Art Form Architecture, all rights reserved. You may not build this design without purchasing a license, even if you make changes. This design may have geographic restrictions.

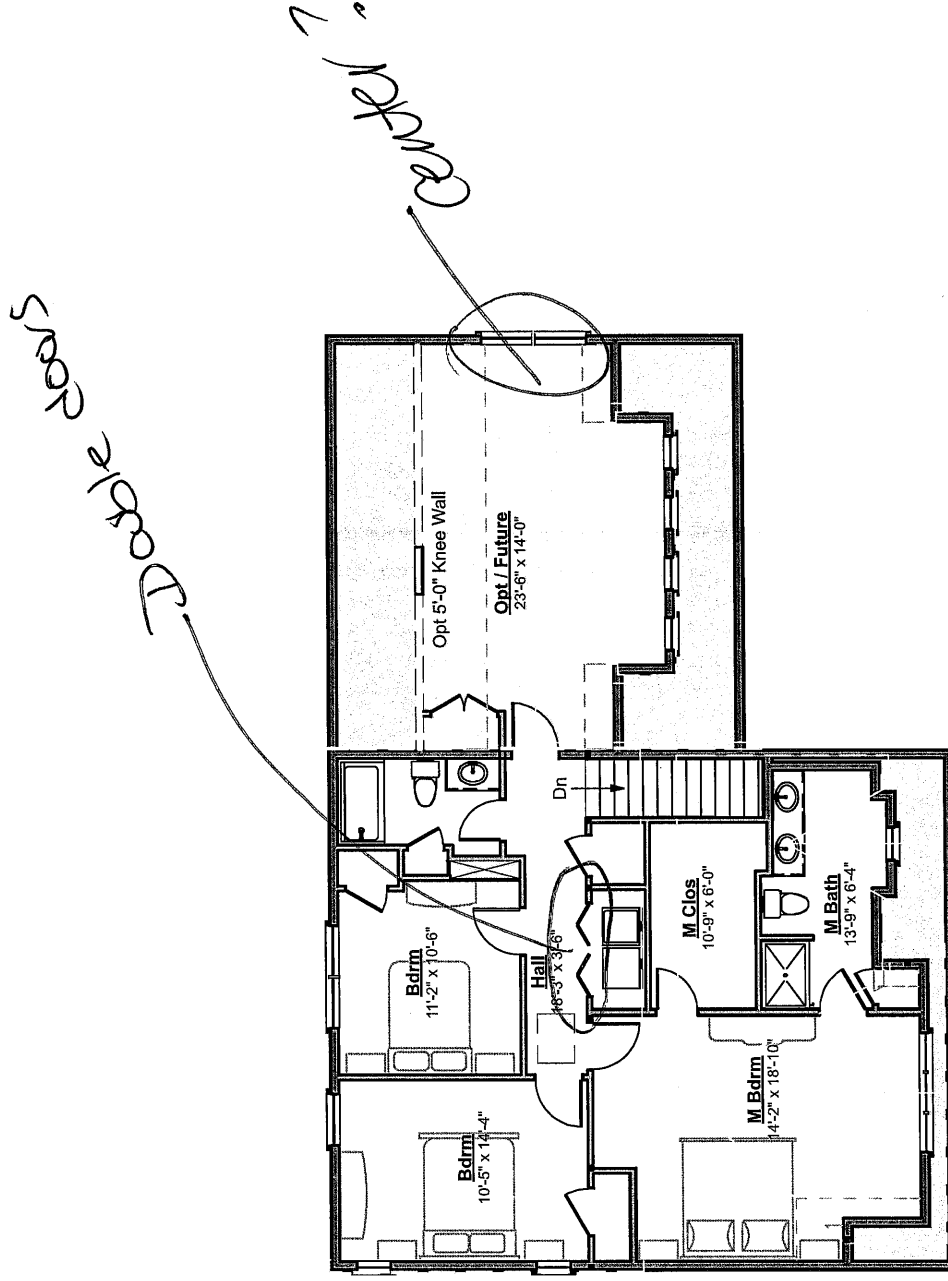

Living Area this Floor: 1323 sq ft

Second Floor Plan