

3/19/2019

Garnet Premier

384.129.v17 SR

© 2011-2019 Art Form Architecture, Inc.,
all rights reserved . You may not build
this design without purchasing a
license, even if you make changes. This
design may have geographic
restrictions.




603-431-9559

Some items shown are optional and/
or may vary. Builder's written
specifications always govern.

1. Gas fireplace and it's surround or mantel
2. Kitchen - island, cabinet style & trim, countertop material, etc.
3. Door styles and trim
4. Window grilles and trim, window treatments
5. Stair balusters or low walls at stairs
6. Lighting
7. Material selections (flooring, siding, roofing, paint colors, etc.)
8. Other furnishings
9. Landscaping, paving and walkways
10. Gutters, shutters and other exterior trim components
11. Deck size, railing style, stair location, etc.
12. Amount of exposed basement and/or wood framed walls at basement.

These images are not of any specific building site. Sun and view through windows will vary, as will the site around the house on the exterior and the slope of the land.

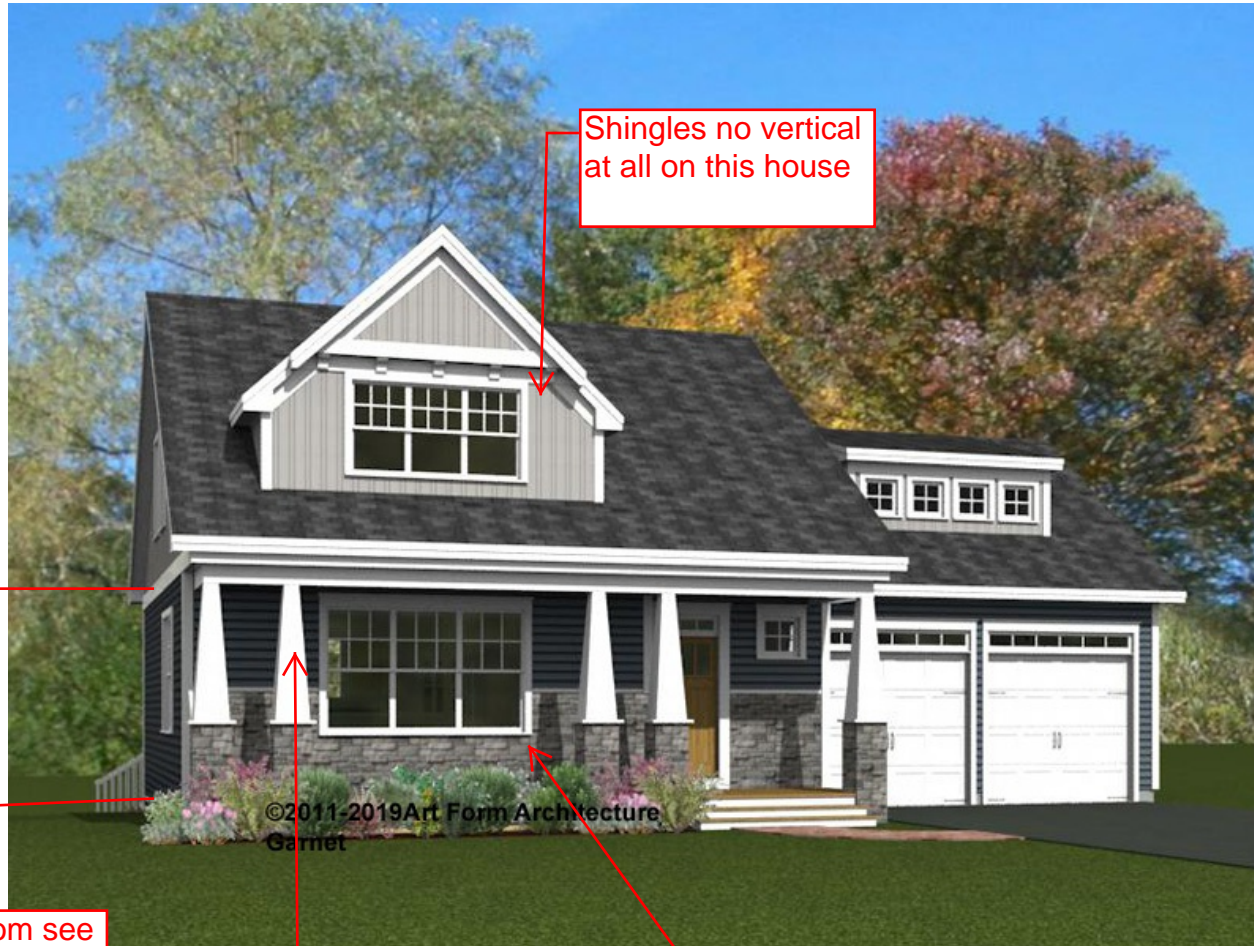

Shingles no vertical
at all on this house

add living room see
floor plan

columns 8" Square

Remove Stone

3/19/2019

Garnet Premier

384.129.v17 SR

© 2011-2019 Art Form Architecture, Inc.,
all rights reserved . You may not build
this design without purchasing a
license, even if you make changes. This
design may have geographic
restrictions.

 **Artform Home Plans**

603-431-9559



©2011-2019 Art Form Architecture
Garnet

3/19/2019

Garnet Premier

384.129.v17 SR

© 2011-2019 Art Form Architecture, Inc.,
all rights reserved . You may not build
this design without purchasing a
license, even if you make changes. This
design may have geographic
restrictions.

 **Artform Home Plans**

603-431-9559




3/19/2019

Garnet Premier

384.129.v17 SR

© 2011-2019 Art Form Architecture, Inc.,
all rights reserved. You may not build
this design without purchasing a
license, even if you make changes. This
design may have geographic
restrictions.

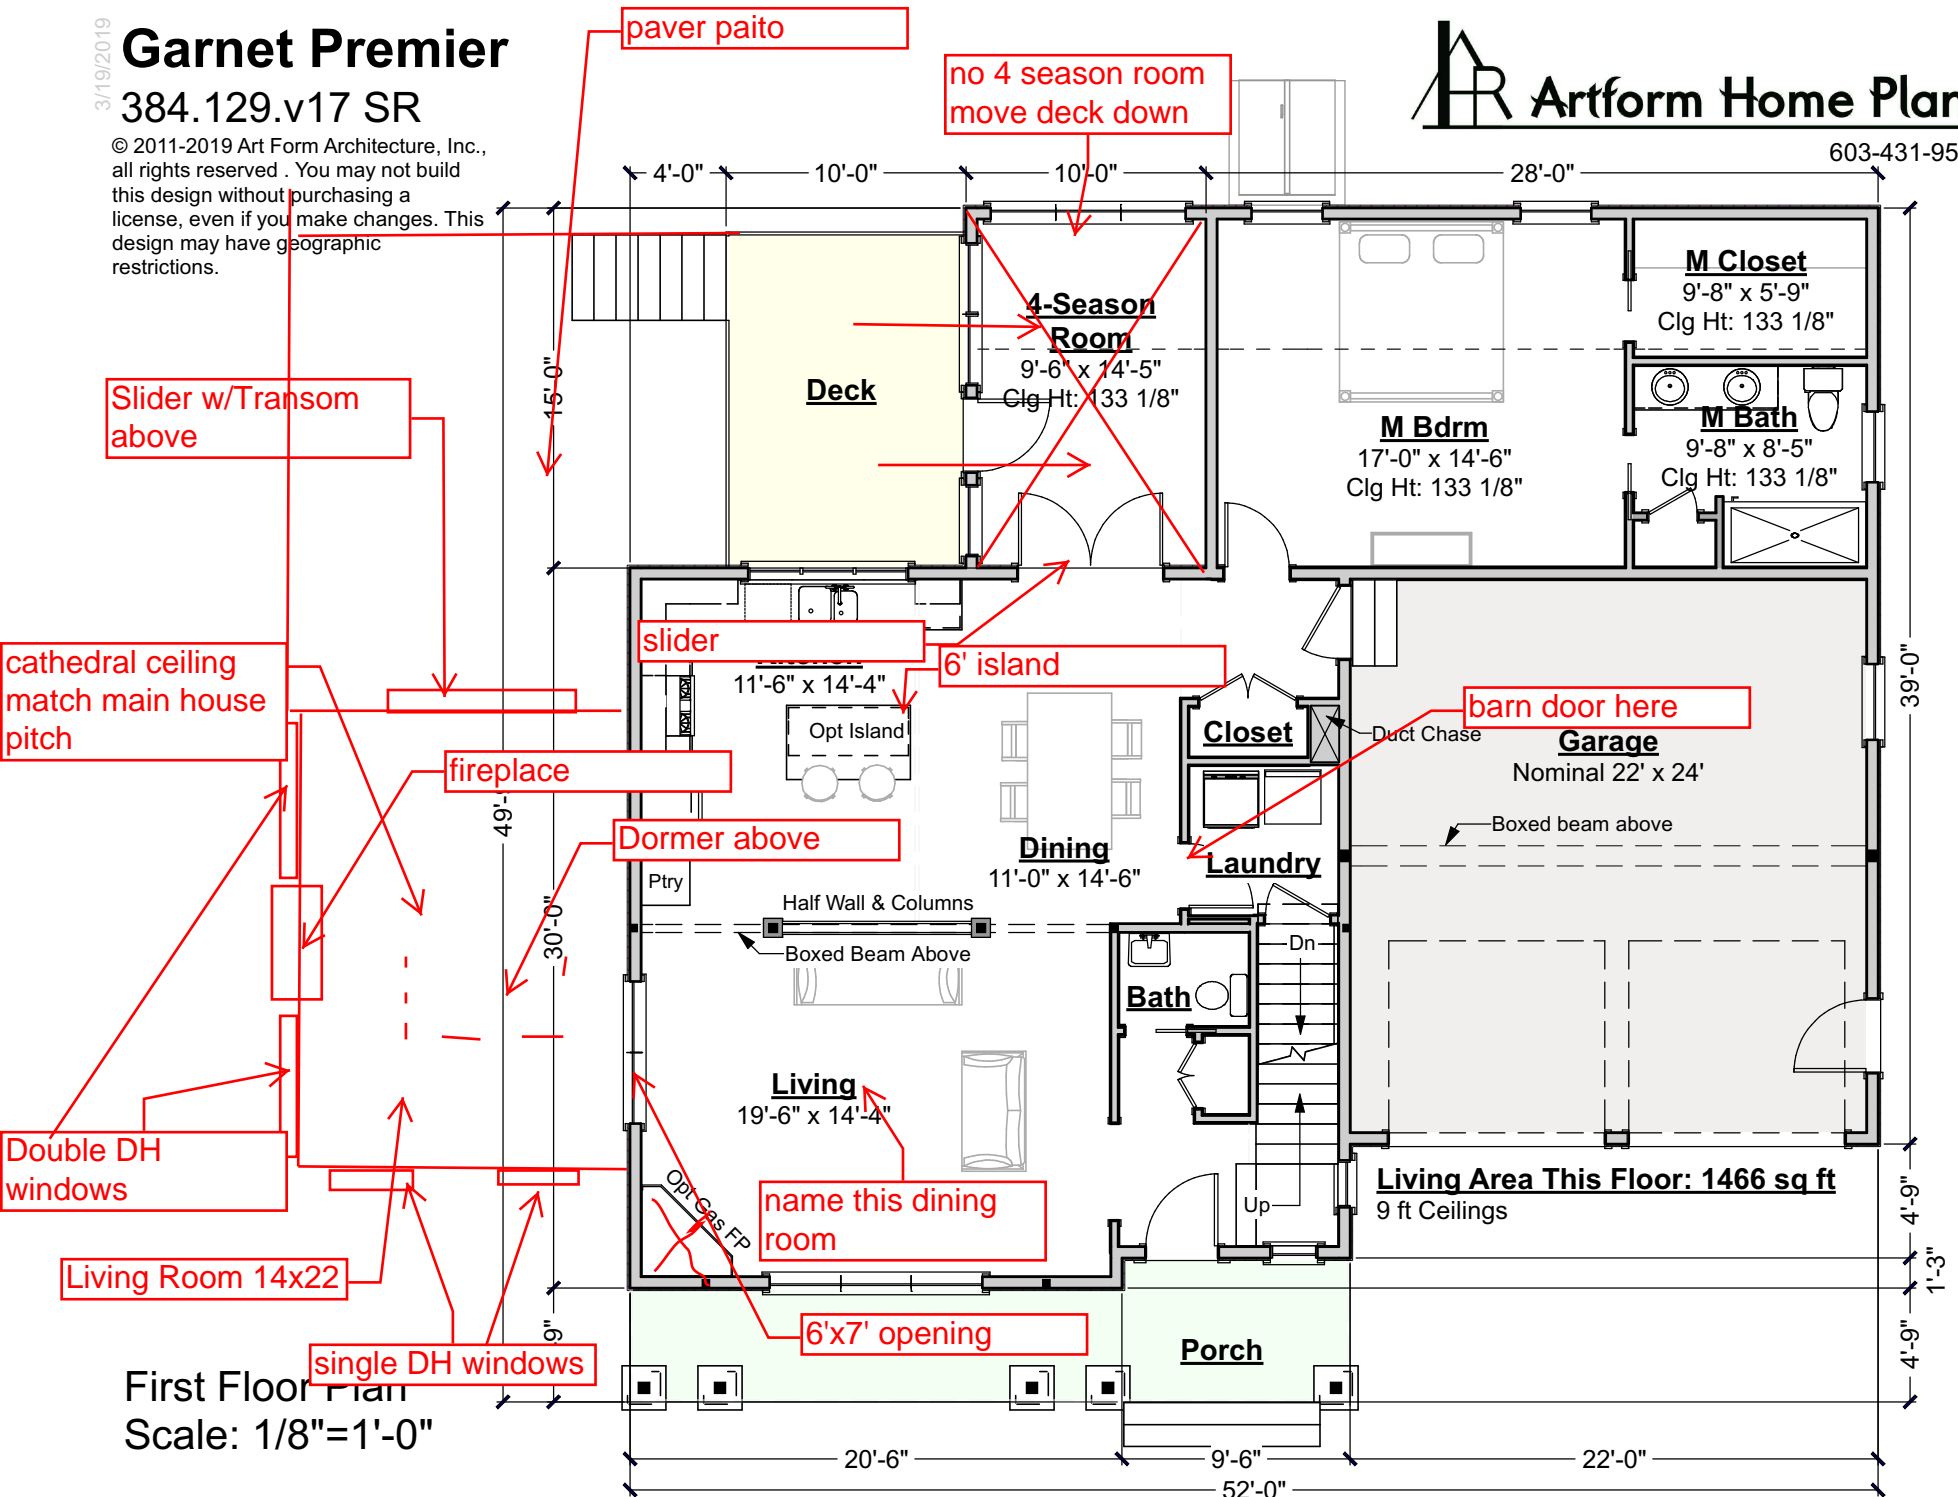

3/19/2019


Garnet Premier

384.129.v17 SR

© 2011-2019 Art Form Architecture, Inc.,
all rights reserved . You may not build
this design without purchasing a
license, even if you make changes. This
design may have geographic
restrictions.

Artform Home Plans

603-431-9559

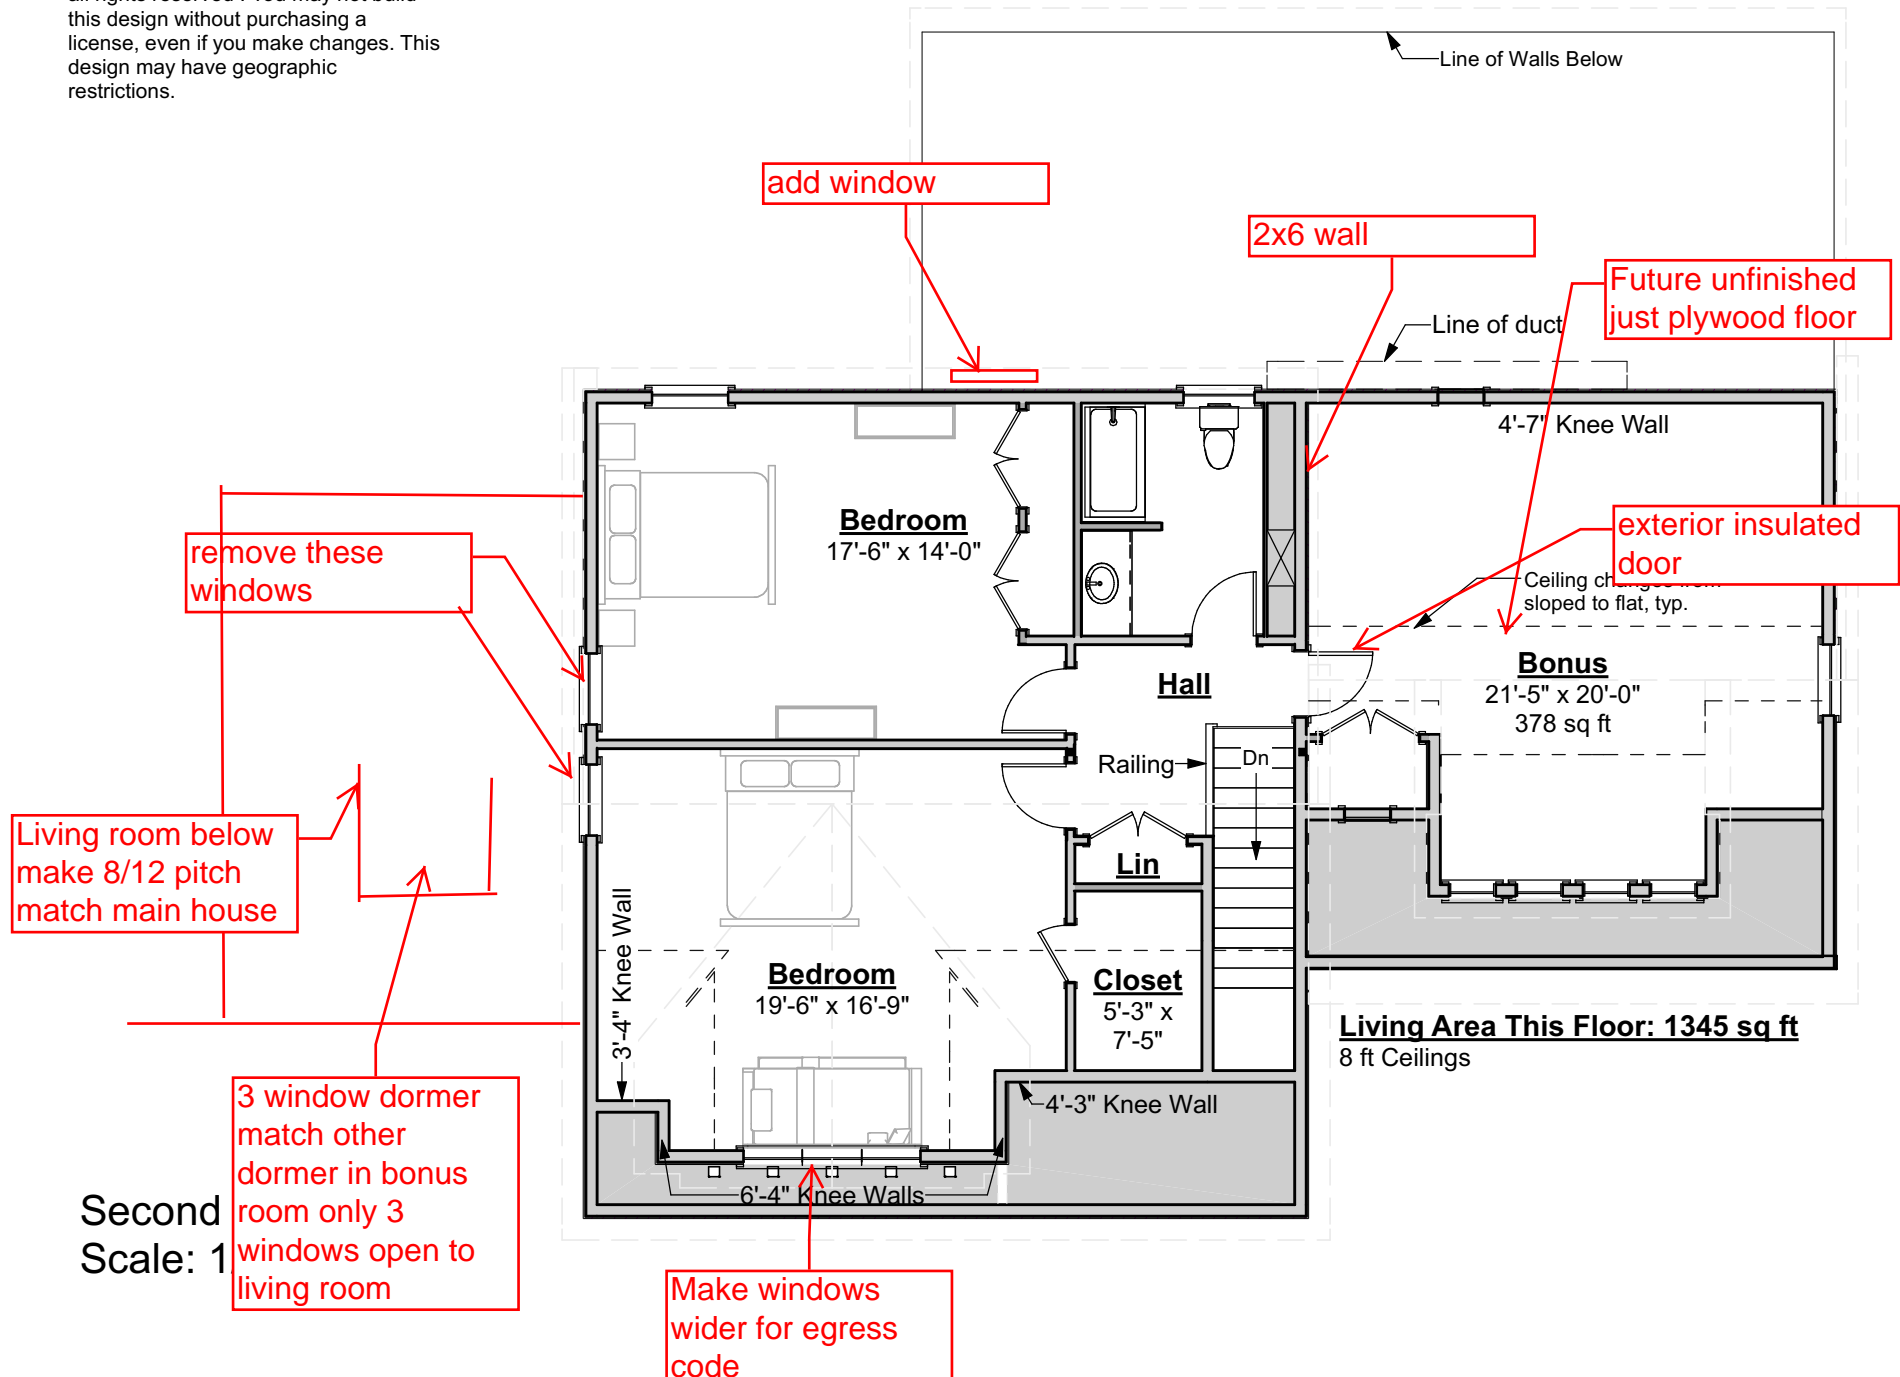

3/19/2019


Garnet Premier

384.129.v17 SR

© 2011-2019 Art Form Architecture, Inc.,
all rights reserved . You may not build
this design without purchasing a
license, even if you make changes. This
design may have geographic
restrictions.

 **Artform Home Plans**

603-431-9559

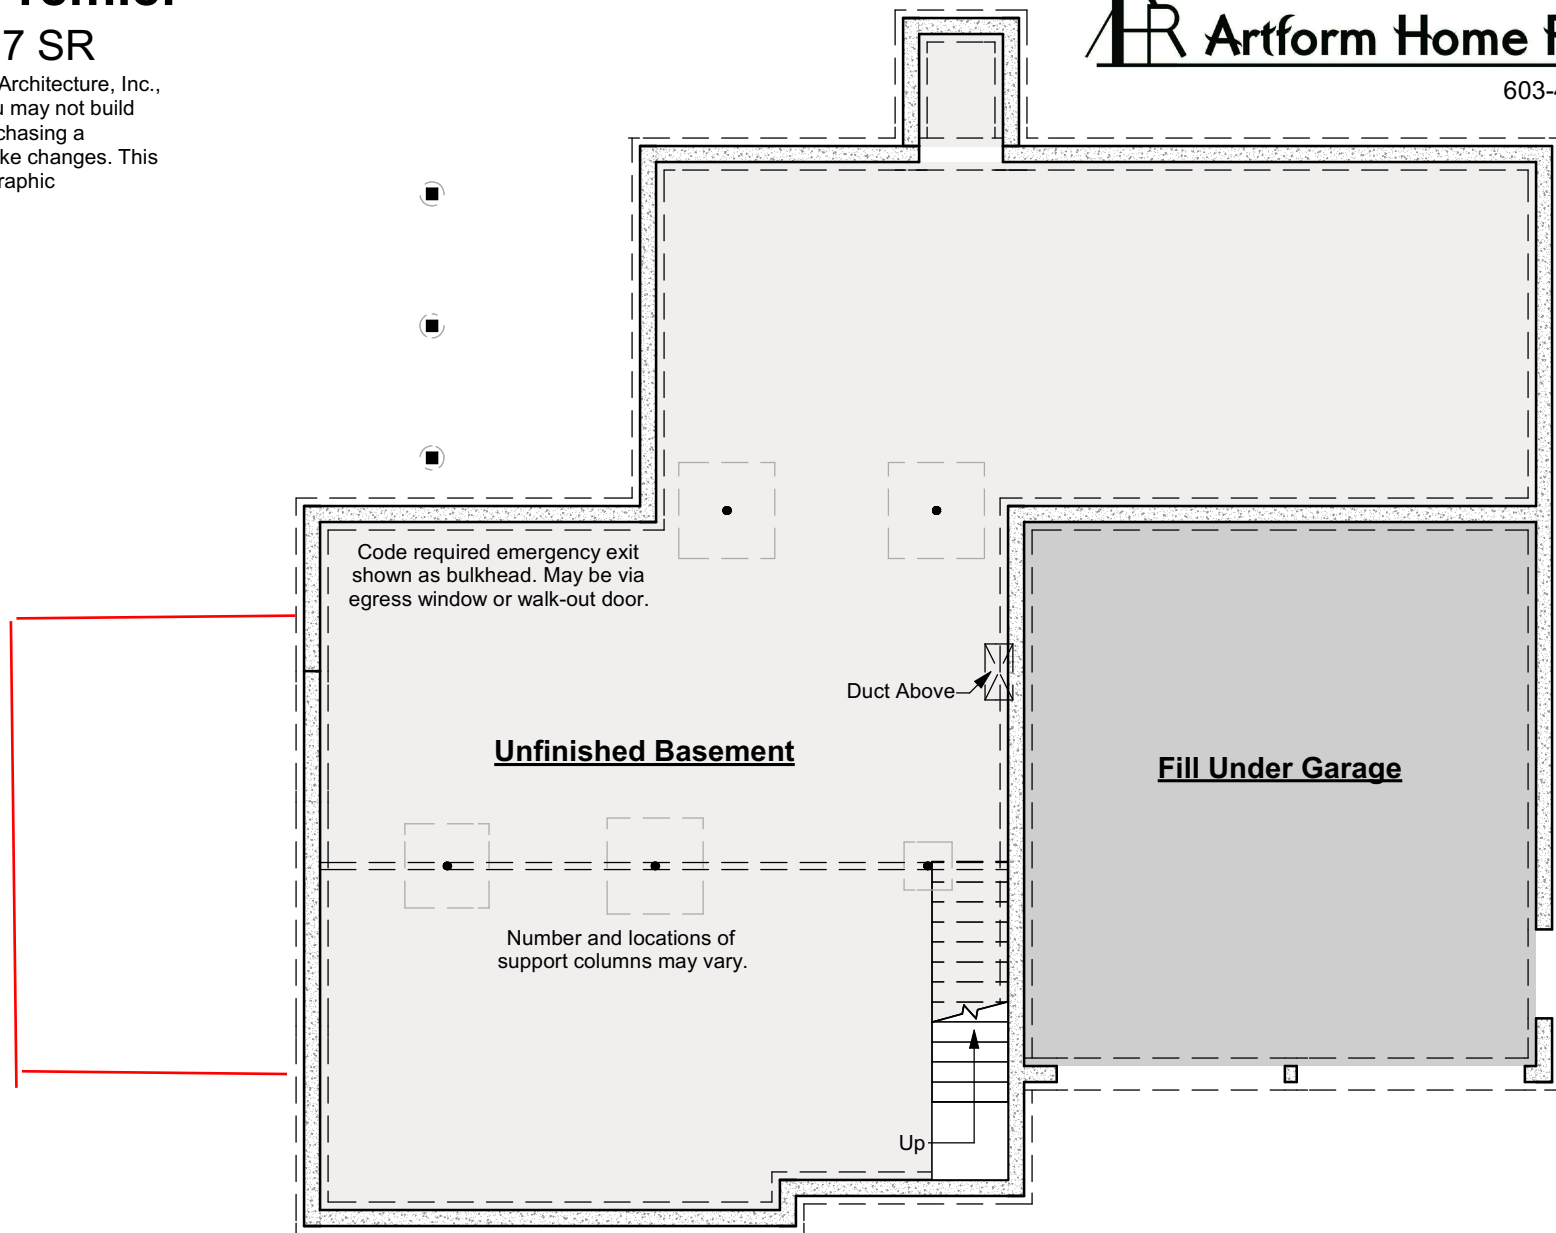

Foundation Plan
Scale: 1/8"=1'-0"

3/19/2019


Garnet Premier

384.129.v17 SR

© 2011-2019 Art Form Architecture, Inc.,
all rights reserved . You may not build
this design without purchasing a
license, even if you make changes. This
design may have geographic
restrictions.

Artform Home Plans

603-431-9559

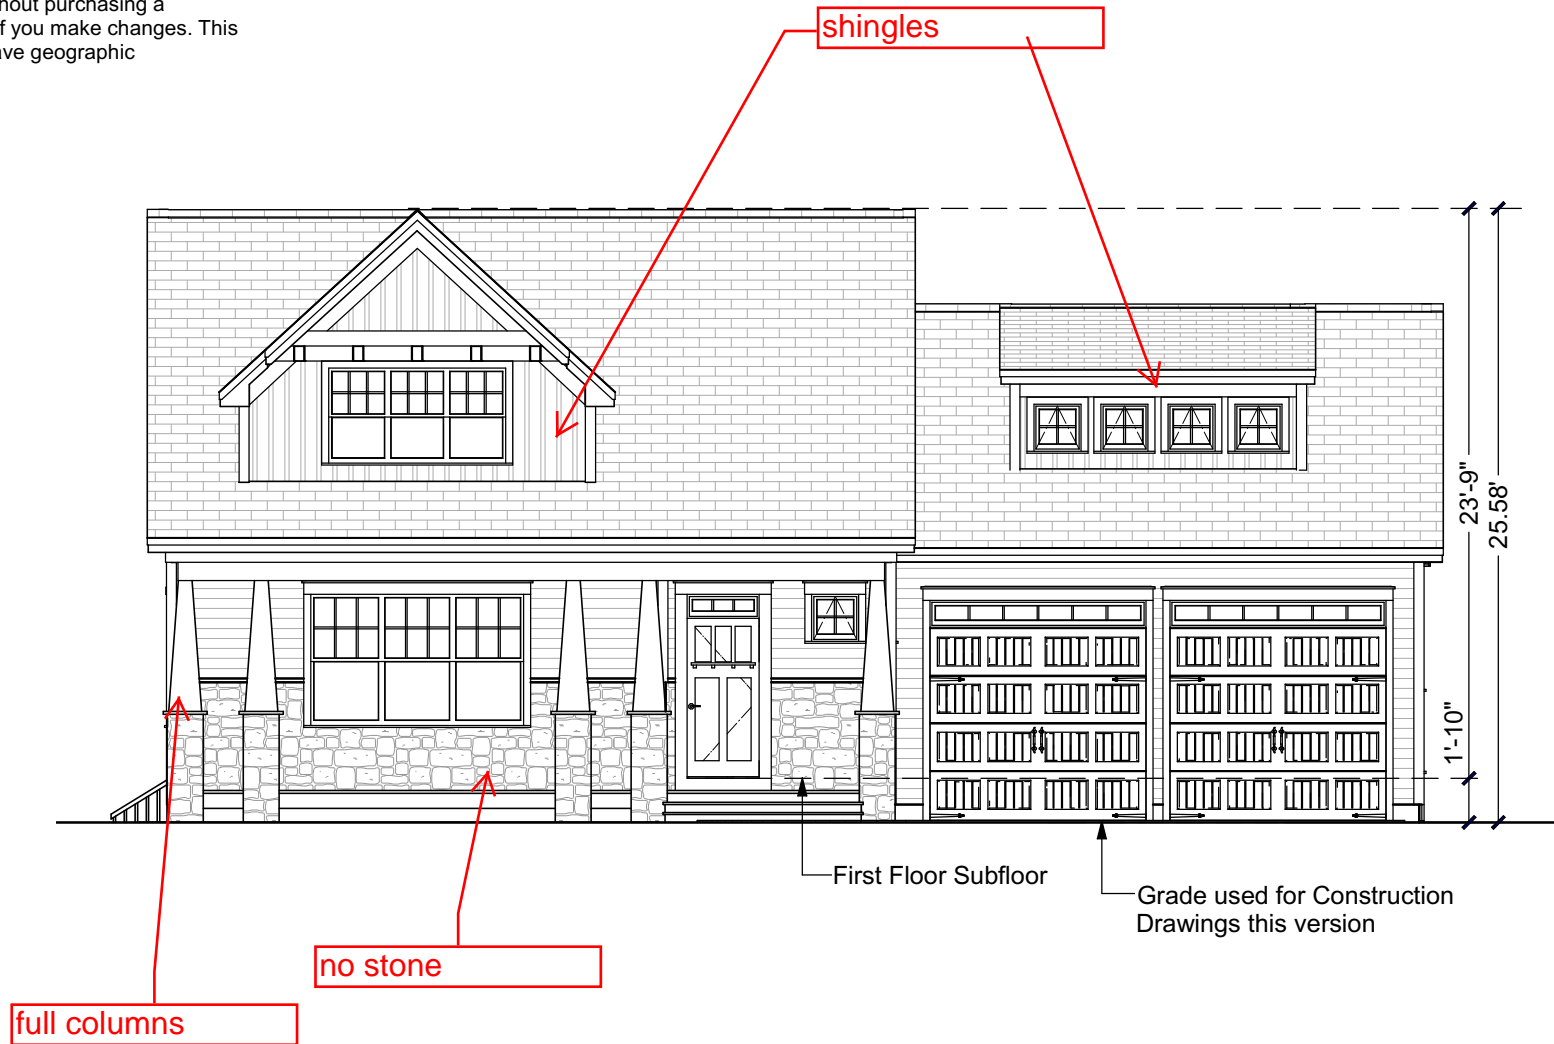

Front Elevation
Scale: 1/8"=1'-0"

3/19/2019


Garnet Premier

384.129.v17 SR

© 2011-2019 Art Form Architecture, Inc.,
all rights reserved . You may not build
this design without purchasing a
license, even if you make changes. This
design may have geographic
restrictions.

Artform Home Plans

603-431-9559

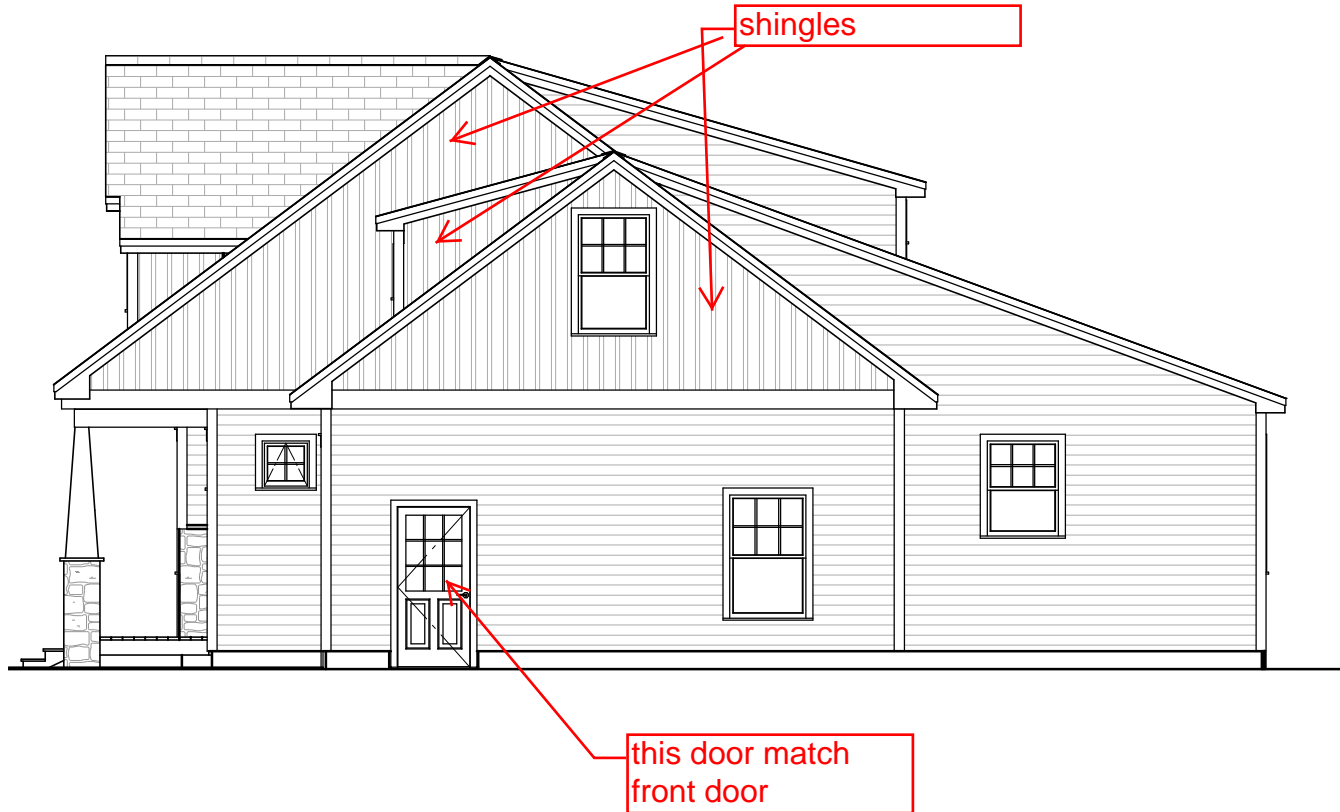

Right Elevation
Scale: 1/8"=1'-0"

3/19/2019

Garnet Premier

384.129.v17 SR

© 2011-2019 Art Form Architecture, Inc.,
all rights reserved . You may not build
this design without purchasing a
license, even if you make changes. This
design may have geographic
restrictions.

 **Artform Home Plans**

603-431-9559



Rear Elevation
Scale: 1/8"=1'-0"

3/19/2019


Garnet Premier

384.129.v17 SR

© 2011-2019 Art Form Architecture, Inc.,
all rights reserved . You may not build
this design without purchasing a
license, even if you make changes. This
design may have geographic
restrictions.

 **Artform Home Plans**

603-431-9559

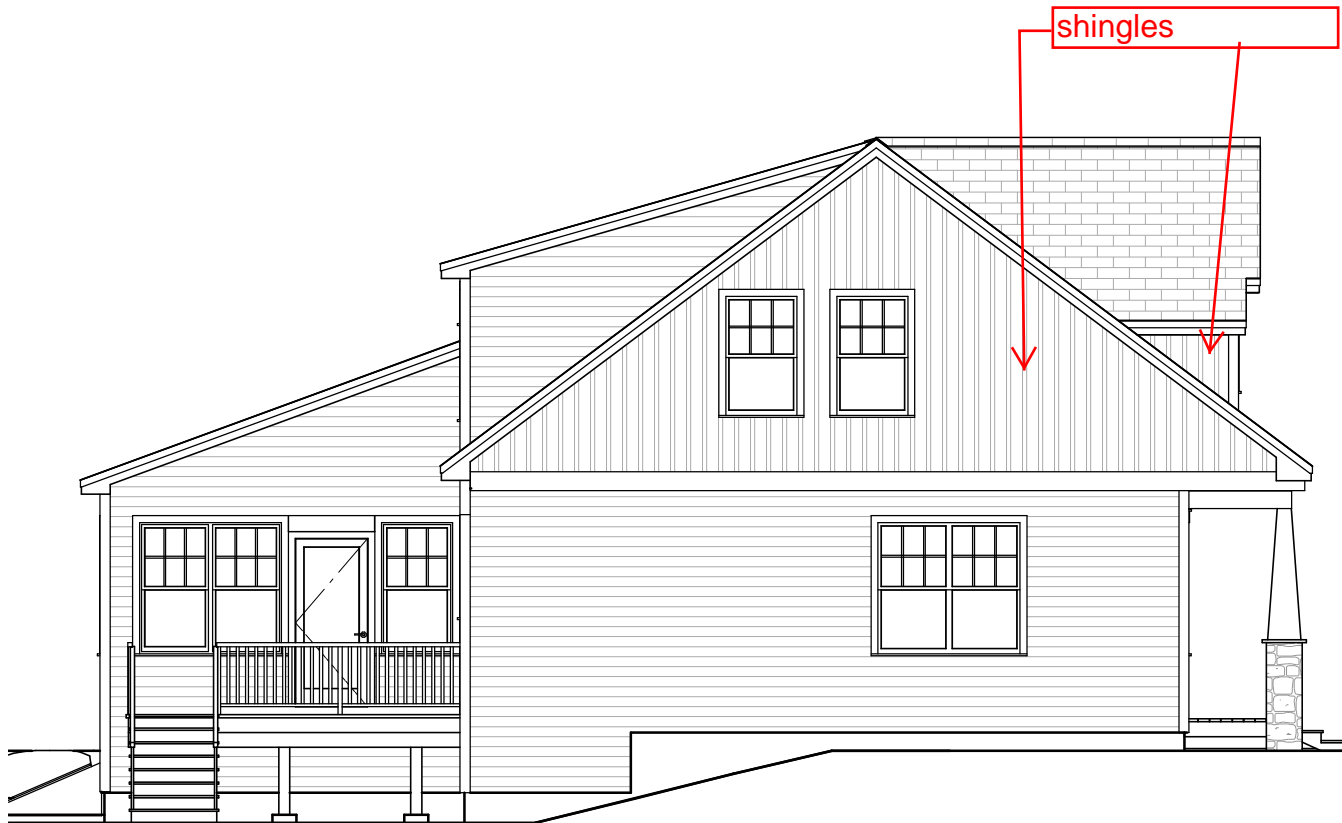

Left Elevation
Scale: 1/8"=1'-0"