

Alexander Compact
449.124.v31 GR (9/21/2021)

©2011- 2021 Art Form Architecture, Inc., all rights reserved . You may not build this design without purchasing a license, even if you make changes. This design may have geographic restrictions.




Artform Home Plans

603-431-9559

First Floor Plan

Scale: $1/8" = 1'-0"$

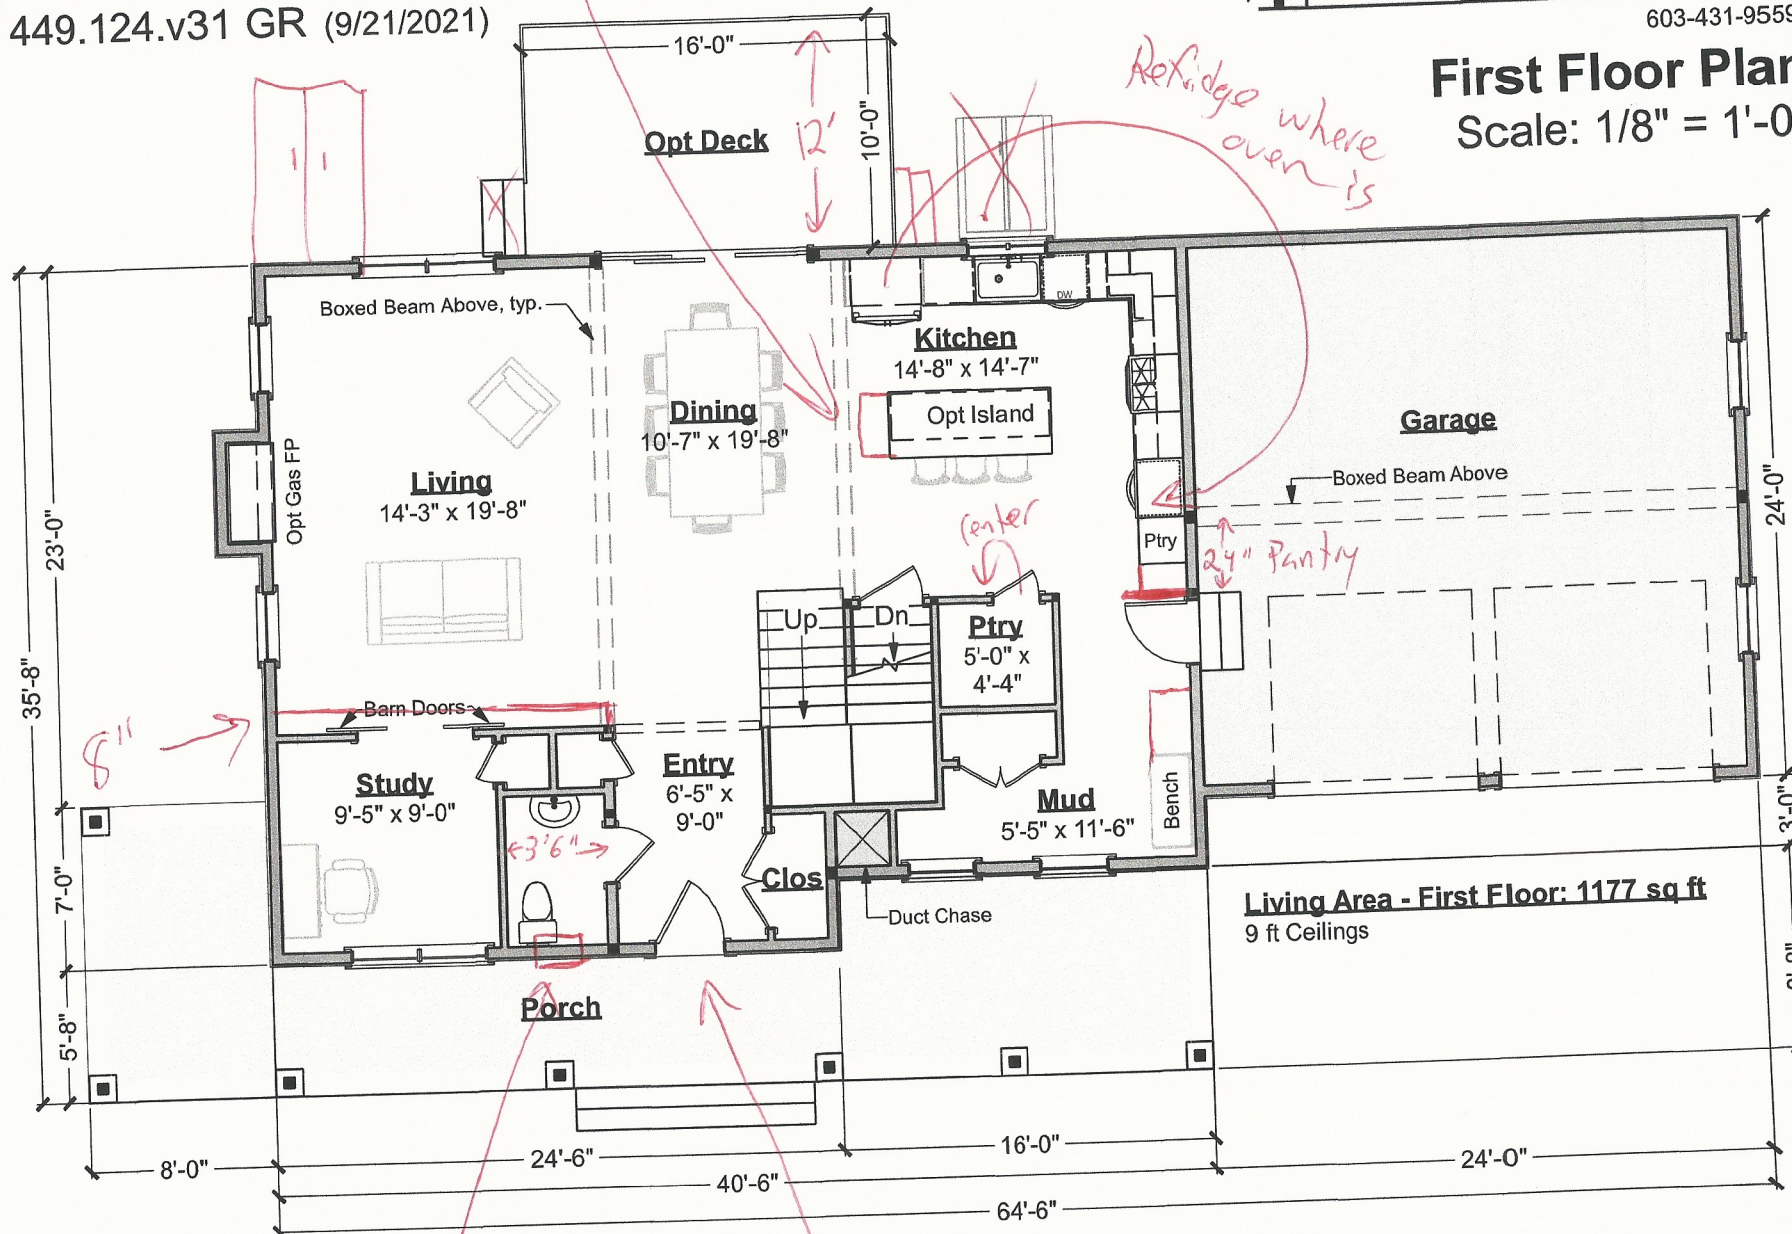

Window

no + ransom

9/21/2021

Alexander Compact

449.124.v31 GR (9/21/2021)

©2011- 2021 Art Form Architecture, Inc., all rights reserved . You may not build this design without purchasing a license, even if you make changes. This design may have geographic restrictions.



Artform Home Plans

603-431-9559

Second Floor Plan

Scale: 1/8" = 1'-0"

