

Wall Types

Exterior walls 2x6 wood stud
Interior walls 2x4 wood stud, unless noted otherwise

Mail Keys

- 2x wood studs on the flat
- 2x3 wood stud wall, 16" oc
- 2x6 wood stud wall, 16" oc

Note: 2x4 wood stud wall, 16" oc unless otherwise noted

Key Notes

- 30" x 22" Minimum AWC Access Panel - Insulated (R10 R4 x R5)
- Field locale for plumbing or mechanical
- Verify size of fixture or appliance
- Adjust dimensions to accommodate
- Shug - Door or Window trim will be snug and may need to be cut down
- Center - Place door or window centered on wall
- Double Stud or structural wall - adapt to load requirements
- Object is to have some "bite" for curtain hardware and exterior aesthetics.

Smoke Detector

Carbon Monoxide Detector

Dimensions

Dimensions are to face of stud, unless noted otherwise. Closures are 24" clear inside, unless dimensioned otherwise.

Square Footages



- 1. Sq. ft numbers are interior to room for use in calculating finishes.
- 2. Cabinets and fixtures not subtracted.
- 3. Add for doorways when floor finishes run through.

Notes

- 1. Exterior walls 2x6 wood stud @ 16" oc. Provide insulation & vapor barrier conforming to state or local codes. Interior sheathing 1/2" gypsum board. Provide 1/2" exterior rated sheathing, houses wrap with drainage plane and siding. Provide snap flashing at walls adjacent to roof planes.
- 2. Interior walls 2x4 wood stud @ 16" oc, unless noted otherwise.
- 3. Roof - see structural for rafter sizes. Provide 5/8" exterior rated roof sheathing, 15# roofing felt, ice & water shield at eaves and valleys, aluminum drip edge and asphalt shingles or metal roofing. Structure not calculated for added chimneys.
- 4. Provide roof and/or ceiling insulation per code. Provide vapor barrier and insulation per code. Verify with code officer - e-cased call spray foam or energy pack cellulose installed at rafters and filling ridge and eaves generally contra-indicates venting, batt insulation always requires venting.
- 5. Provide smoke detectors where shown, where required by code and where required by local authorities.
- 6. Provide fire resistant materials where required by code, including but not limited to, firestopping at penetrations, 1/2" drywall on walls and 5/8" drywall on ceilings to separate adjacent (where garage present in design) from dwelling, and provide fire rated doors and windows at garage openings, and present in design), and protection of farmable insulation
- 7. Confirm bottom of window coping relative to frame. Adjust head heights as required to conform to IRC 2009 R612.2, or provide code approved guards.
- 8. Compliance with code requirements for egress size and clearances, (railway widths, room sizes, etc) assume 1/2" drywall on walls and 1/2" drywall on 3/4" stepping on ceilings. Adjust as required if materials differ.
- 9. Some windows must be installed with a head height greater or lesser than the standard 80" or 72" 1/2" to provide clearance at kitchen counters, to meet code sill height or to install 2x40 header height to double top track, frame window RO light to header.

14-Shear is only called out where Continuous Portal Frame is used. See Station Model 10/4 (Pages 173 - 179) of the IRC 2009.

Caleb Classic With Wings

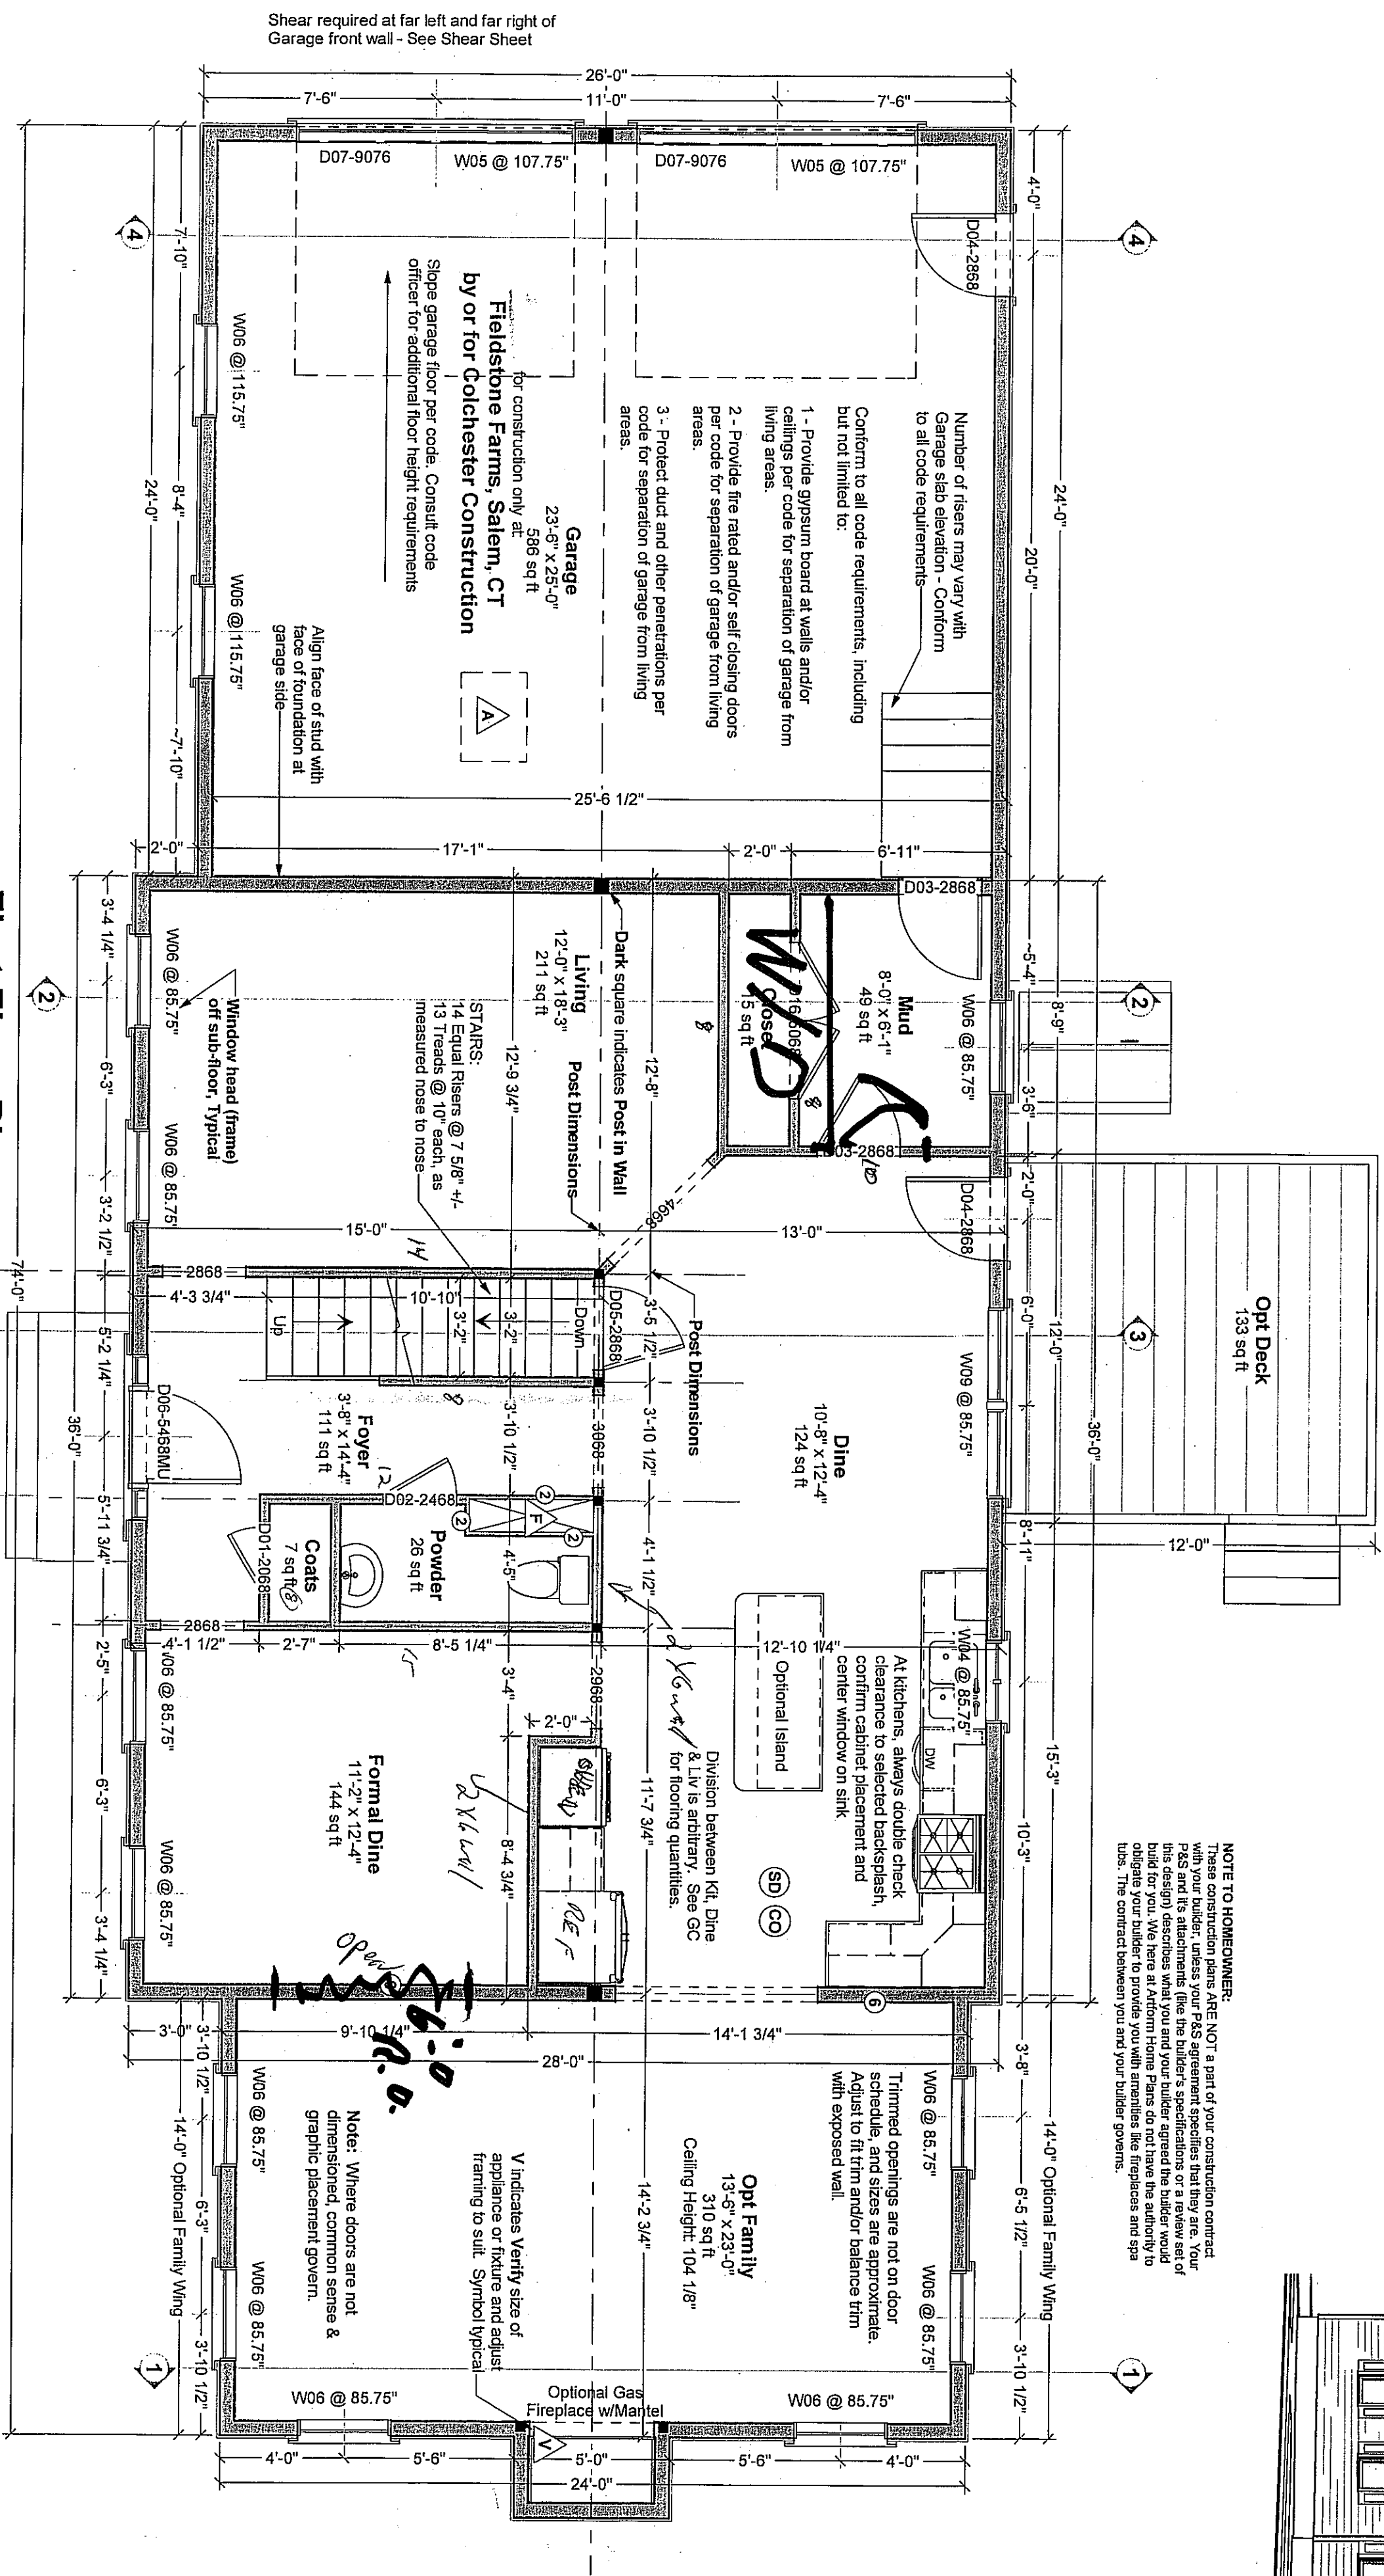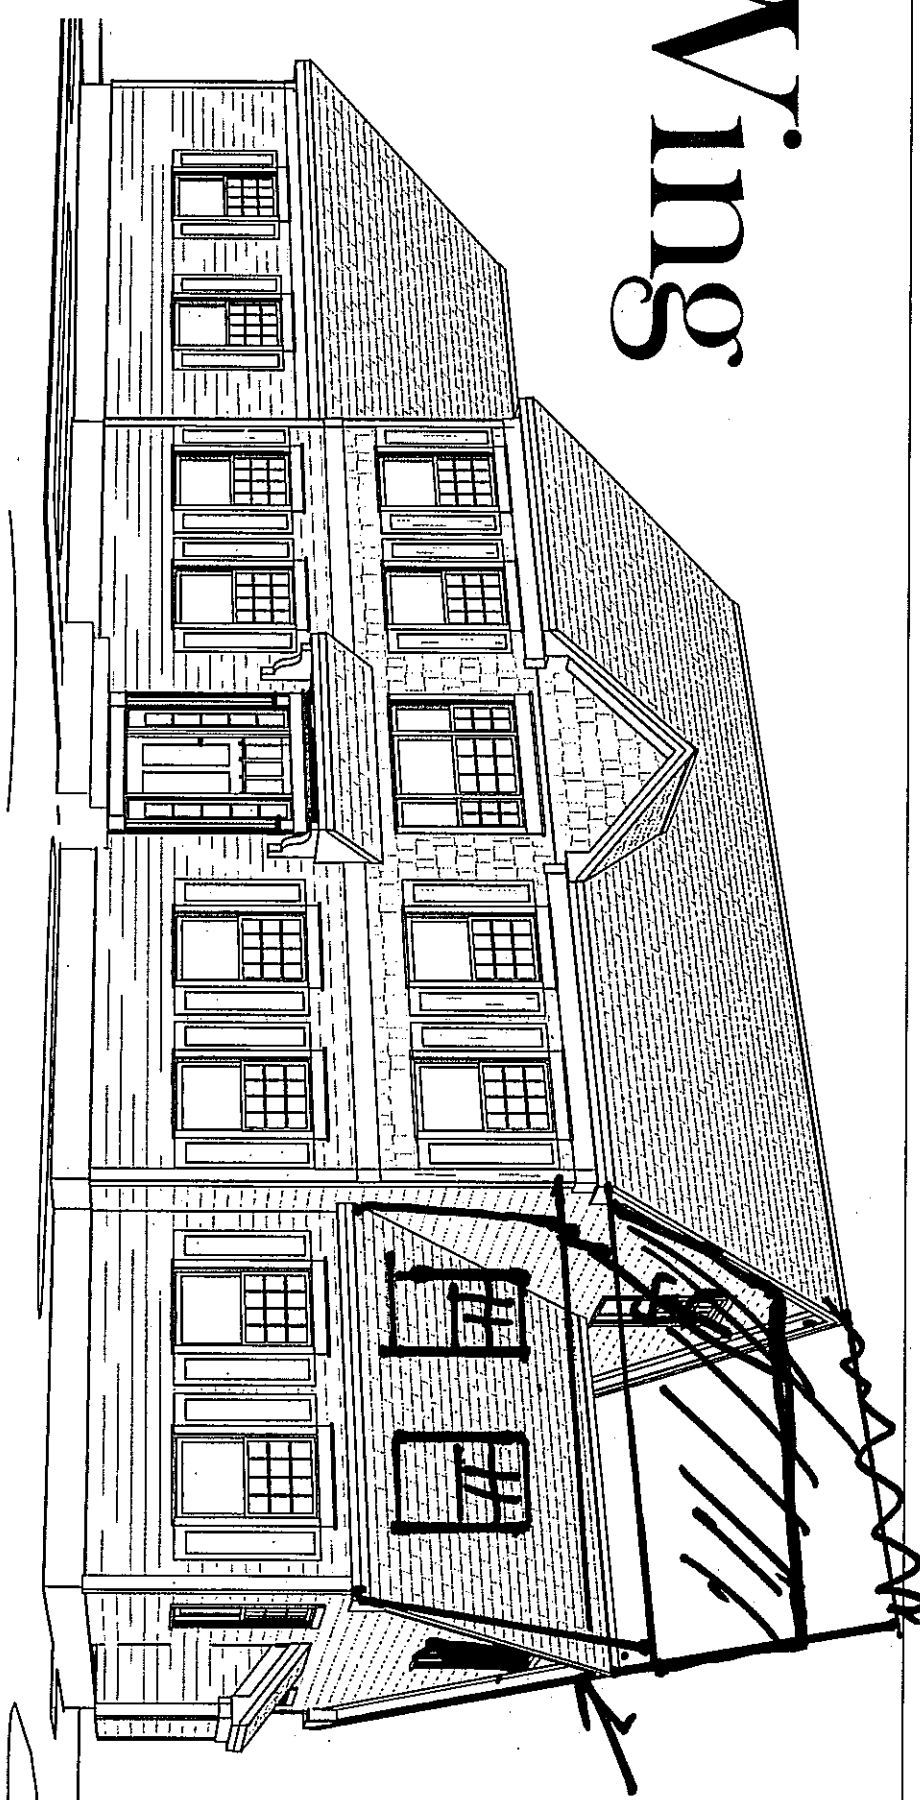

First Floor Plan

NUMBER	QTY	RECOR	SIZE	DOOR SCHEDULE	COMMENTS


- 1. Rated Doors: Provide fire rated and/or self-closing doors where required by local codes or local authorities
- 2. Trimmed Openings: Trimmed openings not shown on schedule. See Plan.
- 3. Window Tempering: Provide tempered windows where required by local codes or local authorities. Tempering column provided here for convenience. Windows have not been reviewed for tempering requirements.
- 4. Window RO's: 14" or 12" on each of 4 sides allowed for window RO's, typical. Review framing size as RO size. Adjust per manufacturer's requirements and/or builder preference.
- 5. Egress Windows: Provide minimum one door or window meeting egress requirements in basement, in accordance with local codes. Note that egress windows must be installed with specific hardware. Egress requirements typically need to be obtained with specific hardware. Emergency Escape Window Sizes (Section R310.1.1, R310.1.2, R310.1.3 and R310.1.4) will also comply with NFPA 101.
- 6. Basement Windows: Add basement windows as required to meet state or local code requirements, including but not limited to egress and light/ventilation.
- 7. Skylights: Skylights are not shown on this schedule, but may be required. Consult builder and/or sea floor plan.
- 8. Minimum window sill height: IRC 2009 and later requires that upper floor window sills be 24" from floor. Where 60" high windows are used, install with window heads @ 64 1/2" or more.

NOTE TO HOMEOWNER:


Dear Code Officer



1. Room Size (Section R304)
2. Floor Space & Ceiling Height at Toilet, Bath and Shower Spaces (Section R307)
3. Stairways (Section R311.1.1)



Dear Everybody,
With these drawings a copyright license is granted for a single construction only at Fieldstone Farms, Salem, CT by or for Colchester Construction. This is a License to Build, and does not include a license to copy, reproduce, or otherwise use these drawings for any other purpose. 

Use of these drawings outside these parameters is a violation of federal copyright law, punishable by both civil action and criminal prosecution. It is the responsibility of the user to ensure that the drawings are used only for the construction of the building shown. 

You use of these drawings constitutes an acceptance of responsibility for the drawings and on our web site: http://www.aftormhomeplans.com/online_print.php

If you have any concerns or questions, please feel free to contact us at: info@aftormhomeplans.com

Aftorm Home Plans
Caleb Classic With Wing
Salem, CT
1

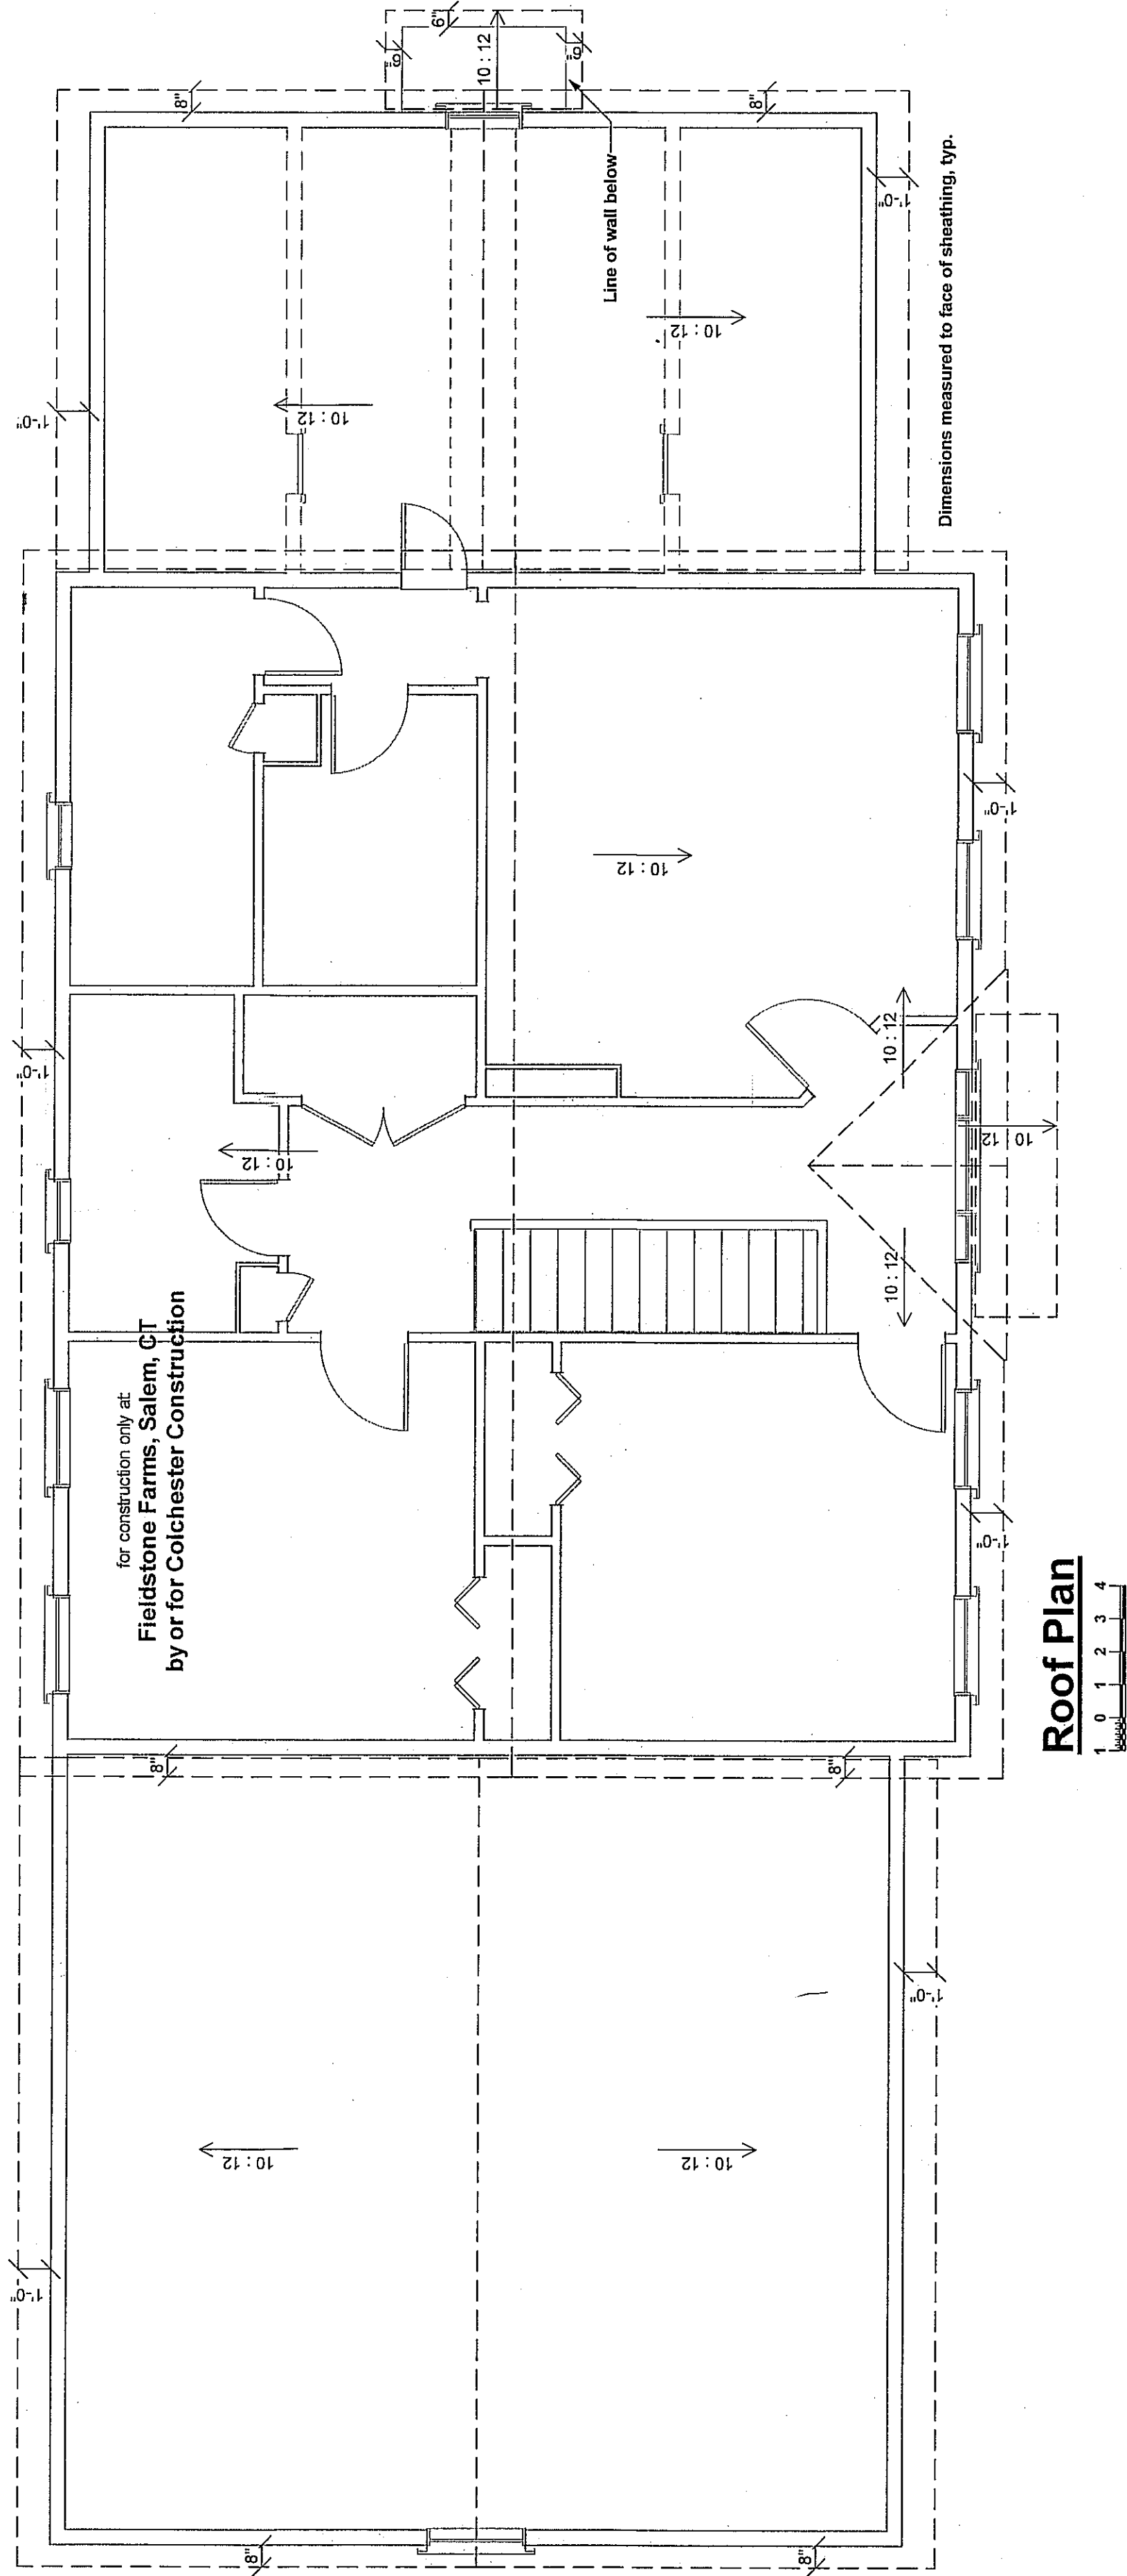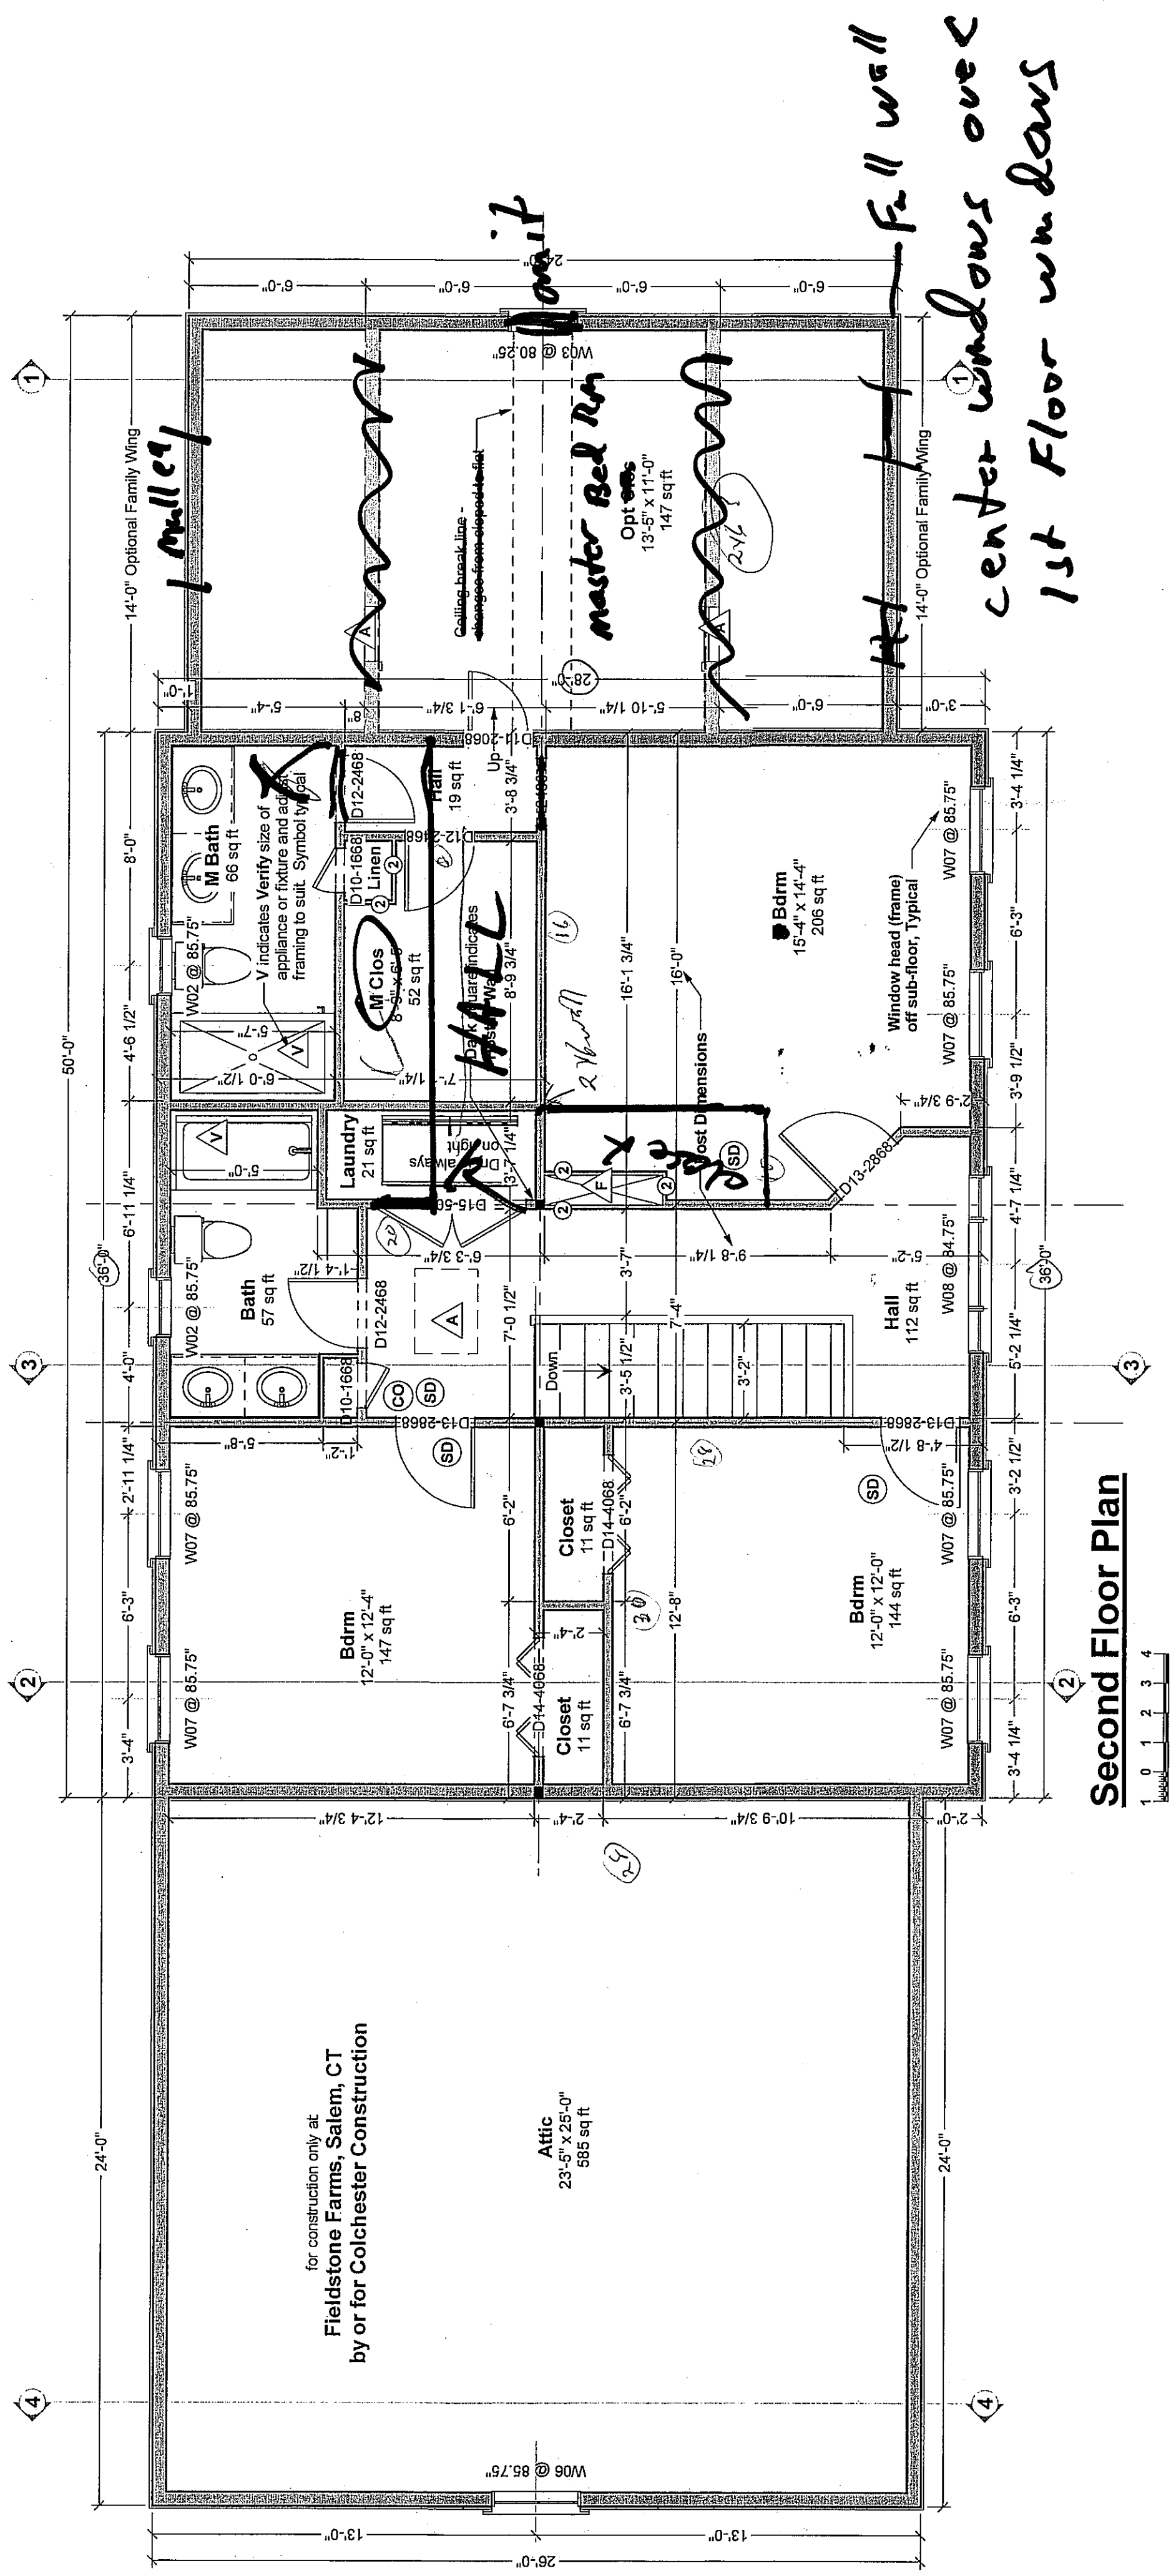

Your use of these drawings constitutes an acceptance of responsibility as outlined in "Dear Code Officer" on the first page of these drawings, and on our web site:
http://www.artformhomeplans.com/line_print.php

If you have any concerns or questions, please feel free to contact us. We are happy to clarify matters that fall within our scope, as listed on the first page. We can also often provide affordable support for issues that are your responsibility, such as energy design/calcs, or additional detailing.

Artform Home Plans

1/4"=1'-0" unless noted otherwise / Print @ 1:1 PDF created on 9/11/2013, drawn by ACJ	Issued for: Construction
© 2008-2010 Wendy Wallon 503.431.9559 AL-HP Design # S91.127.V1 KR	2
Caleb Classic With Wing Fieldstone Farms Salem, CT	