



STRAIGHT POSTS on TOP
NOT ANGLED


windows
4 over
1

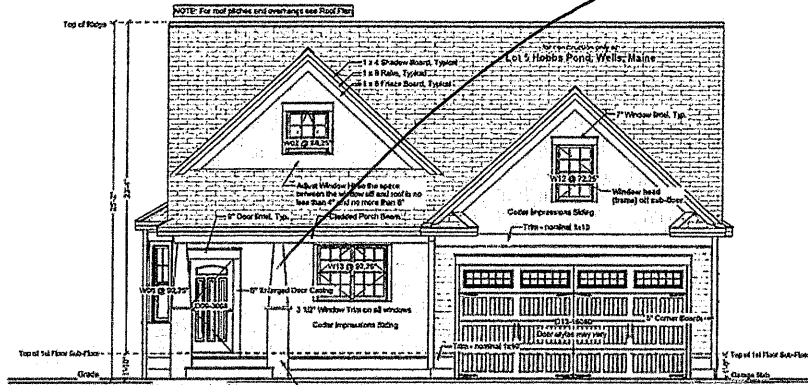


Front Elevation

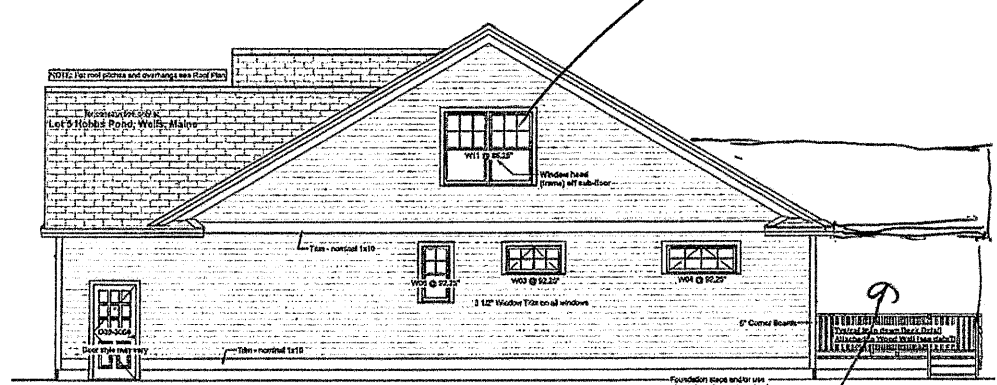


Right Elevation

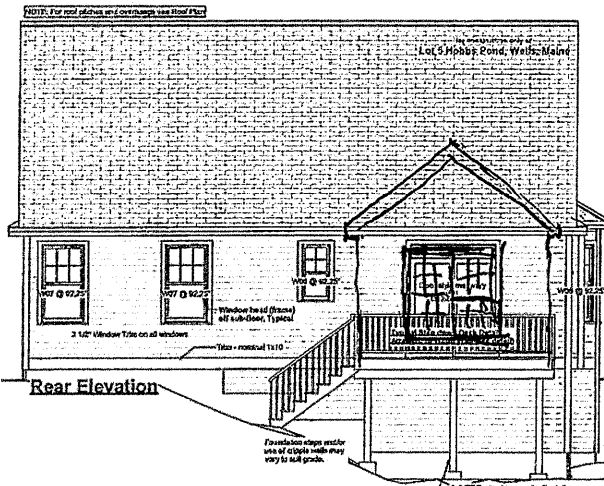

Rear Elevation

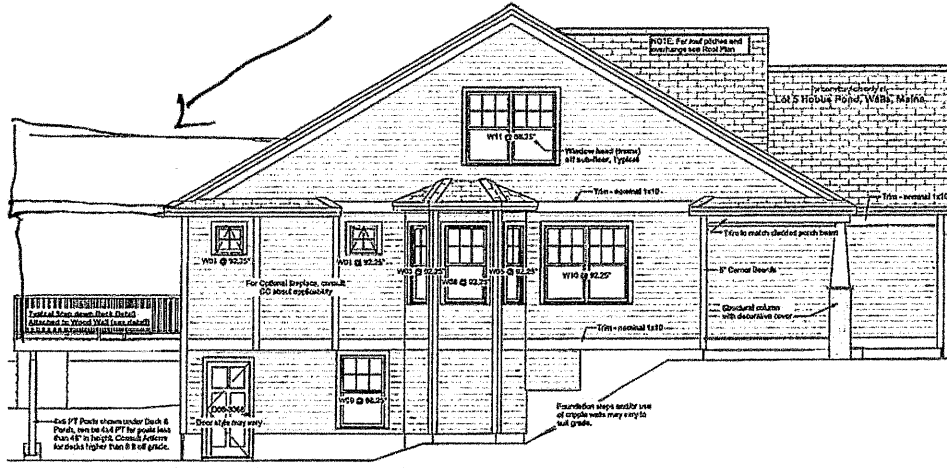

Left Elevation

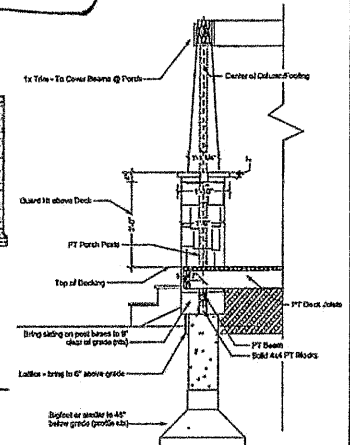

Craftsman Column Detail


From Column Center = 8" to Edge of (10"x17") Decking, 7" to Edge of Deck Framing.

Your use of these drawings constitutes an acceptance of responsibility on the part of the "Draw Code Owner" on the first page of these drawings, and on the last page.

If you have any questions or concerns, please feel free to contact us. We are happy to clarify matters that fall within our scope, as listed on the last page. We can also often provide additional support for issues that are your responsibility, such as energy calculations, or additional building.

Artform Home Plans	

XC
DS
9/27

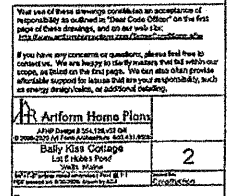

3