

Modified Bonnie Ranch

679.124.v29 GR

© 2014-2019 Art Form Architecture, Inc., all rights reserved.
You may not build this design without purchasing a license,
even if you make changes. This design may have geographic
restrictions.

Artform Home Plans

803-431-9559


CM
09/01/20
5:30 PM EDT
SM
09/01/20
7:12 PM EDT

Buyers want deck,
no patio.

No Screen Porch

Patio instead of Deck

change
swing

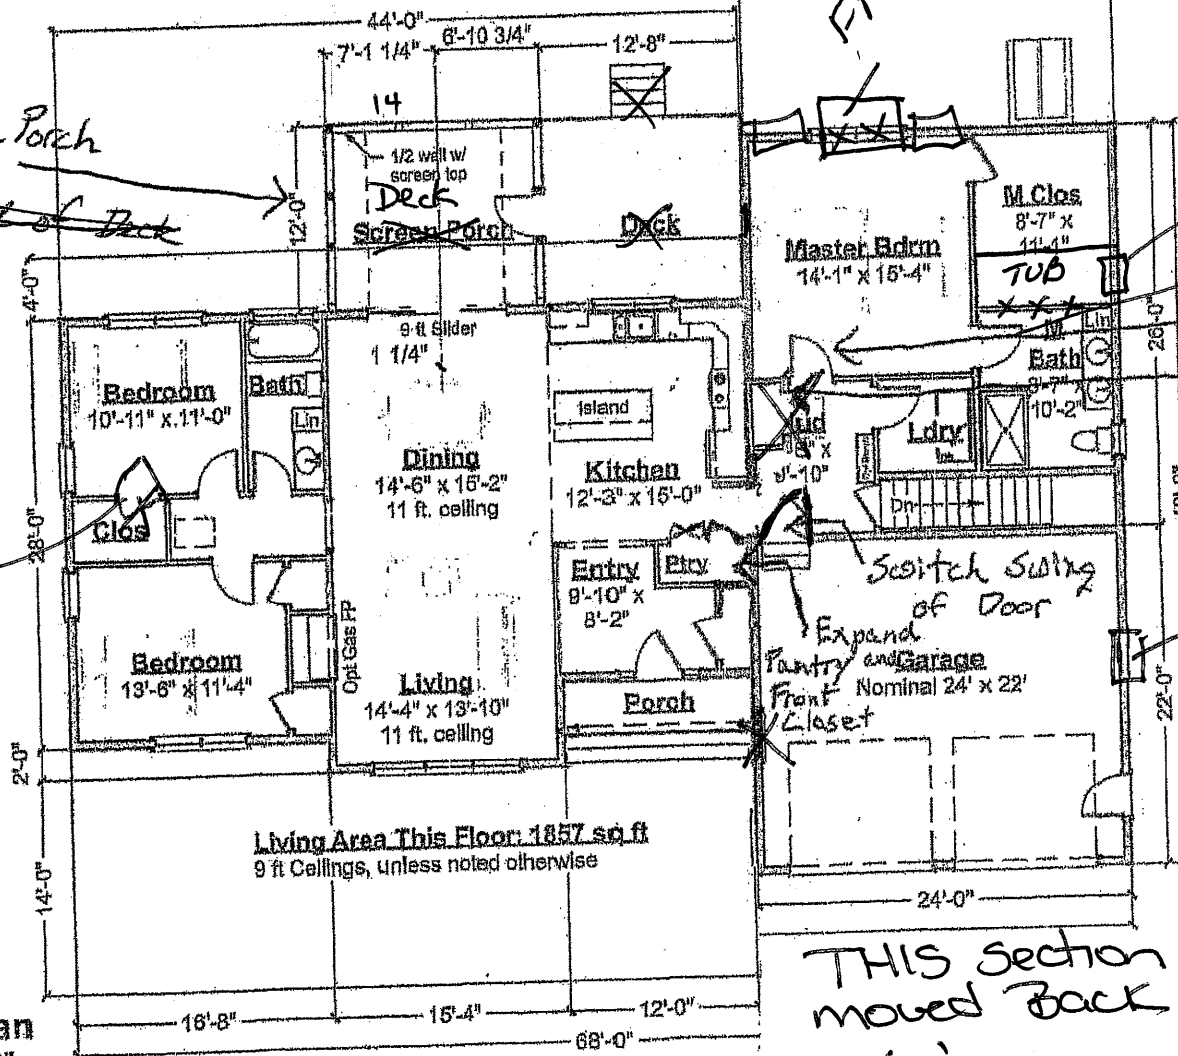

First Floor Plan
Scale: 3/32" = 1'-0"