

Sasha

719.144.v20 GR (7/20/2020)

© 2015-2020 Art Form Architecture, Inc., all rights reserved . You may not build this design without purchasing a license, even if you make changes. This design may have geographic restrictions.

 **Artform Home Plans**
603-431-9559



Front Elevation


Scale: 1/8" = 1'-0"

Sasha

719.144.v20 GR (7/20/2020)

© 2015-2020 Art Form Architecture, Inc., all rights reserved. You may not build this design without purchasing a license, even if you make changes. This design may have geographic restrictions.

Artform Home Plans
603-431-9559

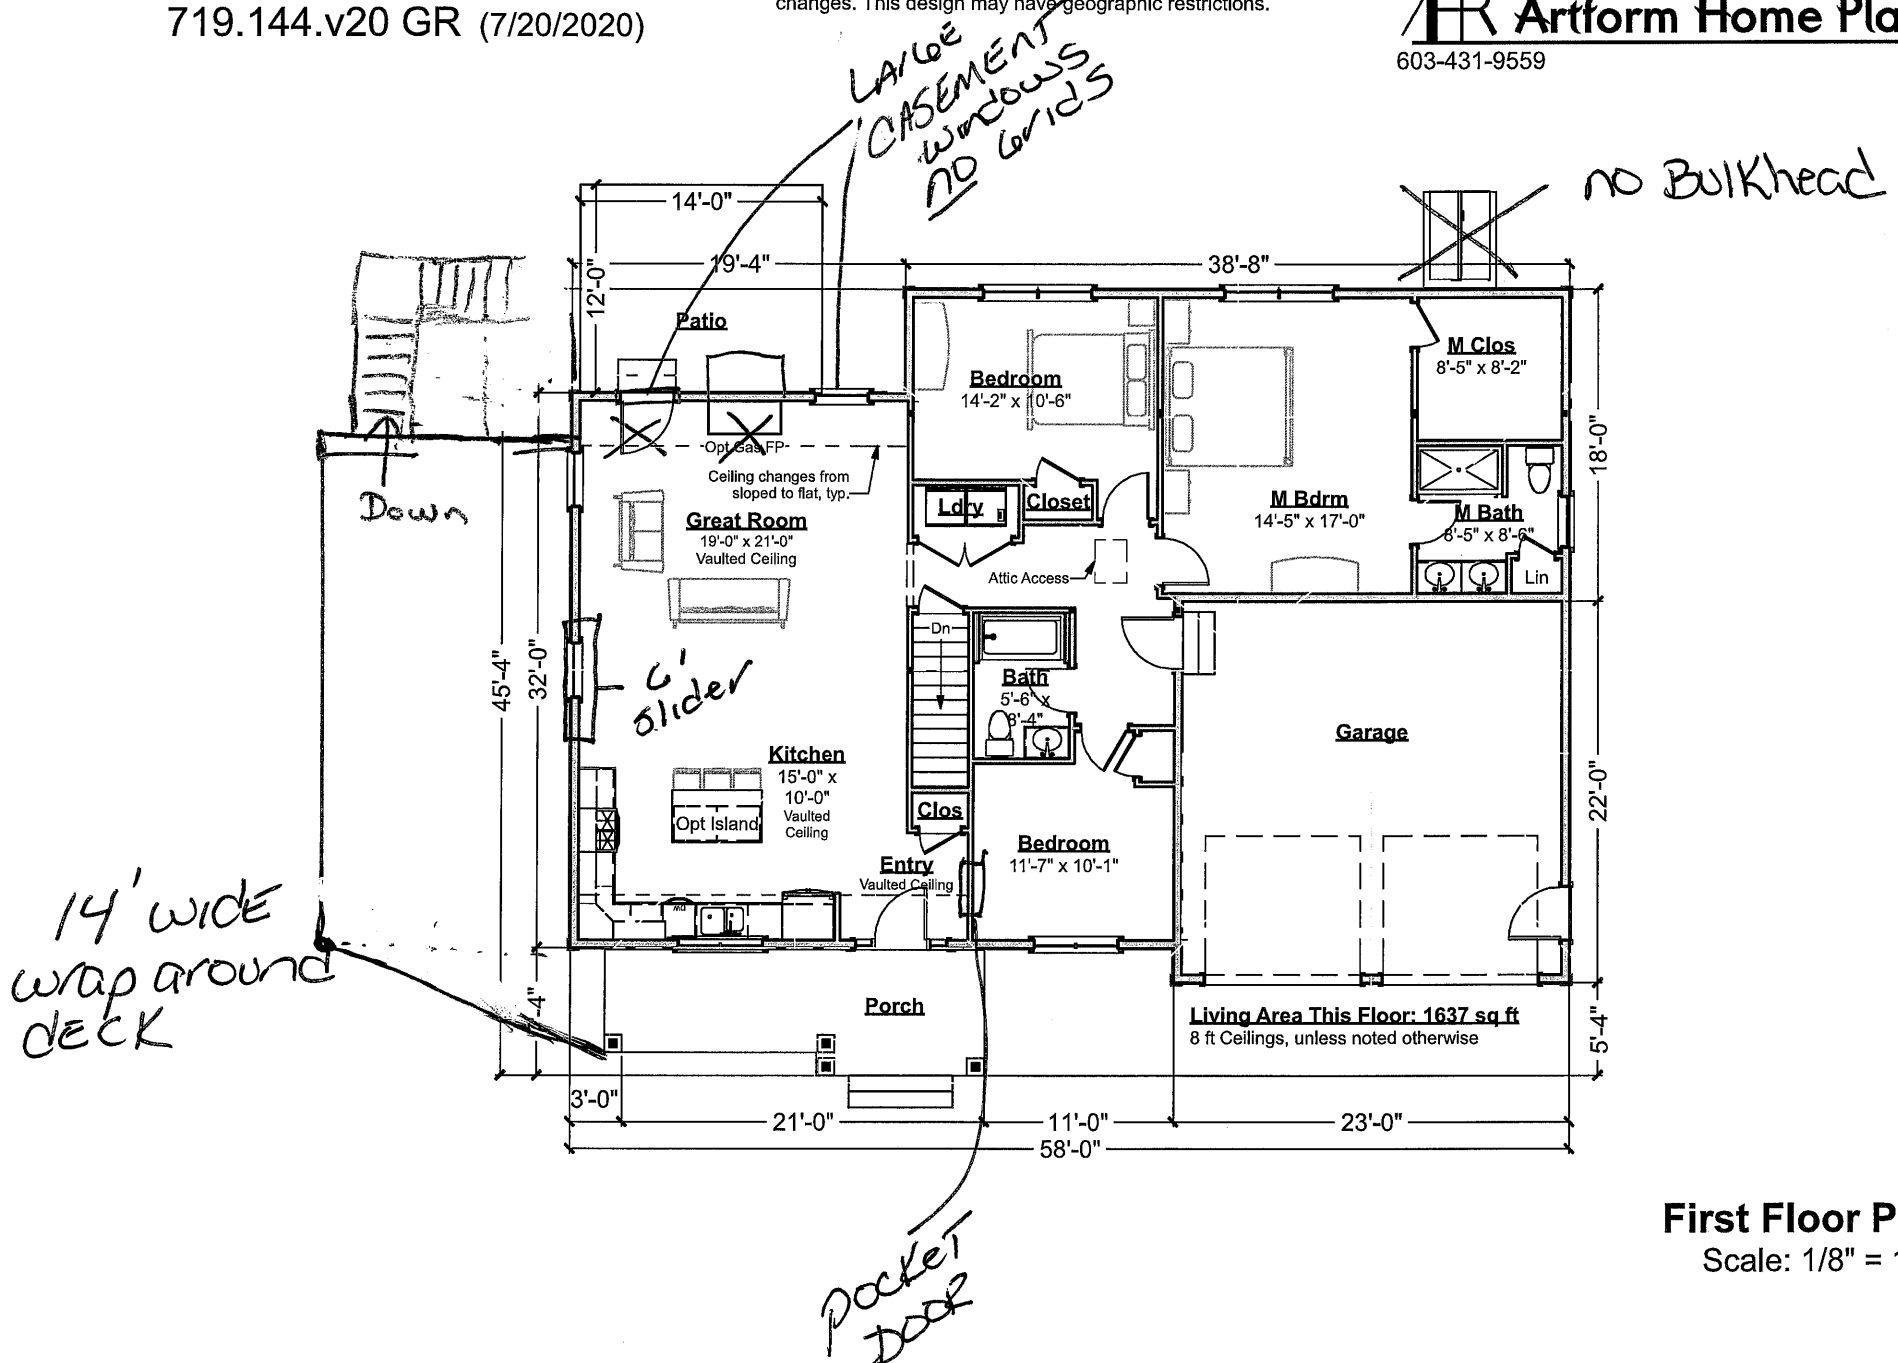

First Floor Plan


Scale: 1/8" = 1'-0"

Sasha

719.144.v20 GR (7/20/2020)

© 2015-2020 Art Form Architecture, Inc., all rights reserved . You may not build this design without purchasing a license, even if you make changes. This design may have geographic restrictions.

Artform Home Plans
603-431-9559

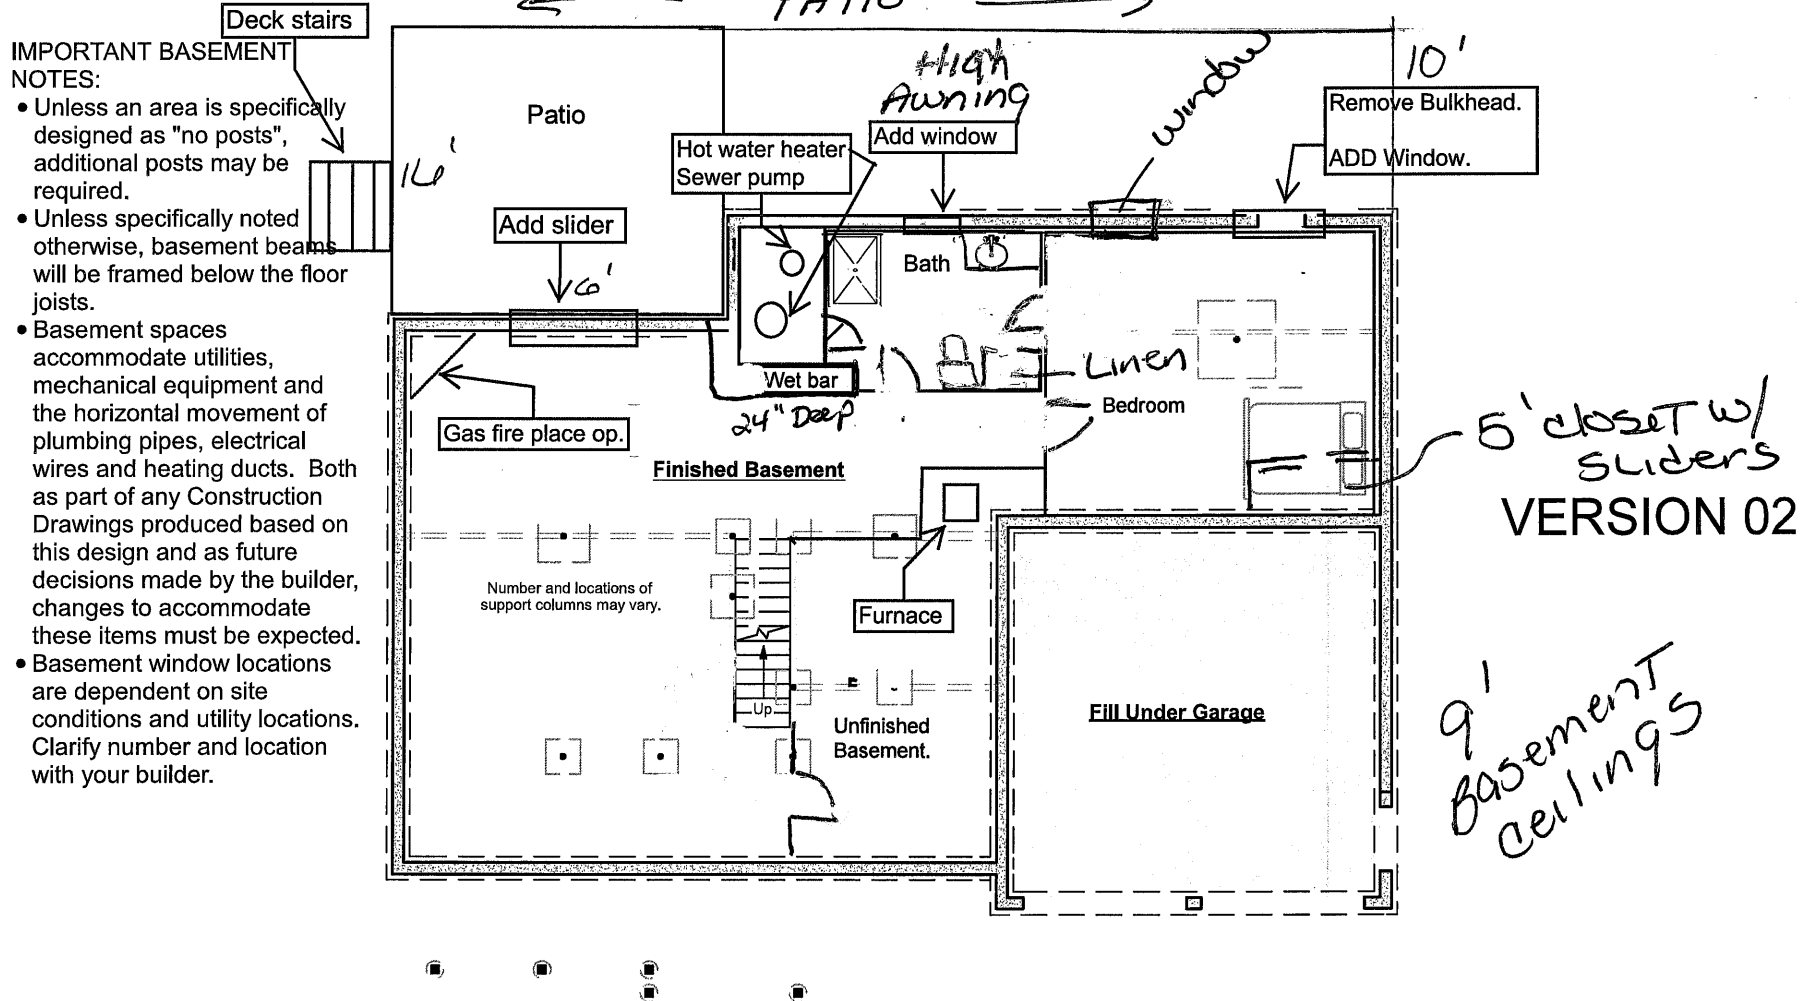

Foundation Plan

Scale: 1/8" = 1'-0"