

934.126 GL Aurelia


Artform Home Plans

First Floor

	Area	Beds	Baths
Main	1049 SF	0	0.5
Future	0 SF	1	0
Apt	0 SF	0	0
Total	1049 SF	1	0.5
Ceiling Height			
Shown	9'-0"		
Possible*	8'-0"		

* See Major Change information on plan page for cost

1. Remove mud Room Door
2. Shorten 1/2 Bath - ADD Pantry
3. no upper cabinets on Back wall - 3 double mul windows
4. Remove window next to slider
5. Reverse active panel on Slider
6. center Fireplace on 32' wall
7. Pocket door in study

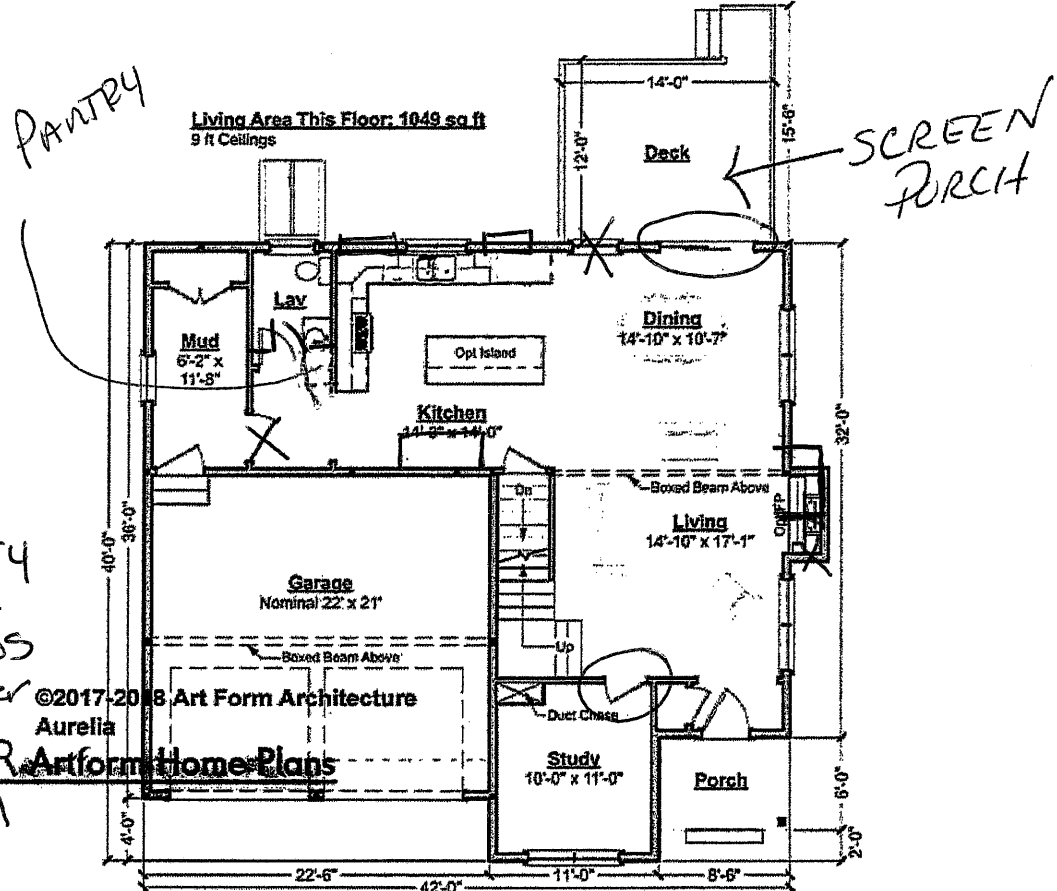

Use of this document is governed by our **Terms and Conditions**, found on our website:
<http://www.artformhomeplans.com/TermsConditions.a5w>

© 2017 Art Form Architecture, Inc. ALL RIGHTS RESERVED.
 You may not build this Design without purchasing a License to Build (as defined in our Terms). Unauthorized changes are not permitted and violate copyright laws, which provide substantial penalties for infringement.

Some features show are optional. Your Purchase & Sale Agreement governs, whether items are labeled "optional" in this document or not.

We are not responsible for typographical errors.

934.126 GL Aurelia


Artform Home Plans 30

Second Floor

	Area	Beds	Baths
Main	1253 SF	3	2
Future	0 SF	0	0
Apt	0 SF	0	0
Total	1253 SF	3	2
Ceiling Height			
Shown	8'-0"		
Possible*	8'-0"		

* See Major Change information on plan page for cost

8. make Bath 1' Larger
9. center window on Back wall
10. 3 closets - pocket doors
11. move window in Back bedroom TO Back wall
12. move Front Bedroom window as far forward as possible

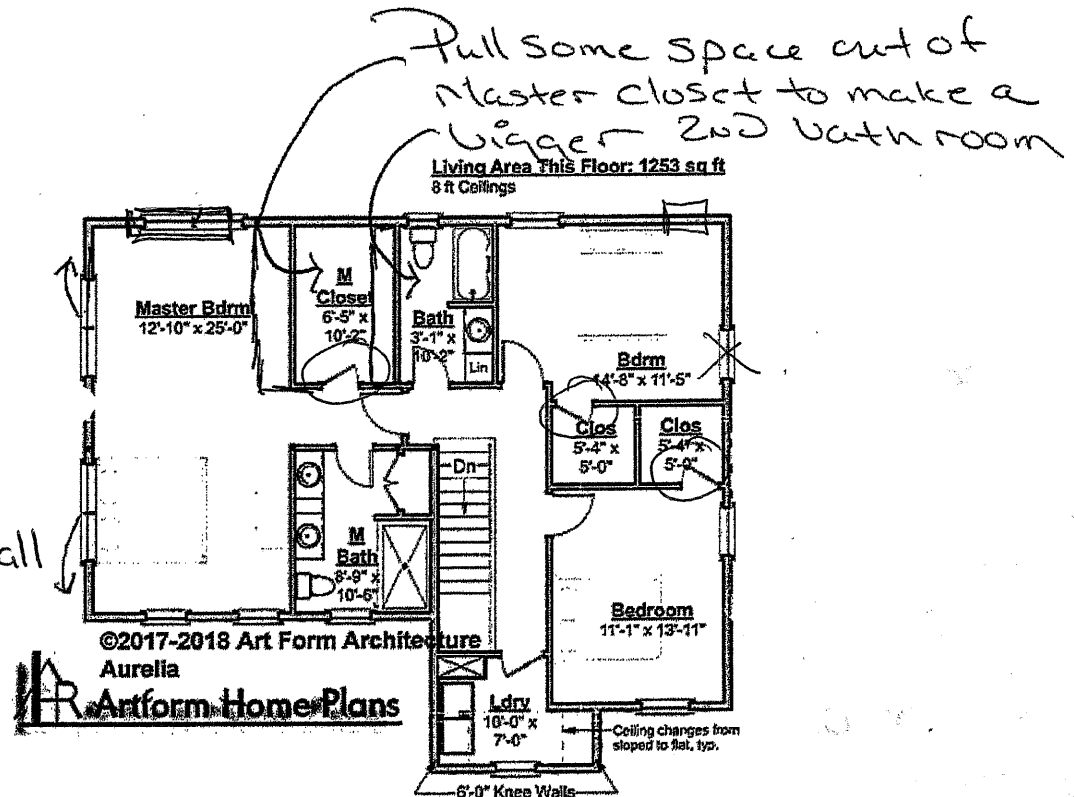

Use of this document is governed by our Terms and Conditions, found on our website:
<http://www.artformhomeplans.com/TermsConditions.a5w>

© 2017 Art Form Architecture, Inc. ALL RIGHTS RESERVED.
You may not build this Design without purchasing a License to Build (as defined in our Terms). Unauthorized changes are not permitted and violate copyright laws, which provide substantial penalties for infringement.

So: ... optional. ... whether items are labeled "optional" in this document or not.

We are not responsible for typographical errors.