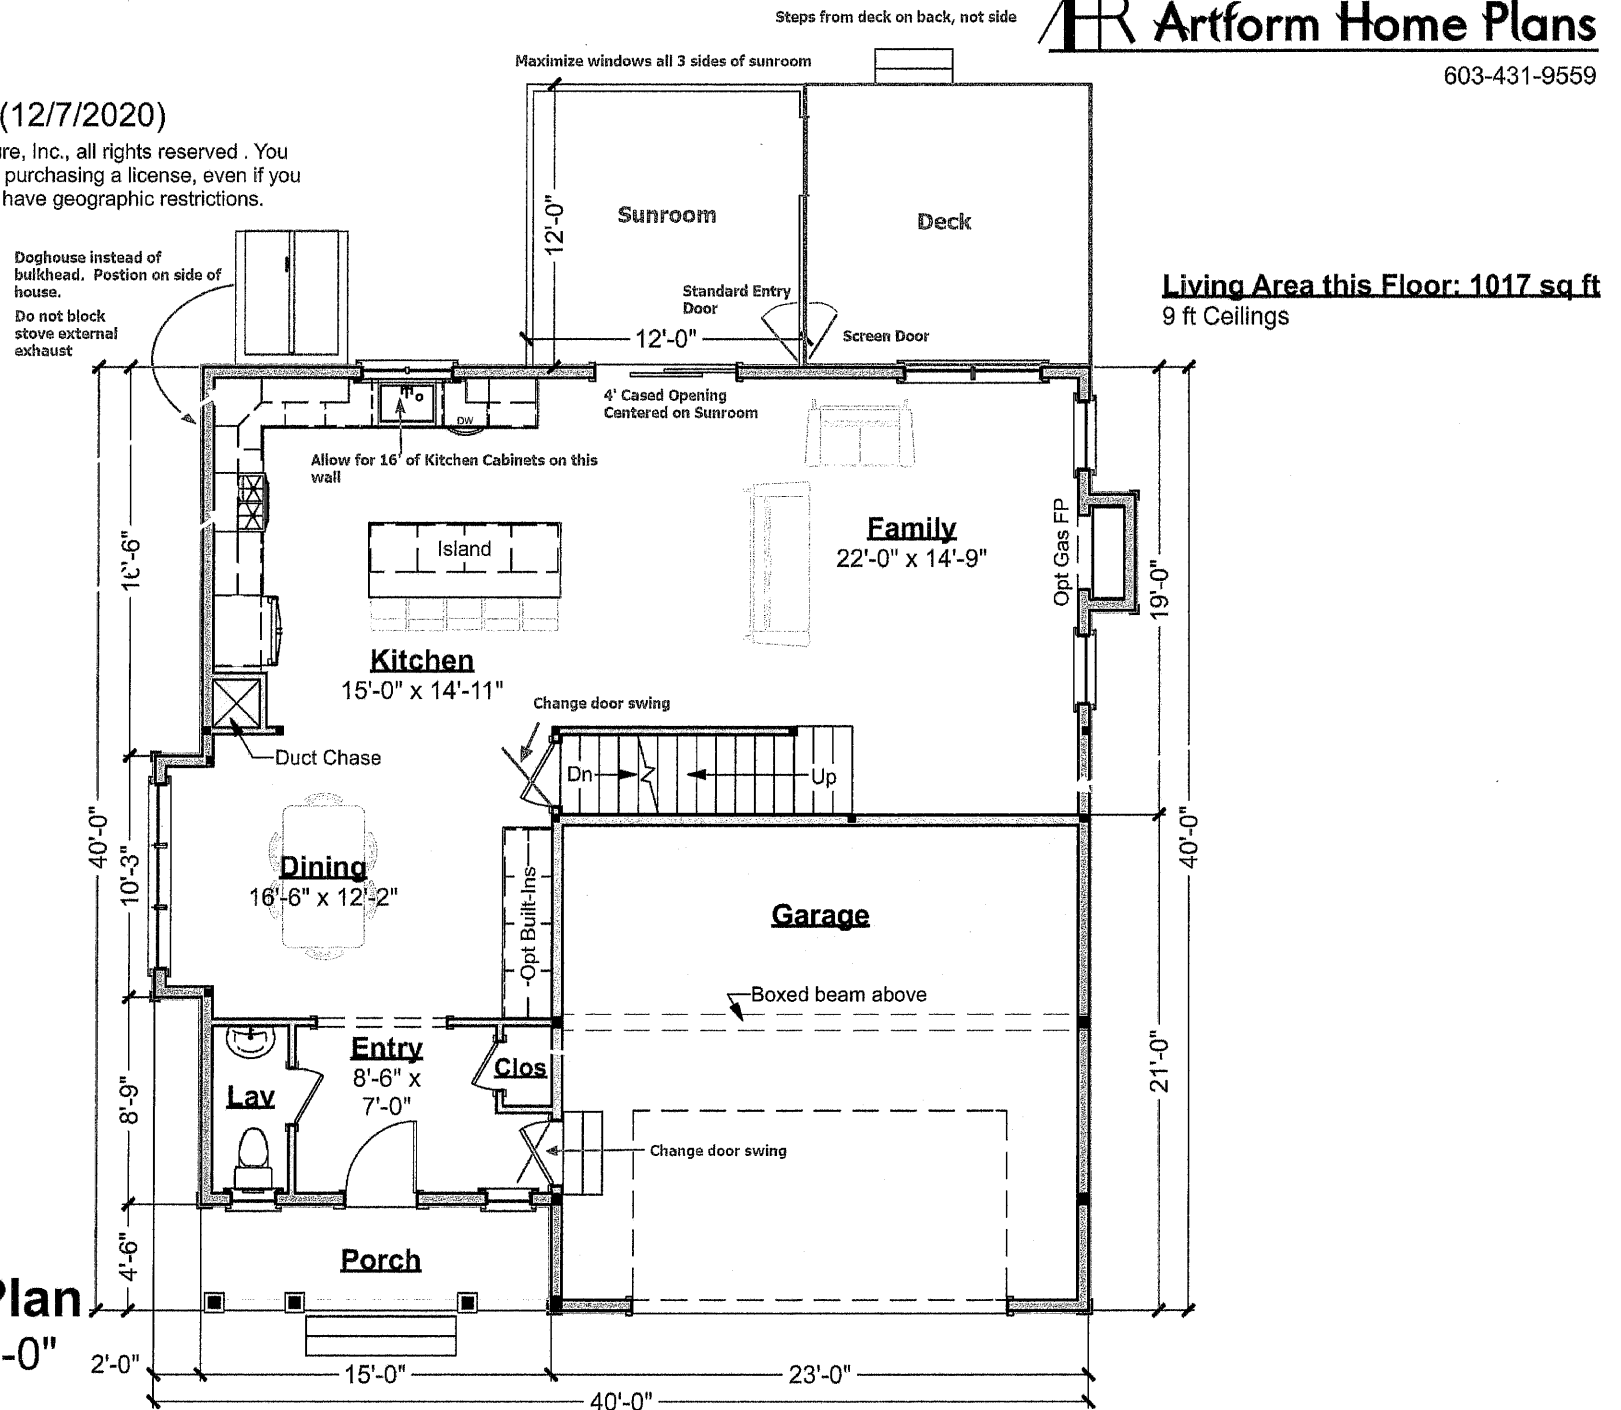


Sir Zach

845.124.v8 GR (12/7/2020)

© 2016-2020 Art Form Architecture, Inc., all rights reserved. You may not build this design without purchasing a license, even if you make changes. This design may have geographic restrictions.



First Floor Plan

Scale: 1/8" = 1'-0"

Sir Zach

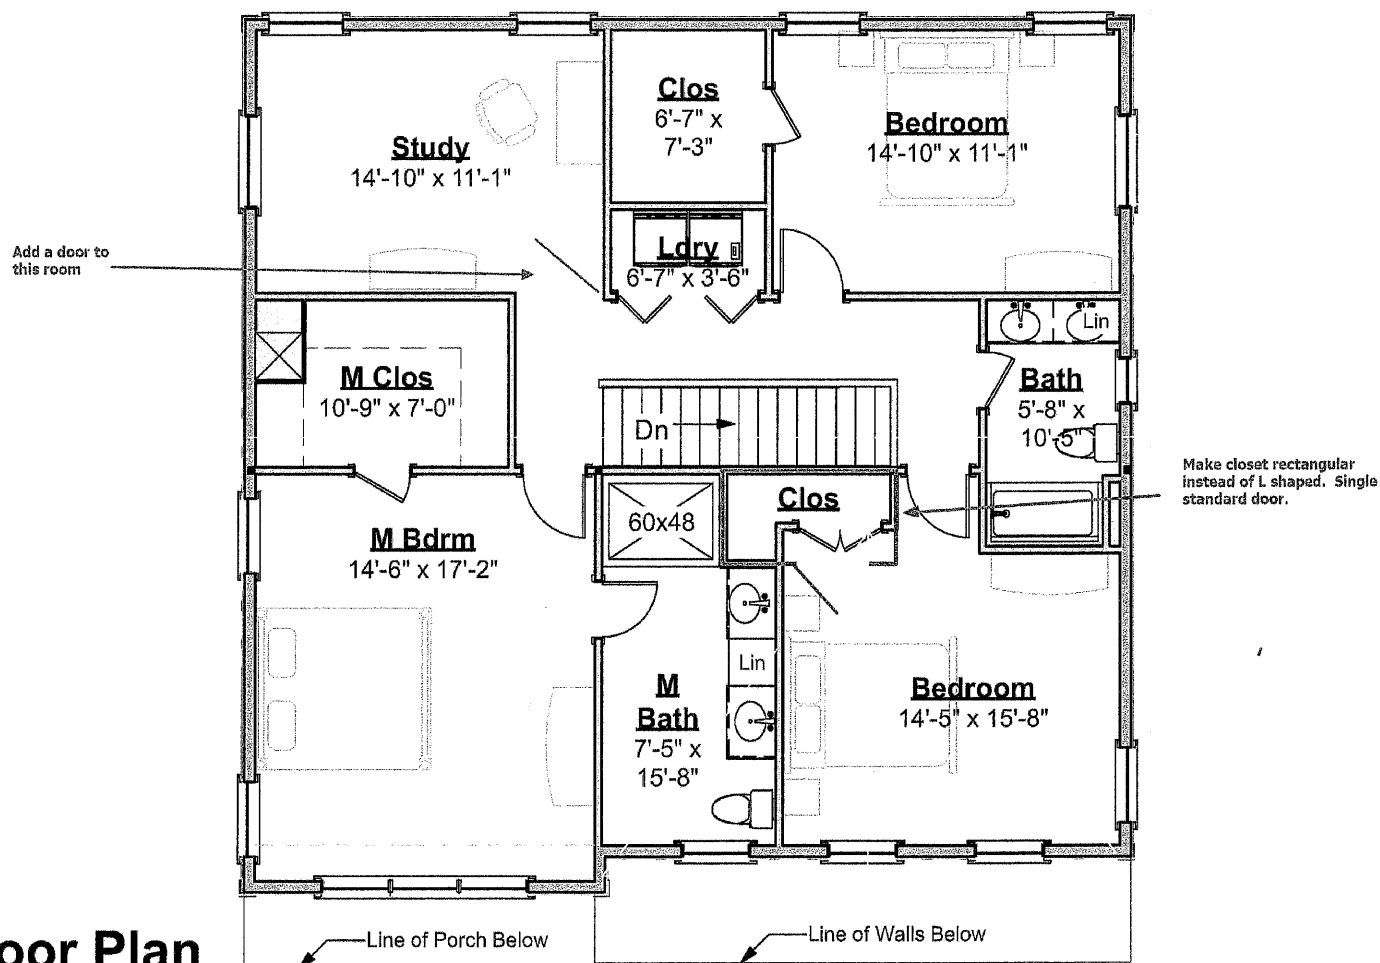
845.124.v8 GR (12/7/2020)

© 2016-2020 Art Form Architecture, Inc., all rights reserved. You may not build this design without purchasing a license, even if you make changes. This design may have geographic restrictions.



603-431-9559

Living Area this Floor: 1372 sq ft
8 ft Ceilings

**Second Floor Plan**

Scale: 1/8" = 1'-0"

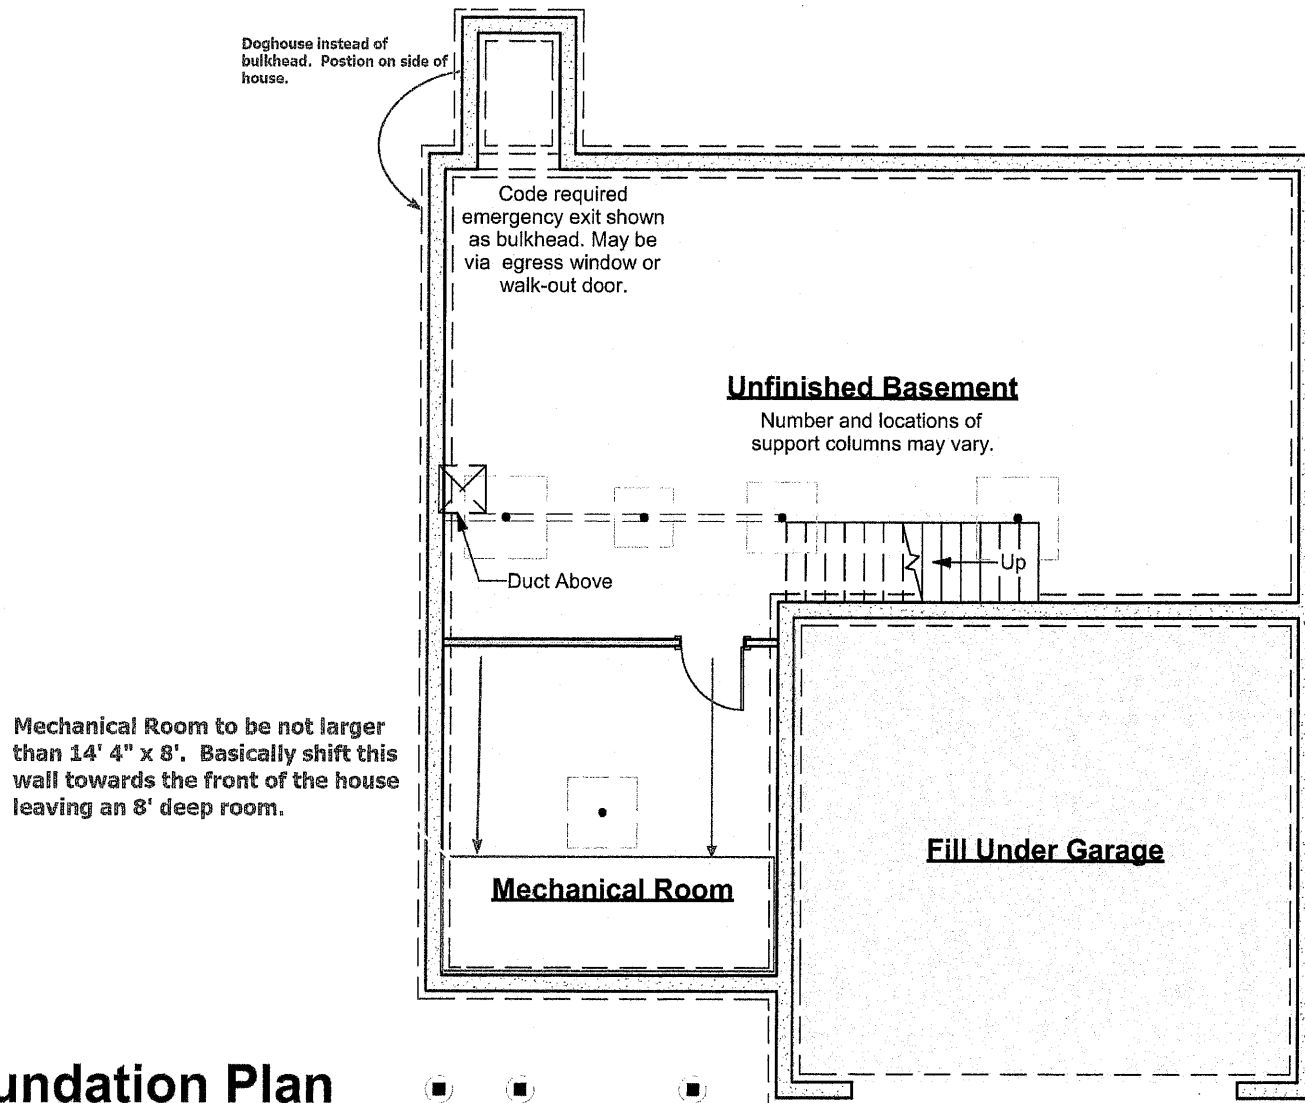
Sir Zach

845.124.v8 GR (12/7/2020)

© 2016-2020 Art Form Architecture, Inc., all rights reserved. You may not build this design without purchasing a license, even if you make changes. This design may have geographic restrictions.



603-431-9559

**Foundation Plan**

Scale: 1/8" = 1'-0"