748.144.v2 KL Pharell

Artform Home Plans

First Floor

	Area	Beds	Bath
Main	1724 SF	2	. 2
Future	0 SF	1	0
Apt	0 SF	0	0
Total	1724 SF	3	2


Ceiling Height

Shown 9'-0"

Possible* 8'-0"

Flip Plan-Garage Left
Window Grids - Top only
Slider- Shades between glass

Straight Columns- not Craftsman

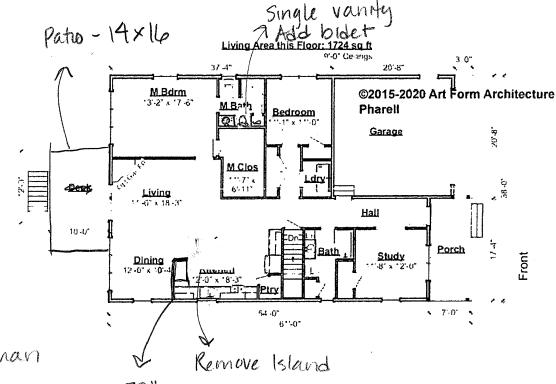

Add 72" wide wall for cabinetry

<u>Use of this document</u> is governed by our **Terms and Conditions**, found on our website:

© 2015 Art Form Architecture, Inc. ALL RIGHTS RESERVED. You may not build-this Design without purchasing a License to Build (as defined in our Terms). Unauthorized changes are not permitted and violate copyright laws, which provide substantial penalties for infringement. Some features show are optional. Your Purchase & Sale Agreement governs, whether items are labeled "optional" in this document or not.

We are not responsible for typographical errors.

^{*} See Major Change information on plan page for cost