



Artform Home Plans  
Art Form Architecture

Lanark

# HOLLY GLEN

BERLINGTON

"The World at Your Door"




S Y M E S

6 over 1 or  
4 over 1  
CORIDS

Corids in  
sliders

windows  
long run  
doors

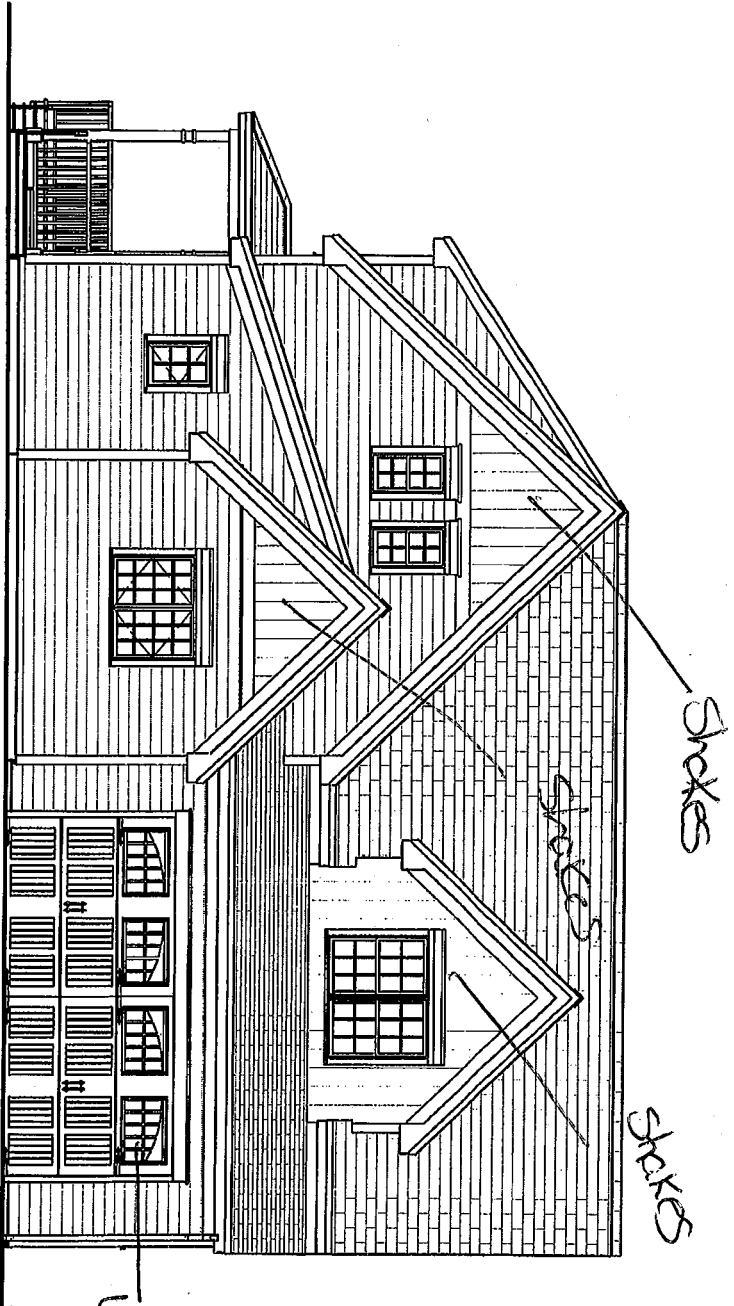

## Front Elevation

Some items shown in 3D views are optional or to be provided by homeowner. Interior views are shown to describe the spaces. Interior trim, paint colors and other interior features may vary. Walk-out basement option not available on all building sites. Basement windows and slider as shown may not be available on every EJA. All dimensions are approximate and some options are included in this rendering; see builders specifications for actual specifications.






# HOLLY GLEN

WIRINGTON

SEE Kitchen  
DESIGN  
S Y M E S

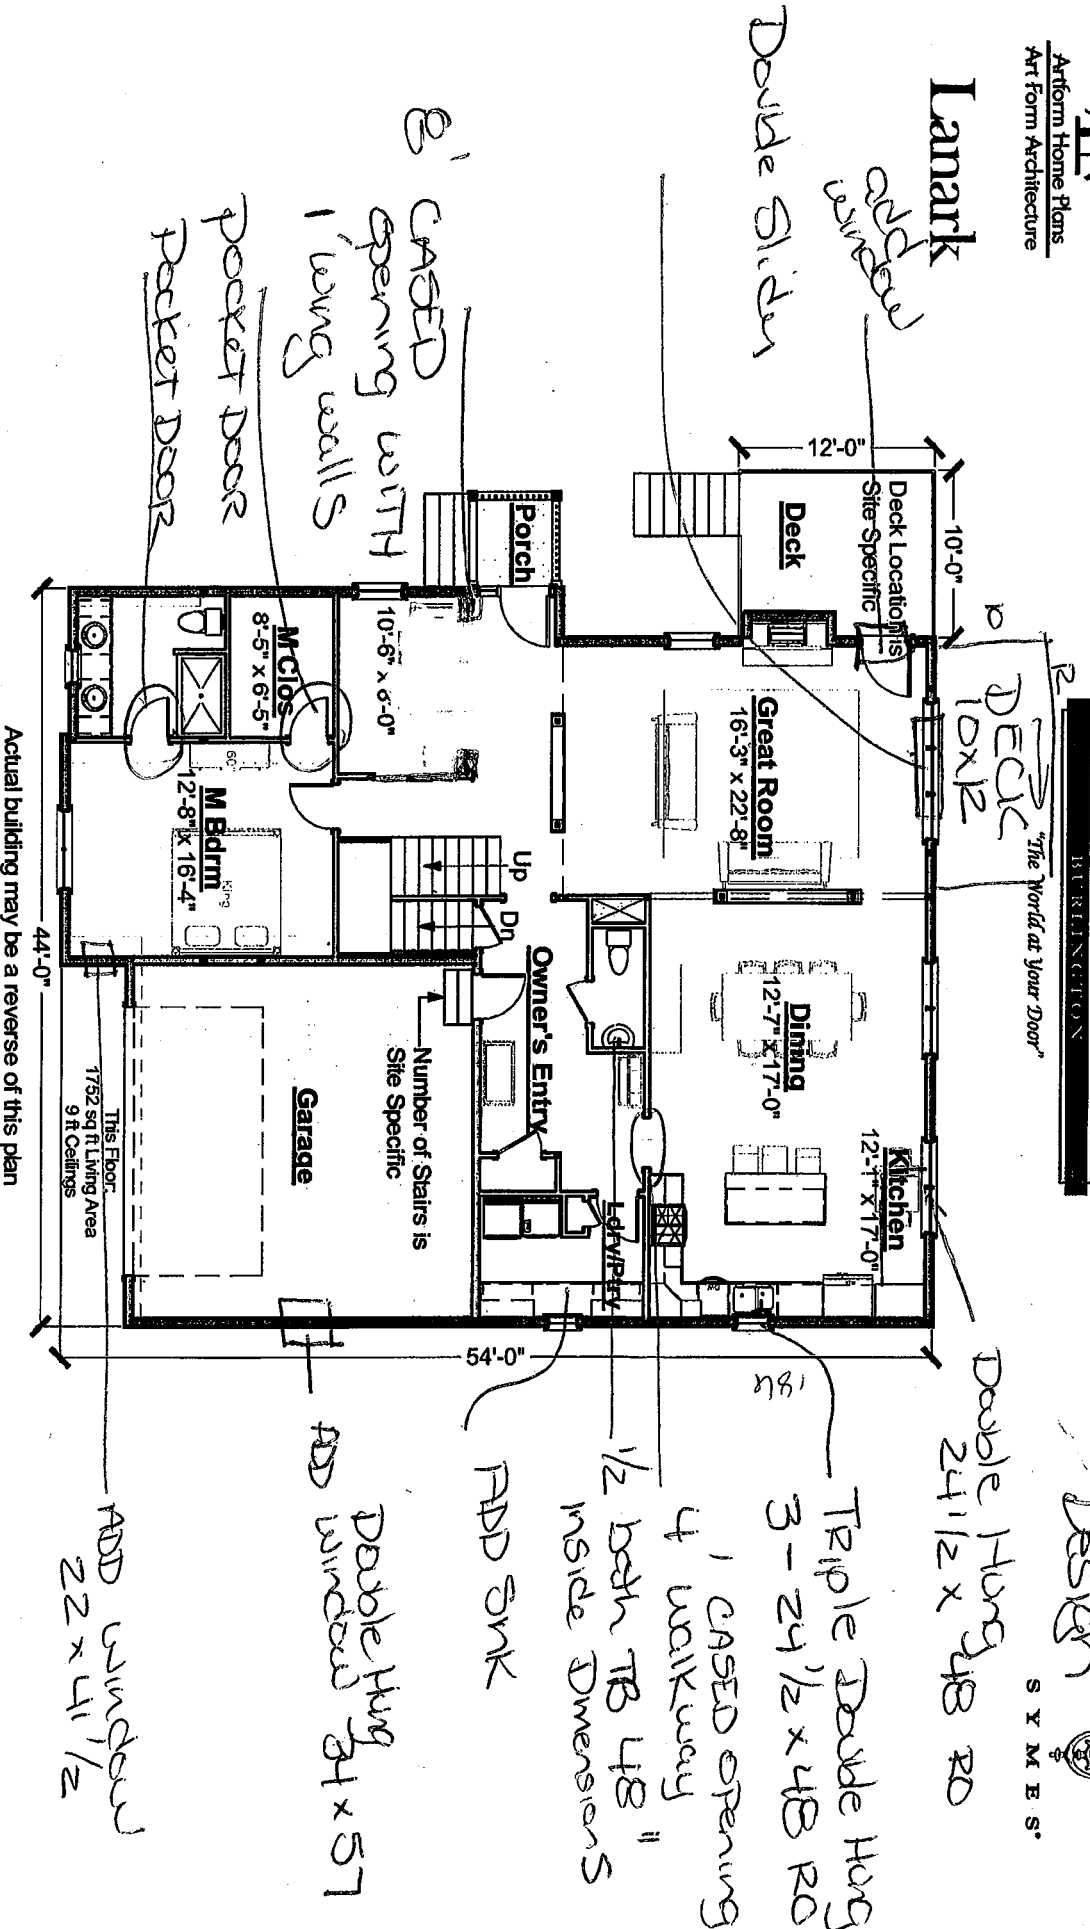


## First Floor Plan

NEW MASTER DESIGN w/ window 2 x 2  
(Take from Basement)

Some items shown in 3D views are optional or to be provided by homeowner. Interior views are shown to describe the spaces. Interior trim, paint colors and other interior features may vary. Walk-out basement option not available on all building sites. Basement windows and slider may not be available on every EJA. All dimensions are approximate and some options are included in this rendering. see builders specifications for actual specifications.



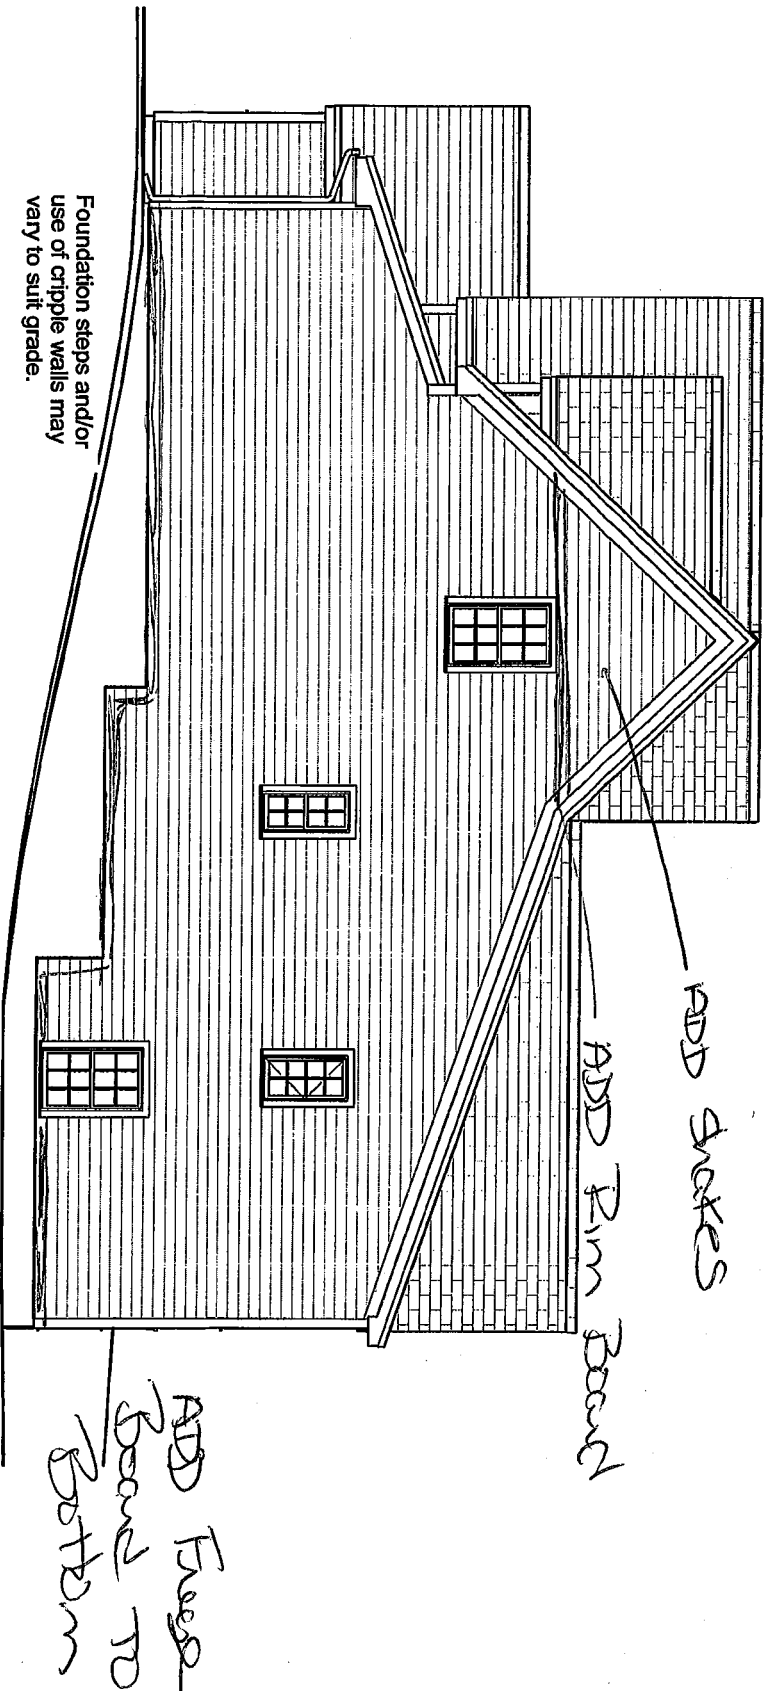

Right Elevation

Some items shown in 3D views are optional or to be provided by homeowner. Interior views are shown to describe the spaces. Interior trim, paint colors and other interior features may vary. Walk-out basement portion not available on all building sites. Basement windows and slider as shown may not be available on every EUA. All dimensions are approximate and some options are included in this rendering. see all items specifications for actual specifications.







Artform Home Plans  
Art Form Architecture


# HOLLY GLEN

BURLINGTON

"The World at Your Door"

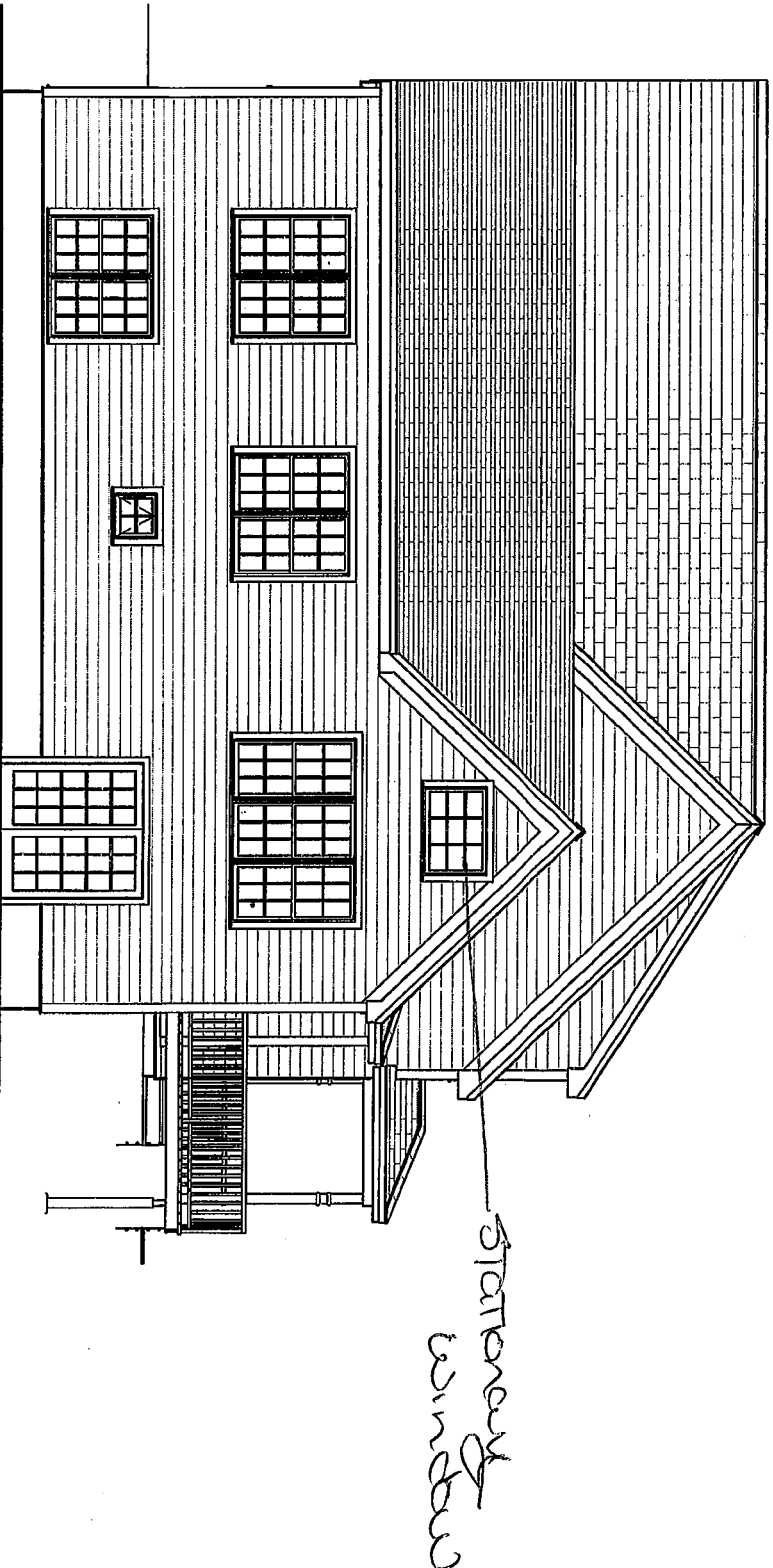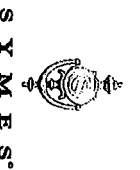

## Rear Elevation

Some items shown in 3D views are optional or to be provided by homeowner. Interior views are shown to describe the spaces. Interior trim, paint colors and other interior features may vary. Walk-out basement option not available on all building sites. Basement windows and slider as shown may not be available on every EJA. All dimensions are approximate and some options are included in this rendering, see builders specifications for actual specifications.







Artform Home Plans  
Art Form Architecture

Lanark

# HOLLY GLEN

BURLINGTON


*"The World at Your Door"*

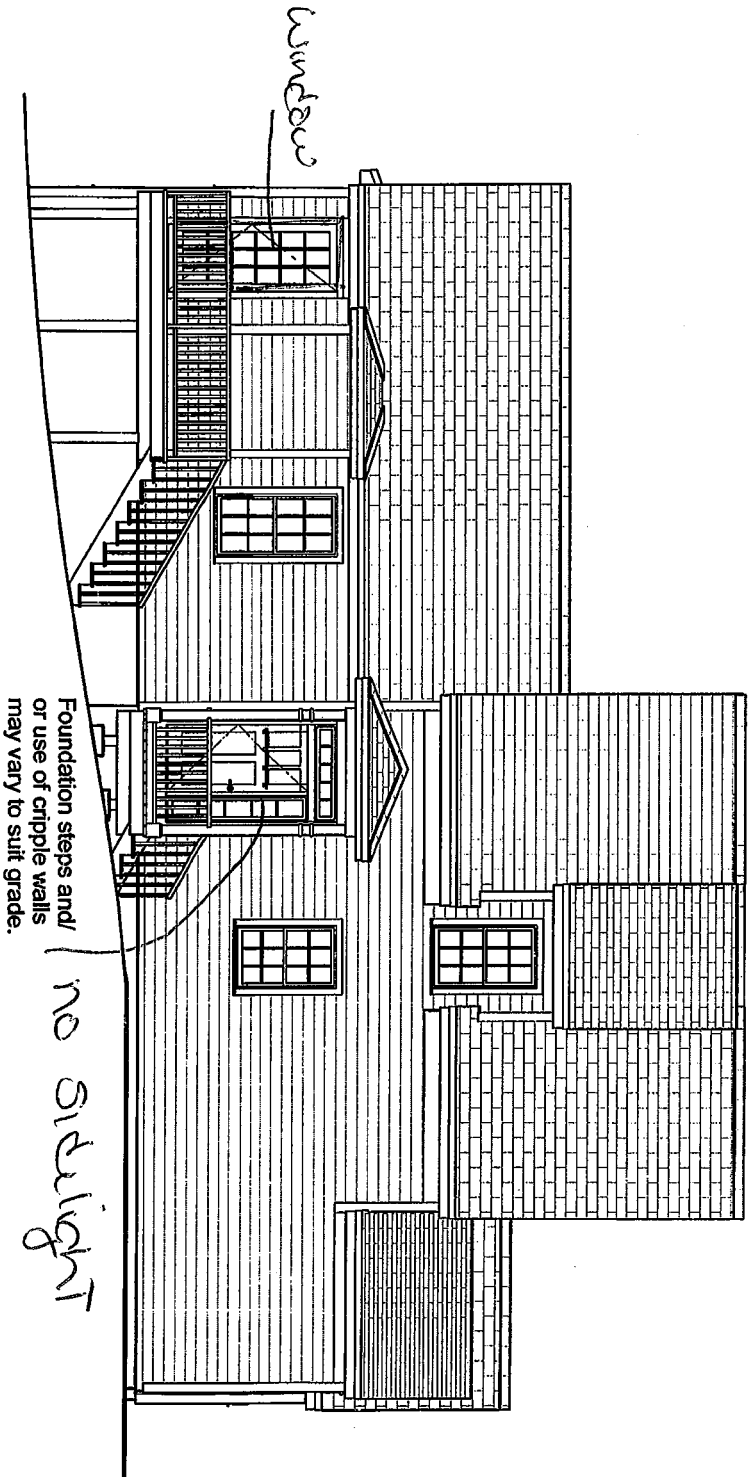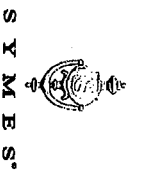

Left Elevation

Some items shown in 3D views are optional or to be provided by homeowner. Interior views are shown to describe the spaces. Interior trim, paint colors and other interior features may vary. Walk-out basement option not available on all building sites. Basement windows and slider as shown may not be available on every EUA. All dimensions are approximate and some options are included in this rendering. see builders specifications for actual specifications.



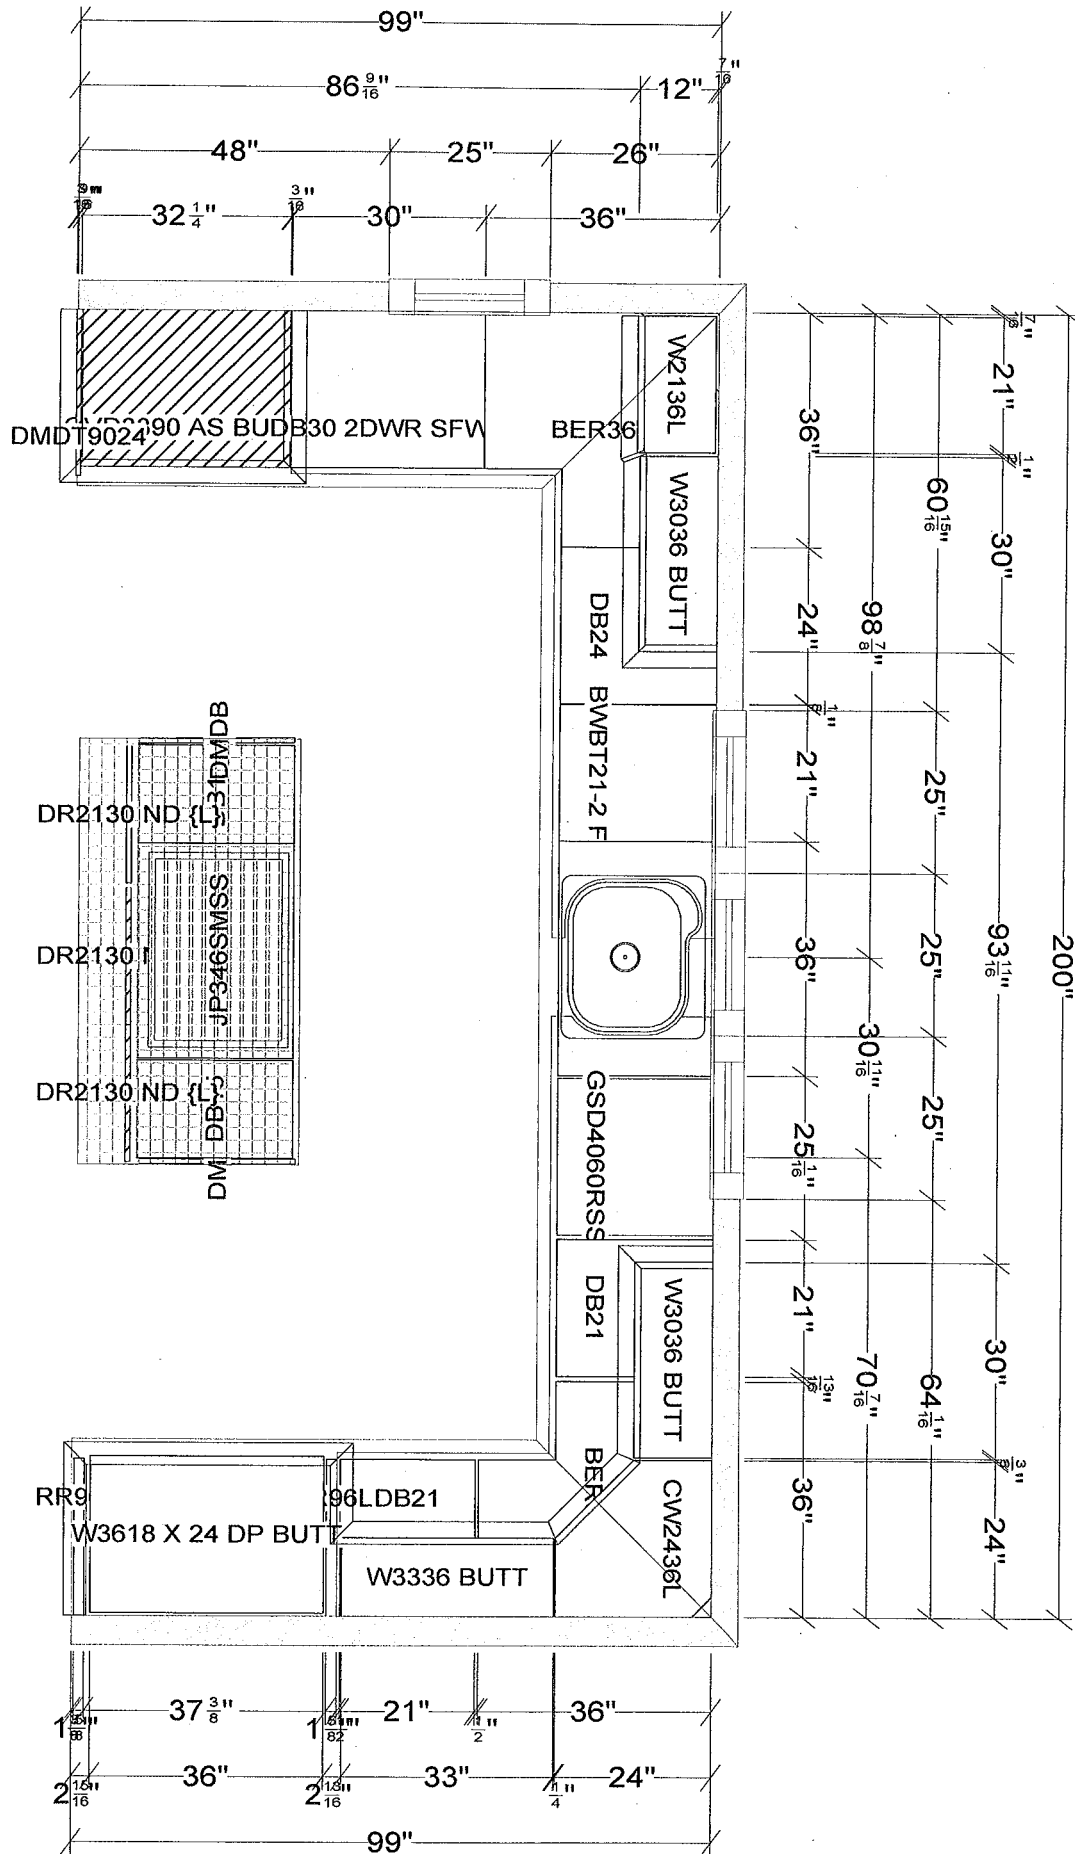

All dimensions and size designations given are subject to verification on job site and adjustment to fit job conditions.



This is an original design and must not be released or copied unless applicable fee has been paid or job order placed.

Designed: 1/4/2016  
Printed: 1/6/2016



MASTER BATH - JOHN & JANE WERNER  
8 PEARSON PLACE

12/30/15

