


Maximus Cottagus

371.001 EL

© 2011-2012 Wendy Welton, all rights reserved. You may not build this design without purchasing a license, even with changes. Some Artform designs have geographic restrictions. Contact the Builder or RE Agent or call Artform at 603-431-9559

Artform Home Plans
Chinburg Builders 603-868-5995
Gove Group Real Estate 603-778-6400

First Floor

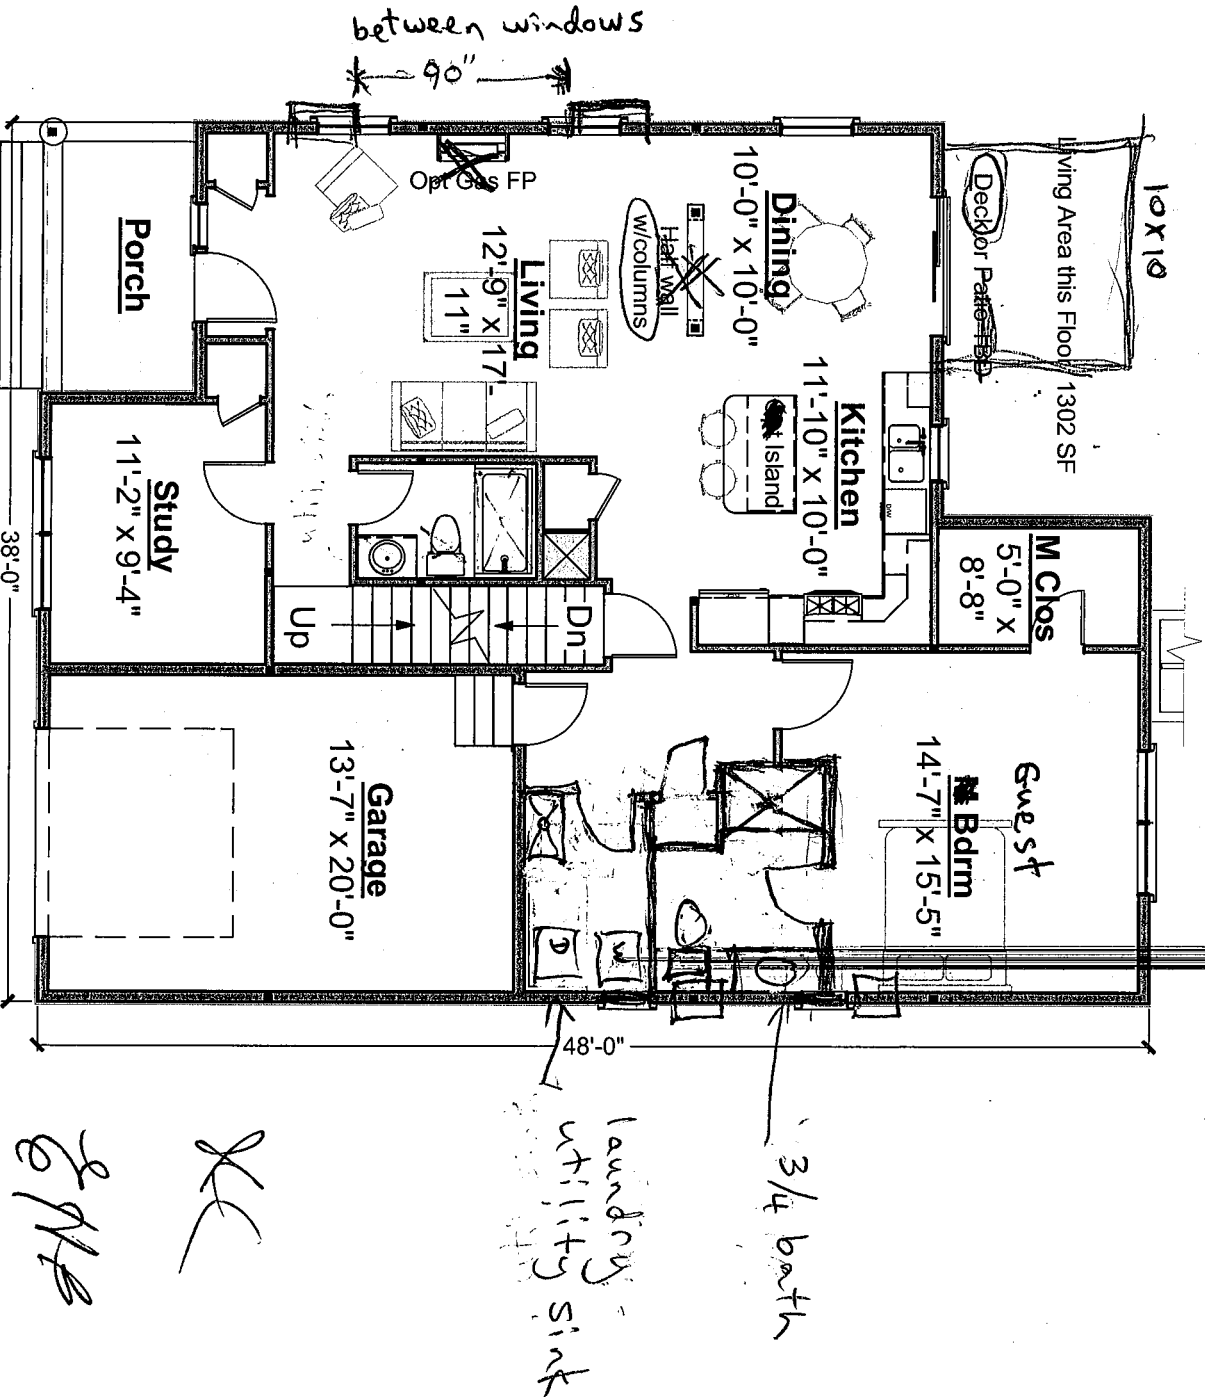

Handwritten initials and signature: *KE* and *2/11/12*

Maximus Cottagus


371.001 EL

© 2011-2012 Wendy Welton, all rights reserved. You may not build this design without purchasing a license, even with changes. Some Artform designs have geographic restrictions. Contact the Builder or RE Agent or call Artform at 603-431-9559

Artform Home Plans

Chinburg Builders 603-868-5995
Gove Group Real Estate 603-778-6400

Second Floor

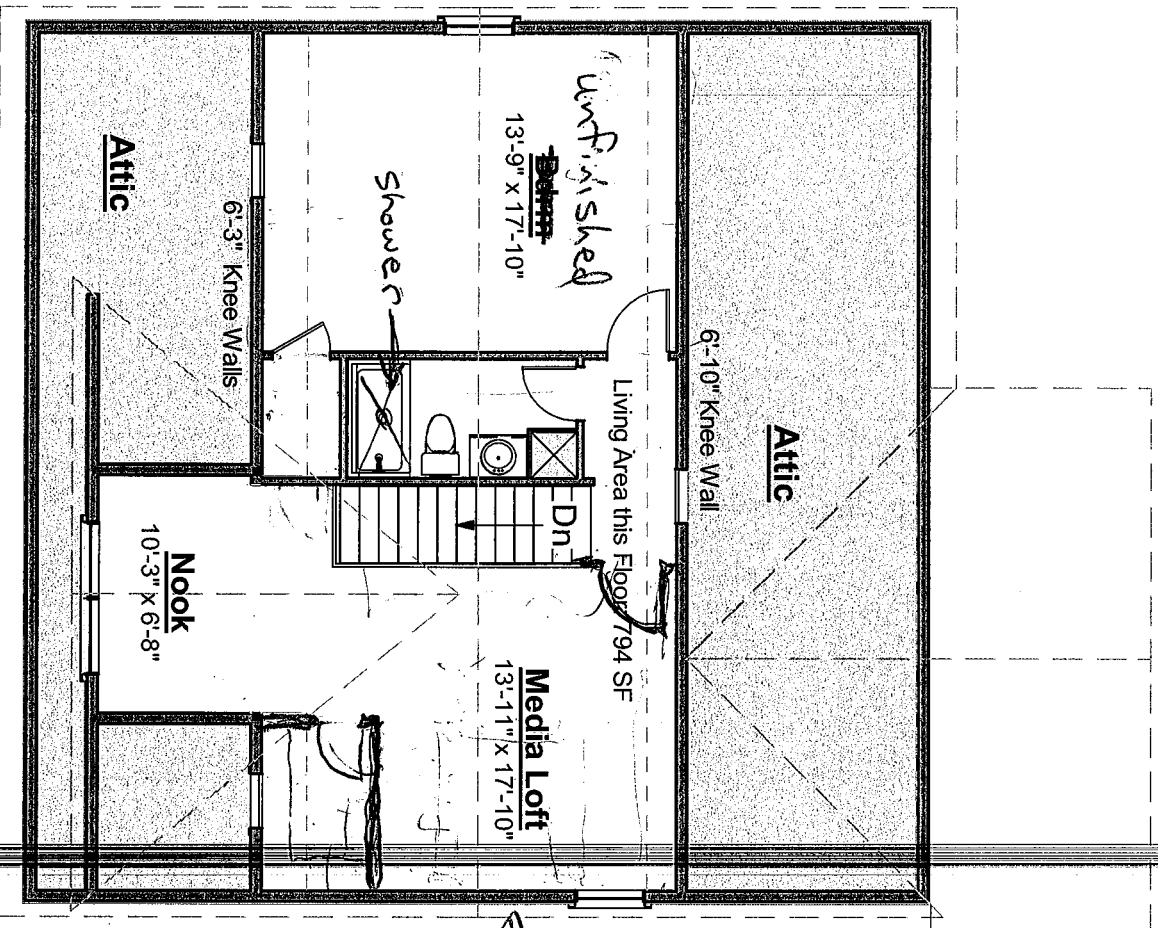

← finished

XC

2/15