


Great Skye Prime

635.121 KL

© 2015 Art Form Architecture, all rights reserved. You may not build this design without purchasing a license, even if you make changes. This design may have geographic restrictions.

Artform Home Plans

603-431-9559

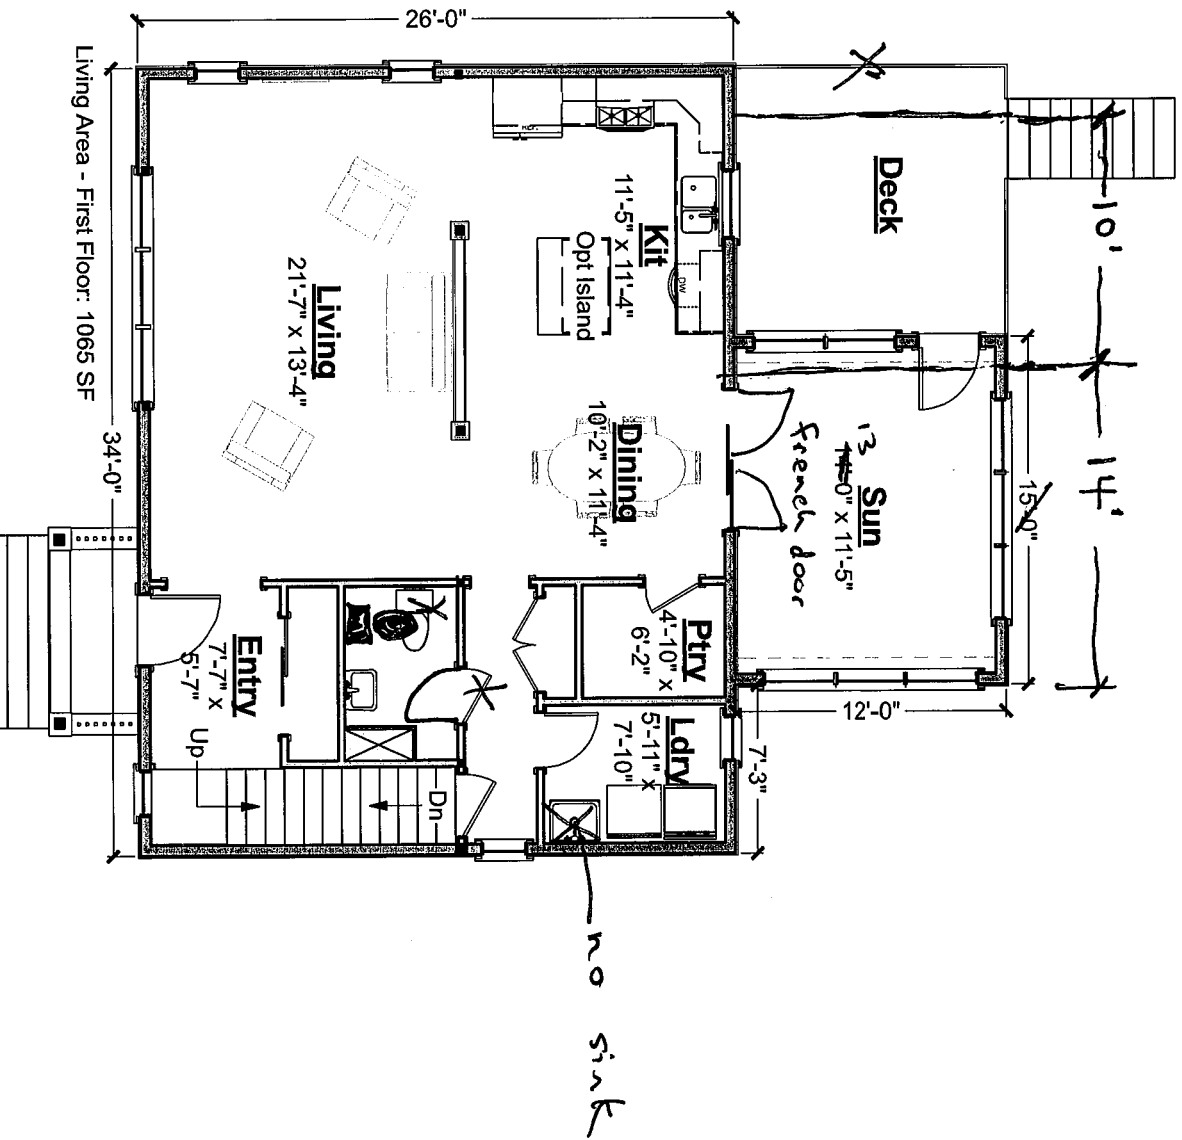

First Floor Plan


Great Skye Prime

635.121 KL

© 2015 Art Form Architecture, all rights reserved. You may not build this design without purchasing a license, even if you make changes. This design may have geographic restrictions.

Artform Home Plans

603-431-9559

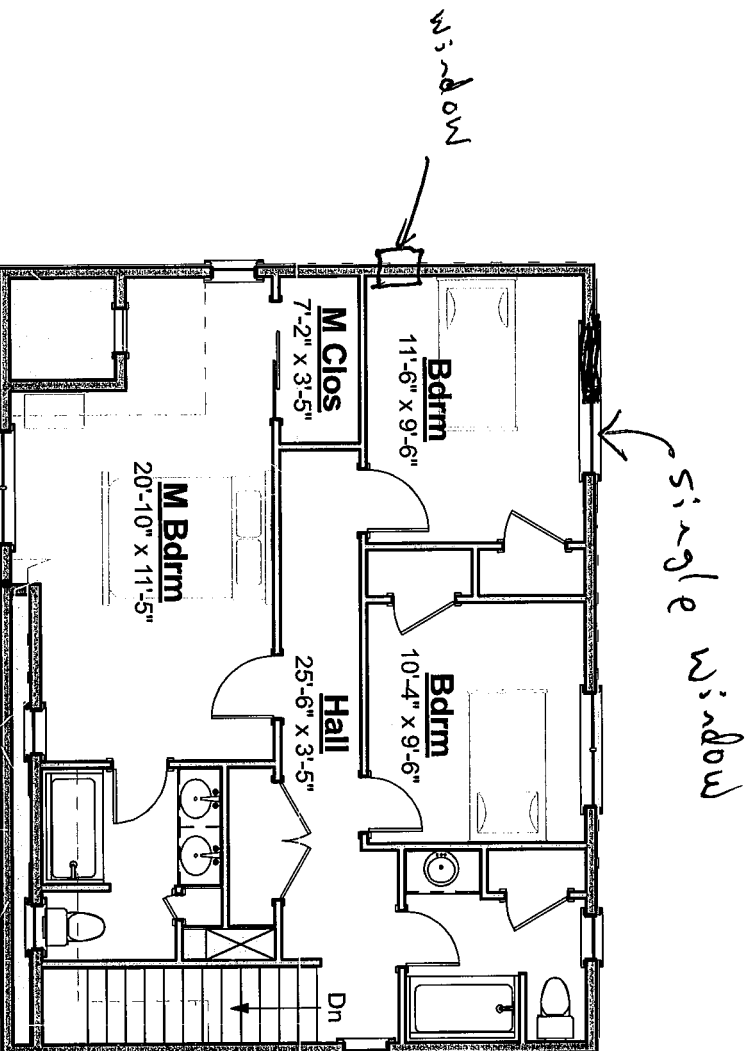

Living Area Second Floor: 834 SF

Second Floor Plan

Great Skye Prime


635.121 KL

© 2015 Art Form Architecture, all rights reserved. You may not build this design without purchasing a license, even if you make changes. This design may have geographic restrictions.

 **Artform Home Plans**

603-431-9559

3068 9-1-13 ft

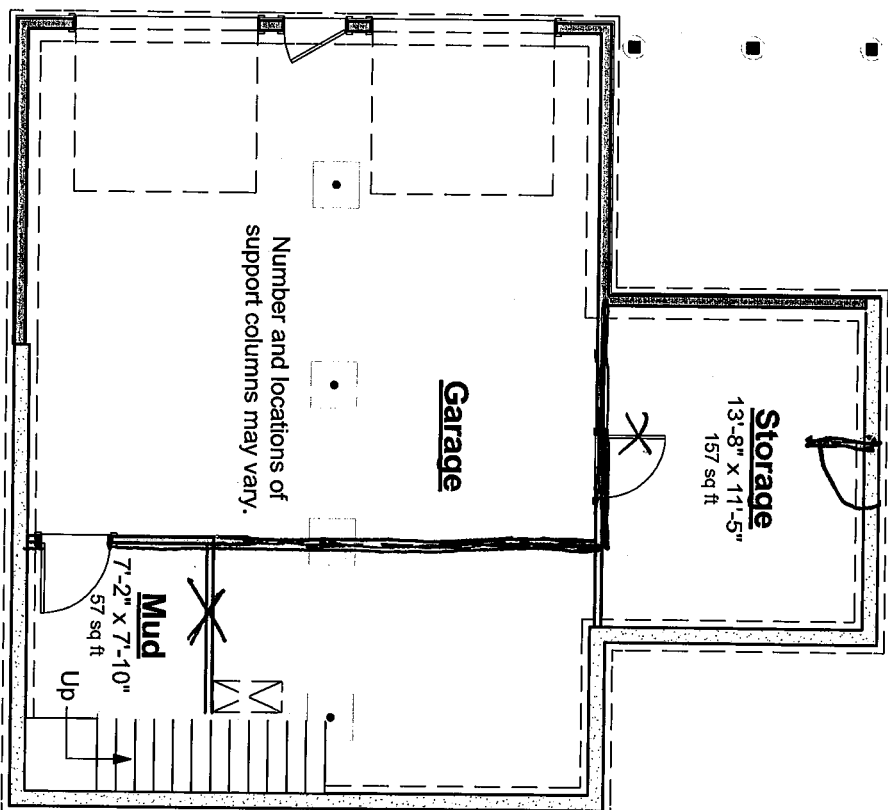

Foundation Plan