


Vanilla Torte

594.124.v1


© 2013 Wendy Welton, all rights reserved . You may not build this design without purchasing a license, even if you make changes. This design may have geographic restrictions.

Living Area - First Floor: 1554 SF

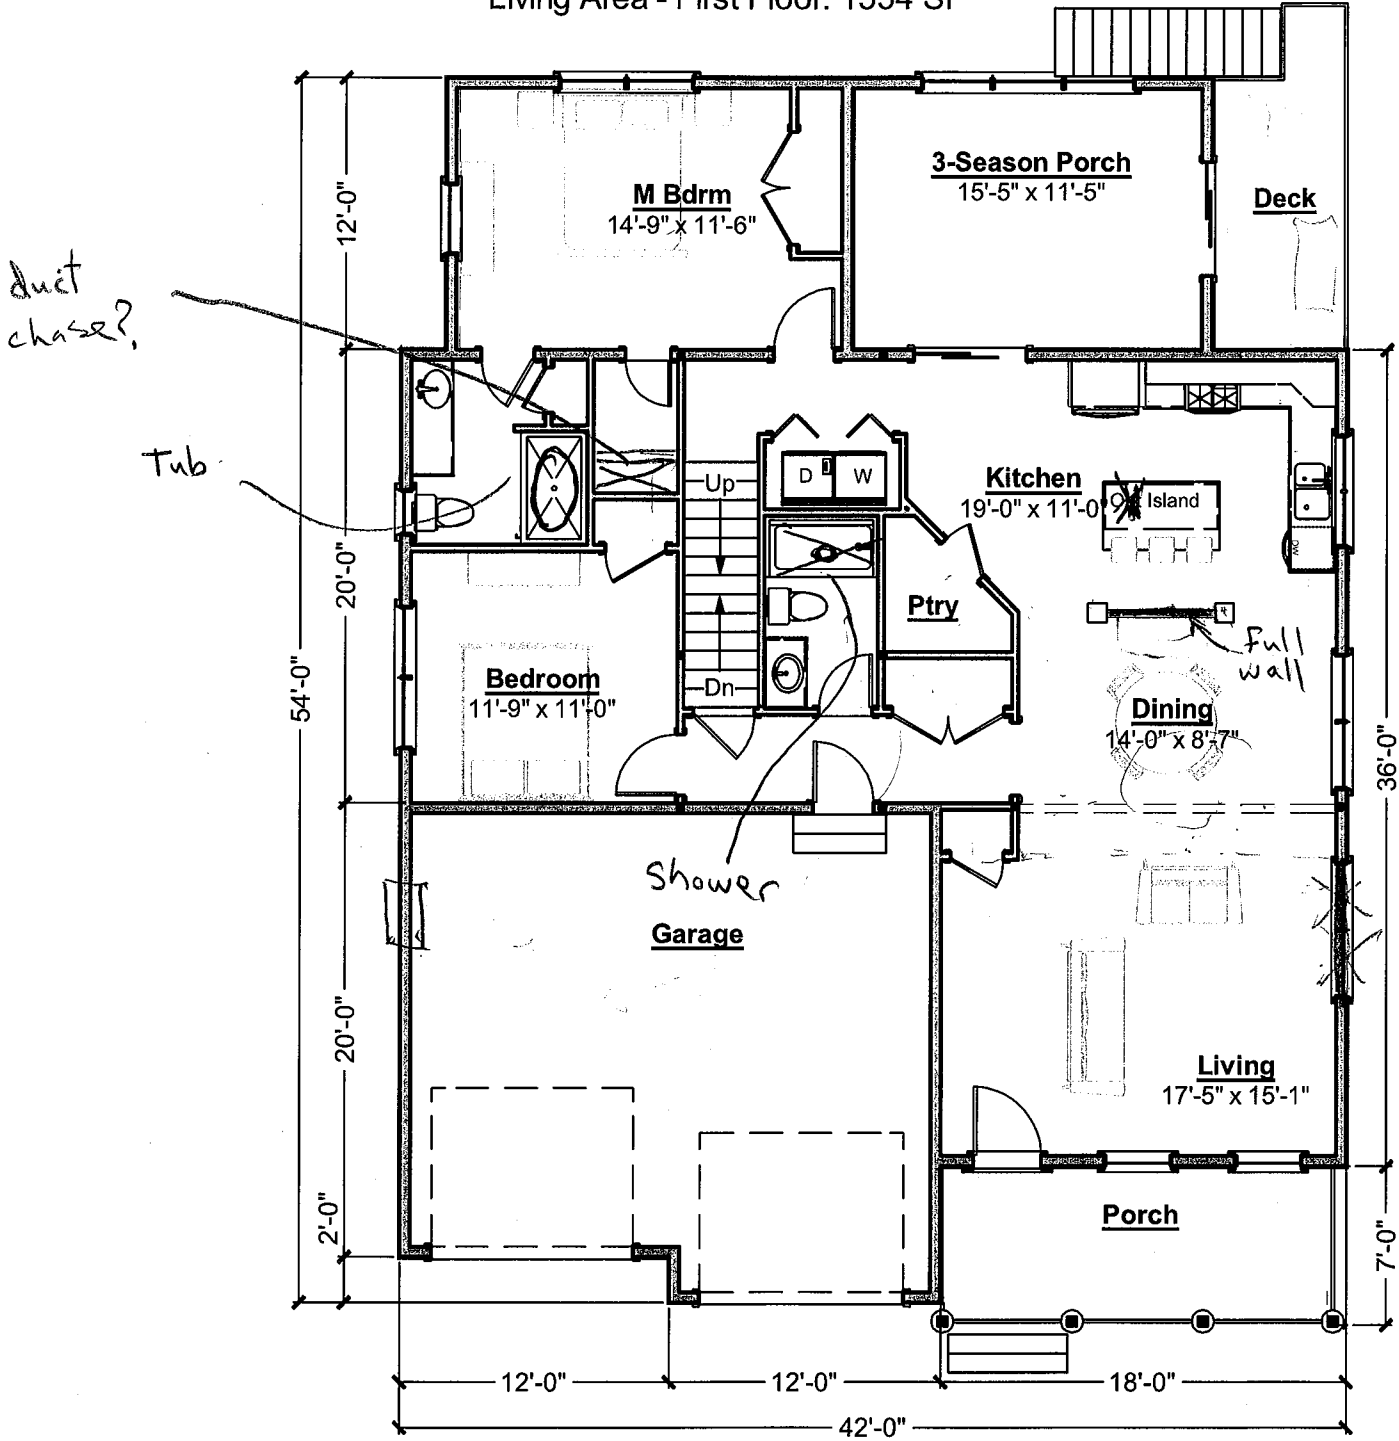

First Floor


Living Area - Second Floor: 668 SF

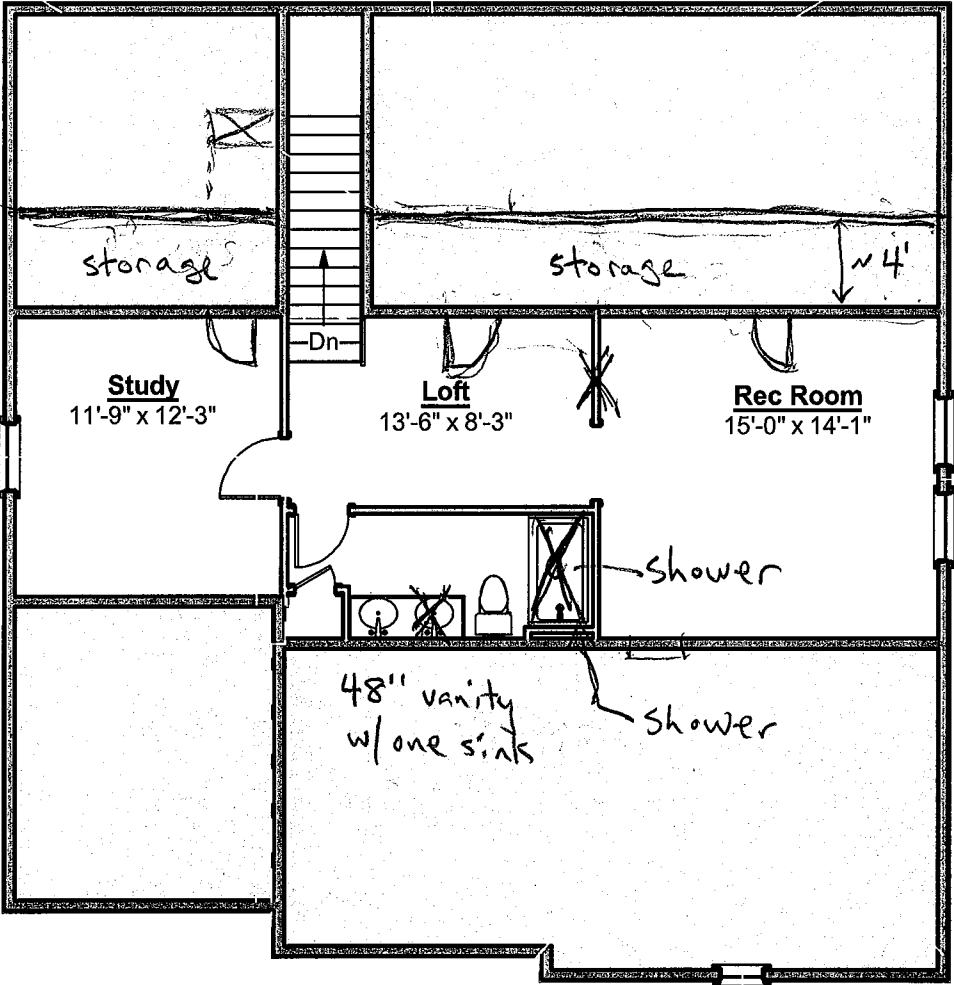

Second Floor

Vanilla Torte
594.124.v1

© 2013 Wendy Welton, all rights reserved . You may not build this design without purchasing a license, even if you make changes. This design may have geographic restrictions.

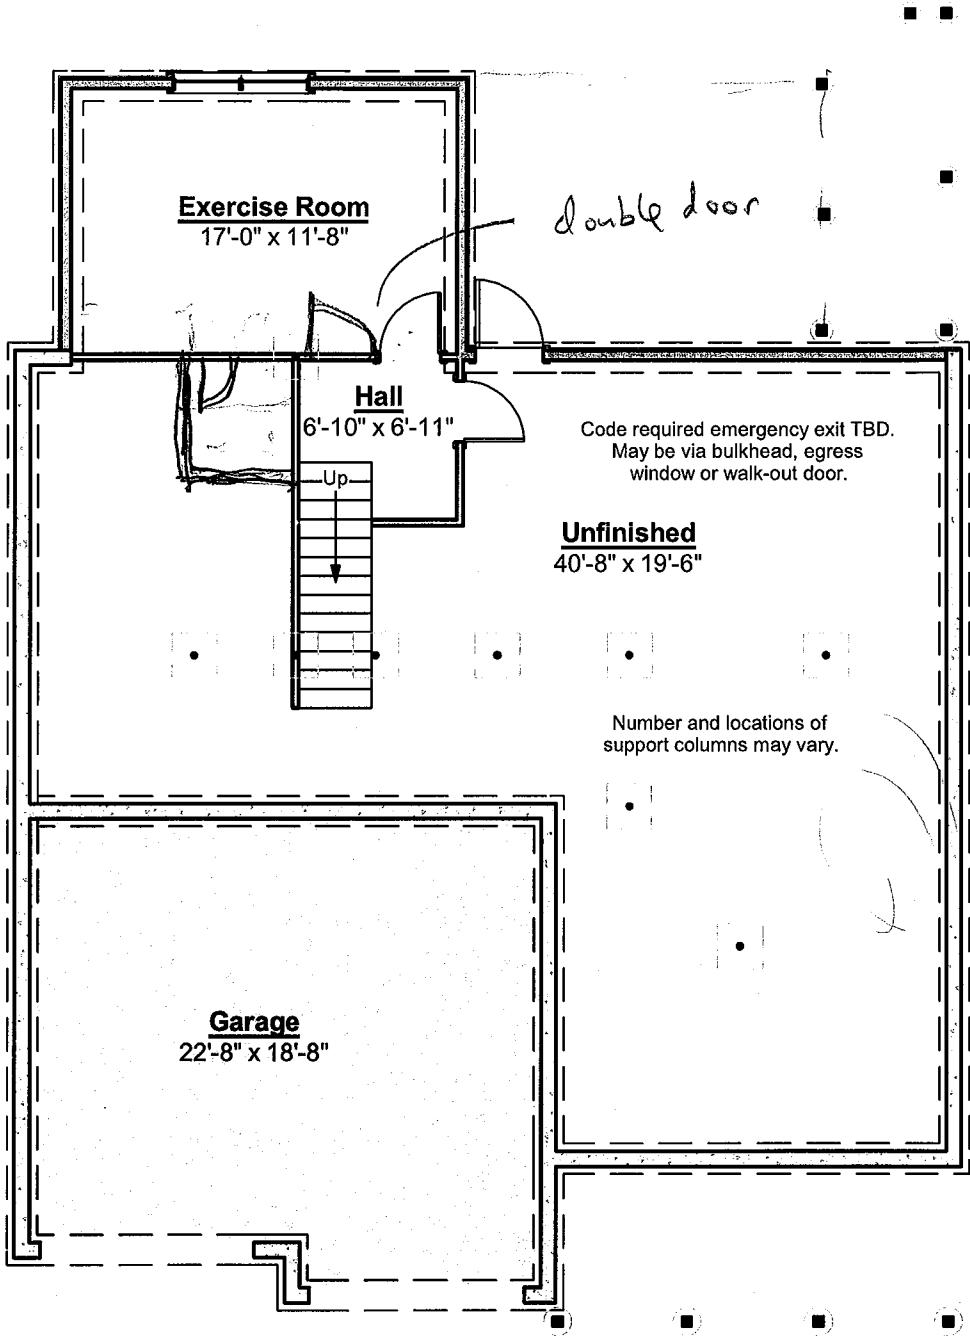

Lower Level