



Artform Home Plans
Art Form Architecture

HOLLY GLEN

BURLINGTON


"The World at Your Door"



S Y M E S

First Floor

40'-0"

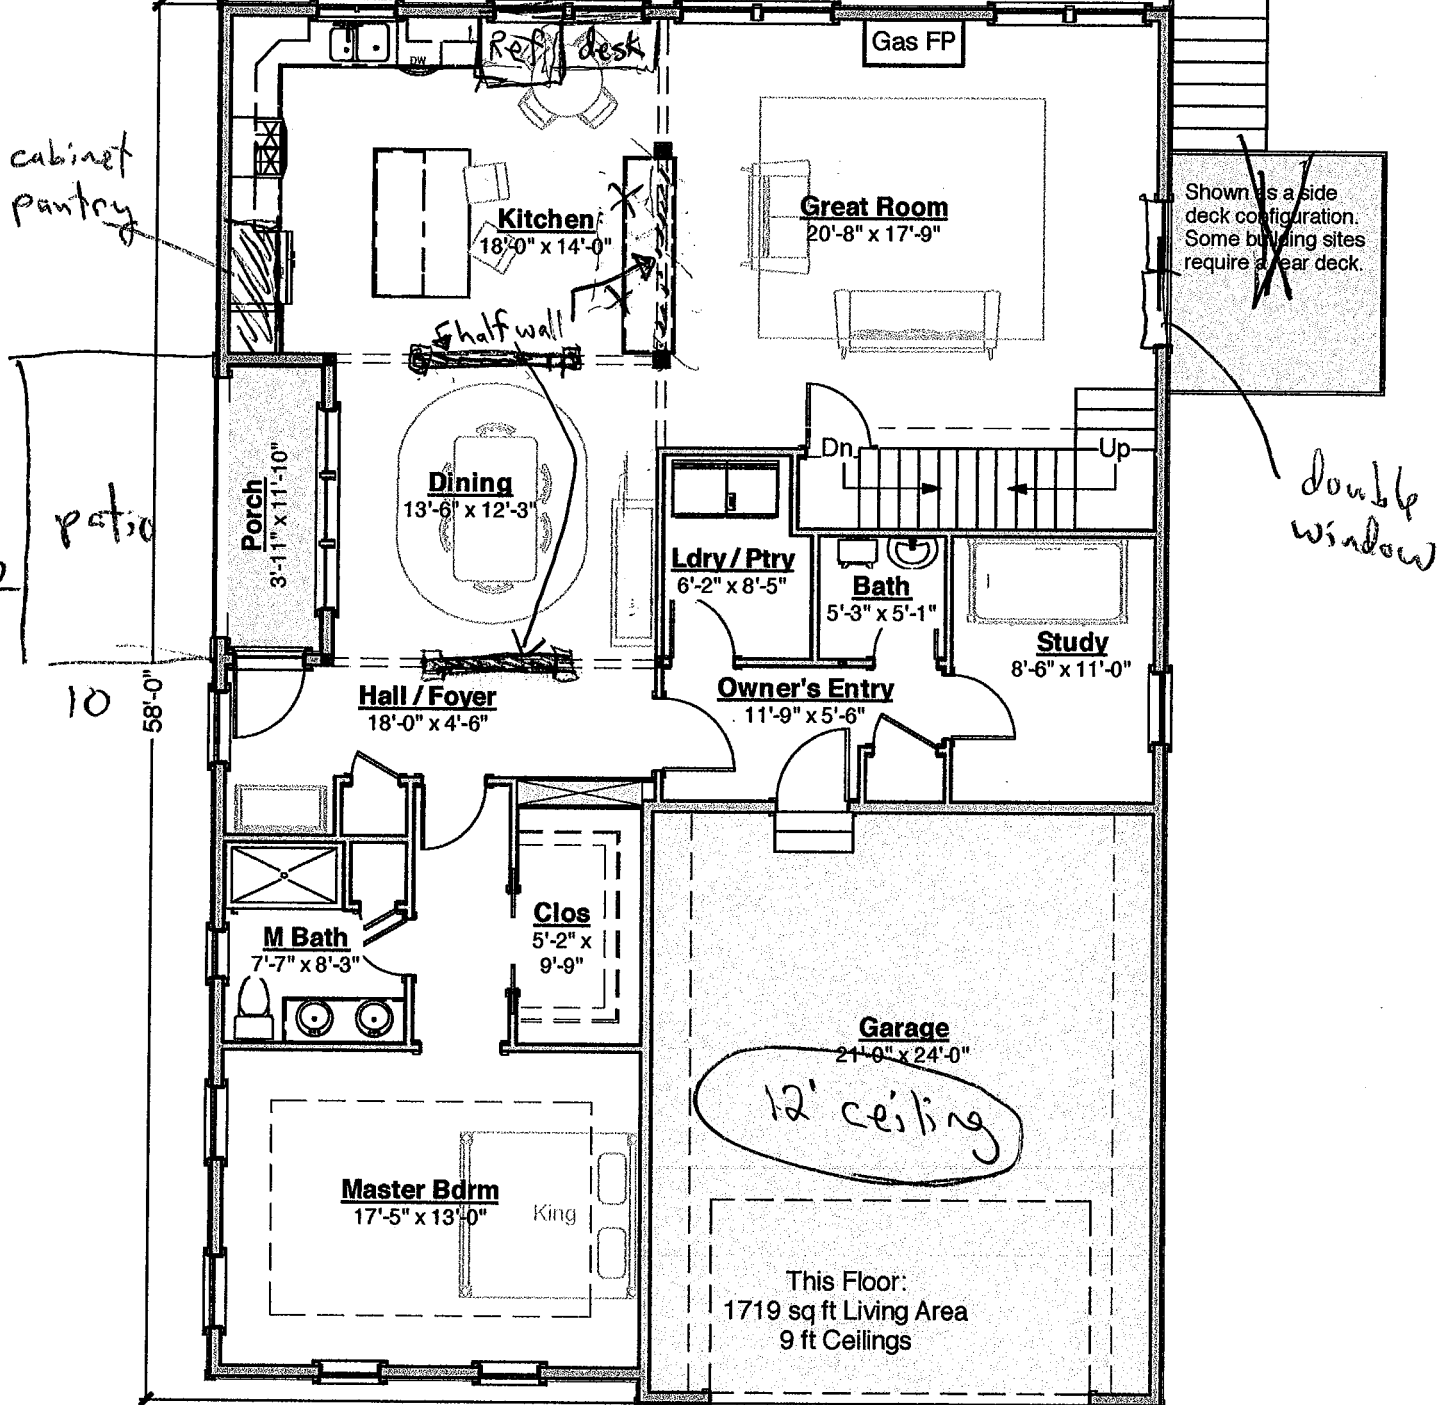

Some items shown in 3D views are optional or to be provided by homeowner. Interior views are shown to describe the spaces. Interior trim, paint colors and other interior features may vary. Walk-out basement option not available on all building sites. Basement windows and slider as shown may not be available on every EUA. See builder's Features & Options for actual specifications.

Second Floor

A third bedroom with on-suite bath fits easily in the Study/Loft area.

Floor Plan

