


Garnet Premier

384.129.v22 GR (10/16/2020)

© 2011-2020 Art Form Architecture, Inc., all rights reserved. You may not build this design without purchasing a license, even if you make changes. This design may have geographic restrictions.

Artform Home Plans

603-431-9559

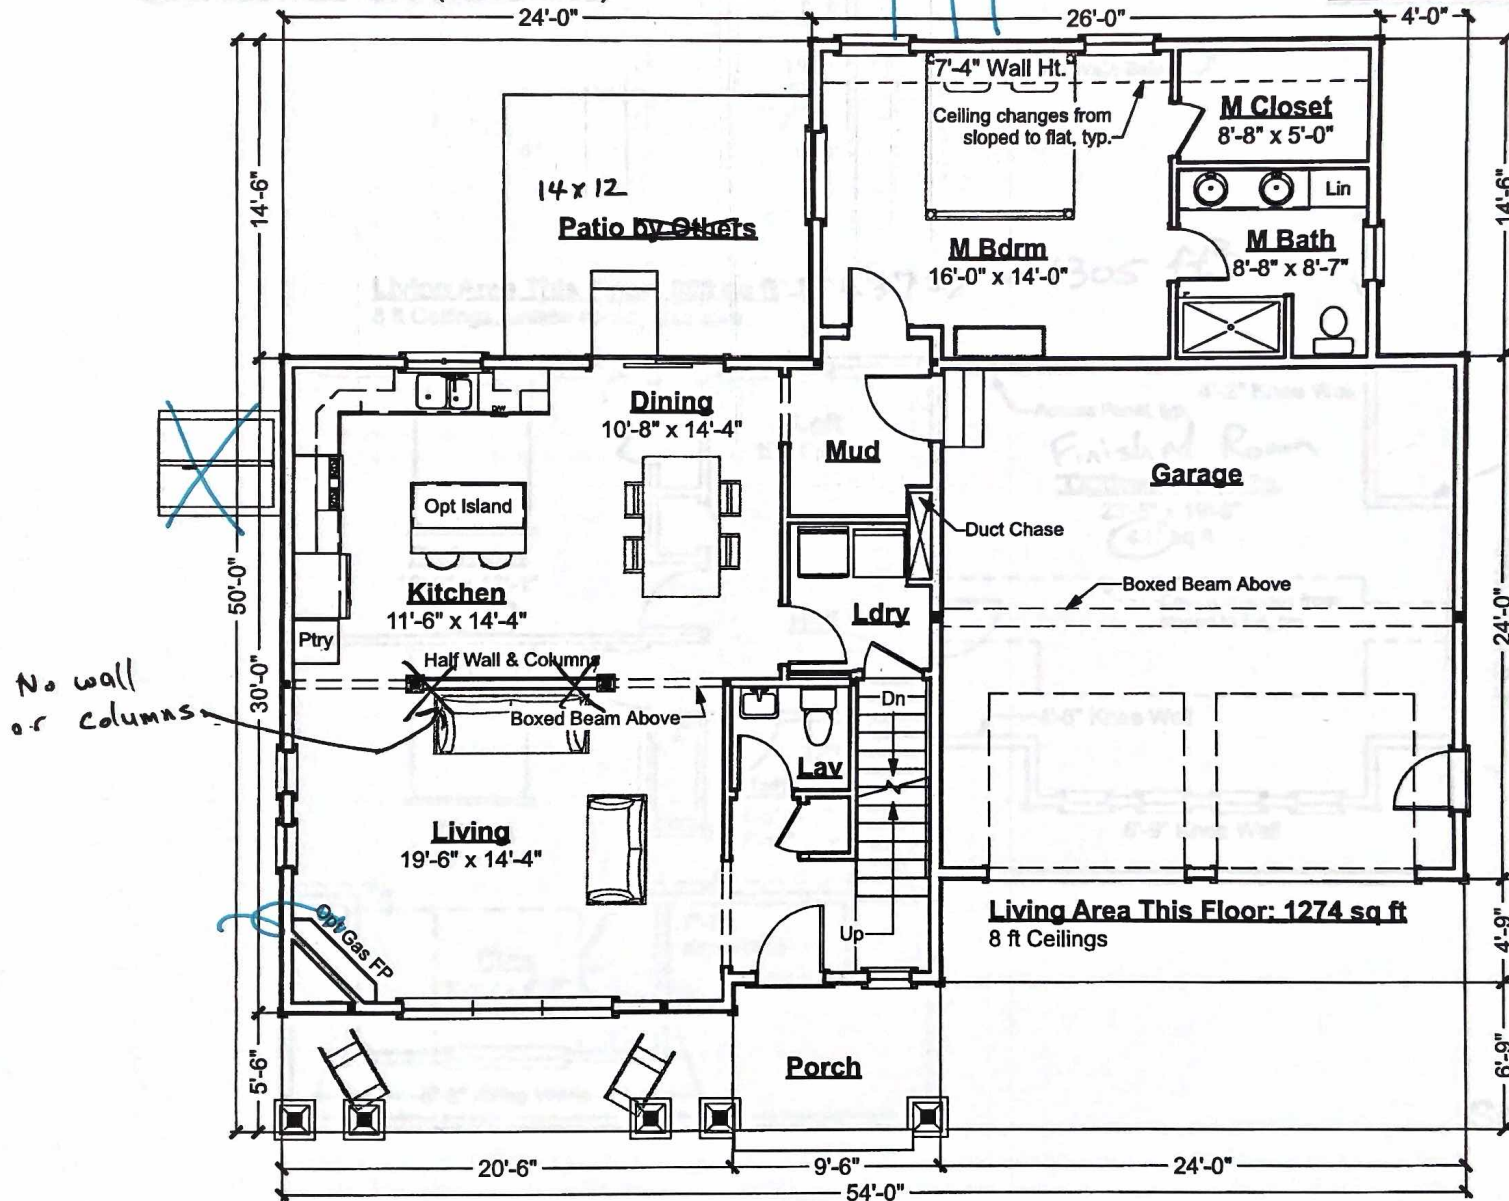


First Floor Plan
Scale: 3/32" = 1'-0"

Garnet Premier

384.129.v22 GR (10/16/2020)

© 2011-2020 Art Form Architecture, Inc., all rights reserved. You may not build this design without purchasing a license, even if you make changes. This design may have geographic restrictions.

Artform Home Plans
603-431-9559

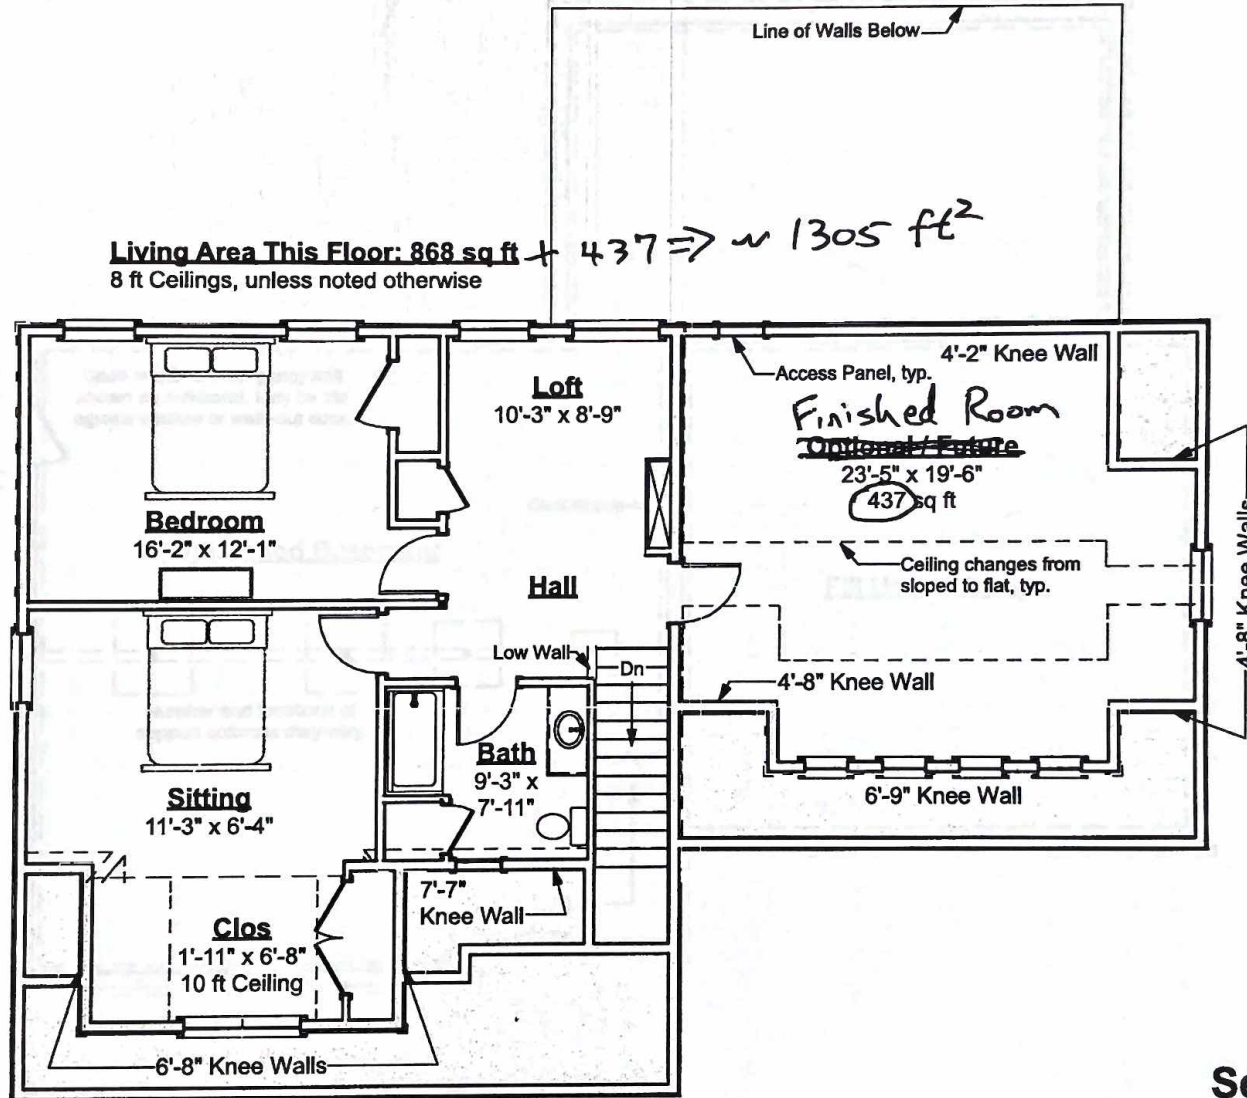

Second Floor Plan

Scale: 3/32" = 1'-0"

Garnet Premier


384.129.v22 GR (10/16/2020)

© 2011-2020 Art Form Architecture, Inc., all rights reserved. You may not build this design without purchasing a license, even if you make changes. This design may have geographic restrictions.



Artform Home Plans

603-431-9559

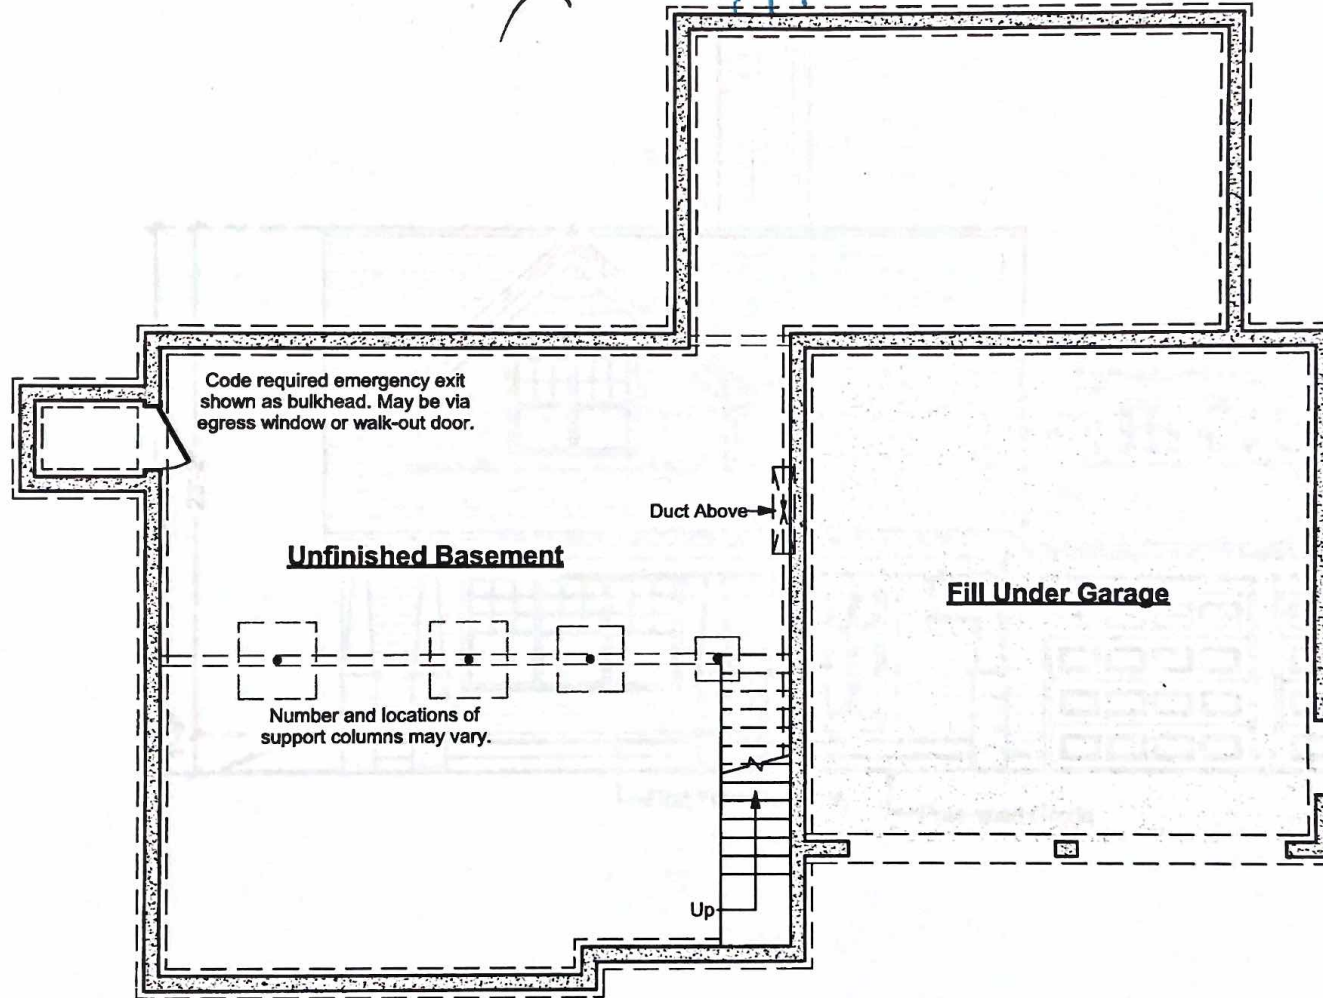

Foundation Plan

Scale: 3/32" = 1'-0"