


Some features shown are optional. Your contract with your builder governs.

Shorter
to 12"
Eaves

Eucalyptus is
This version
cost.

Shorter
to Standard
Eave

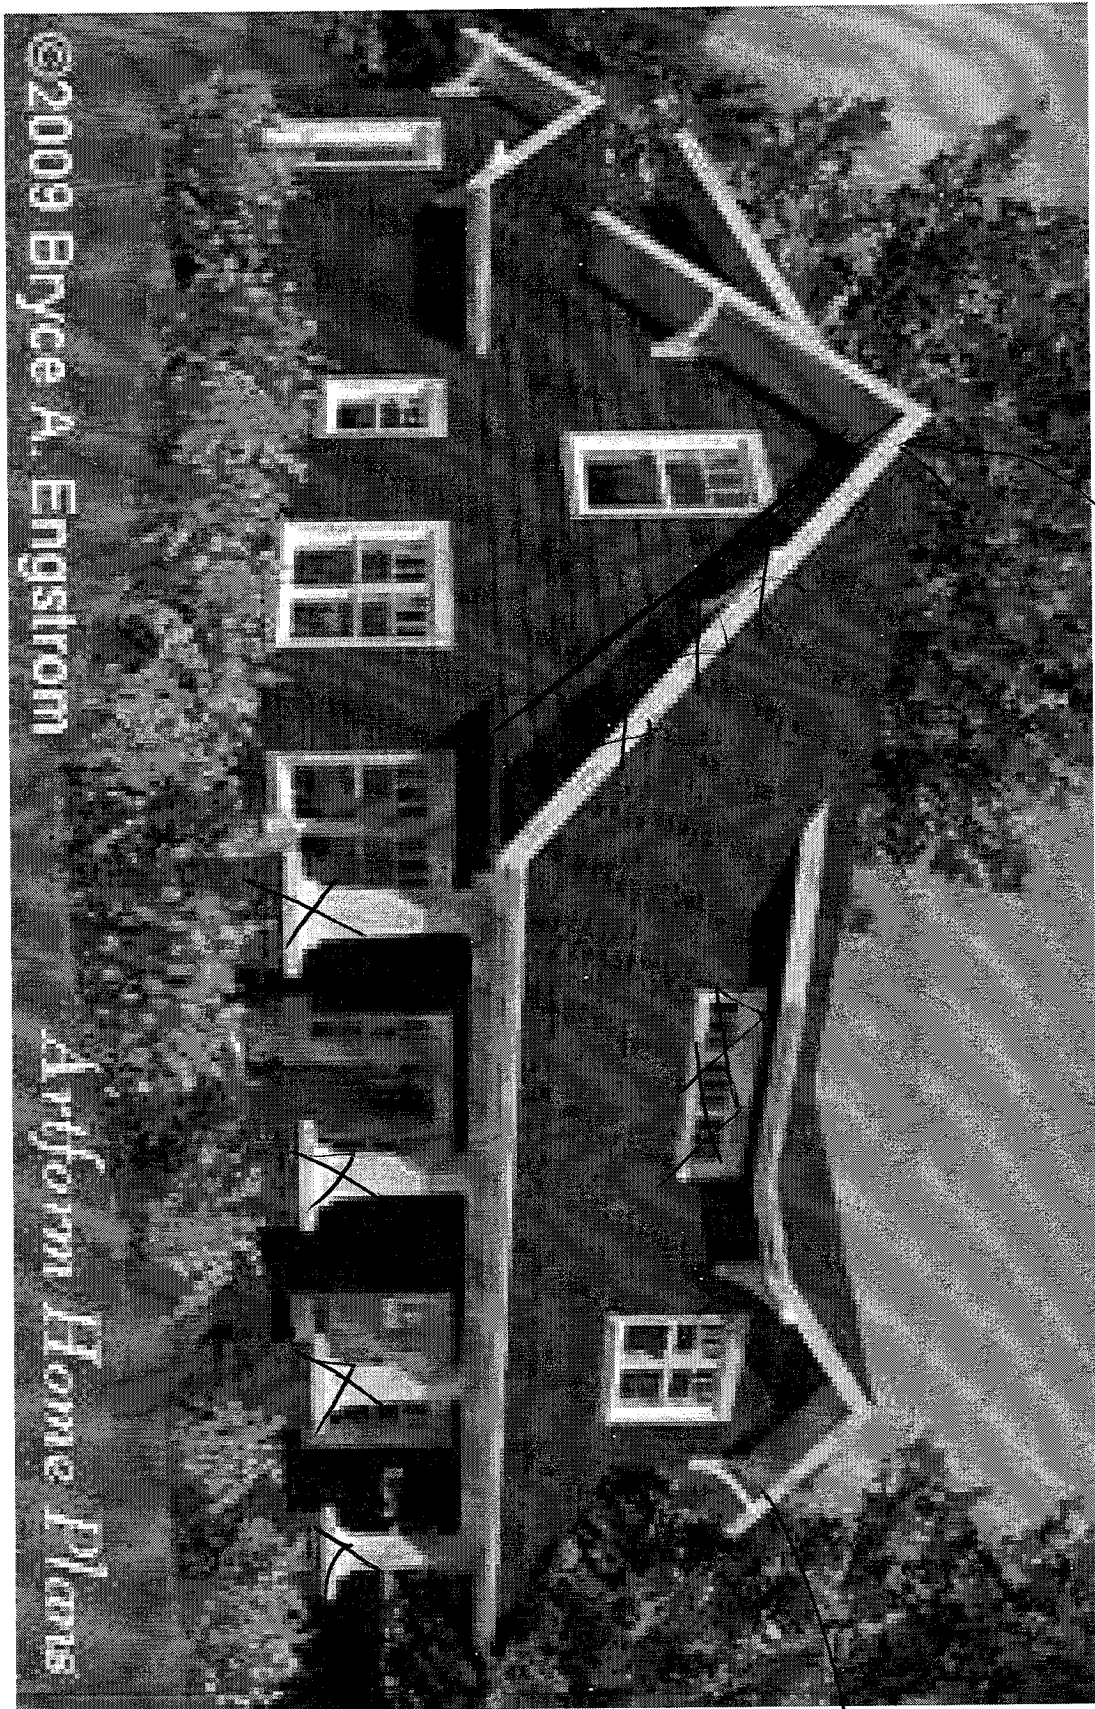

©2009 Bryce A. Engstrom

Ariform Home Plans

Living Area Bedrooms Bathrooms Ceiling Height Shown Ceiling Height Possible*

First Floor

