Top Row = Original Designs from Wendy
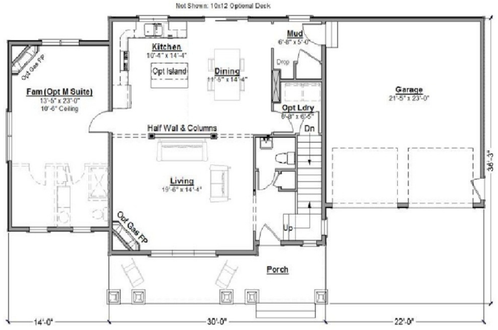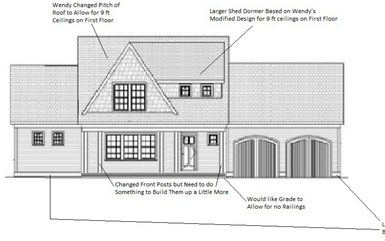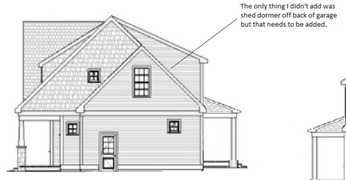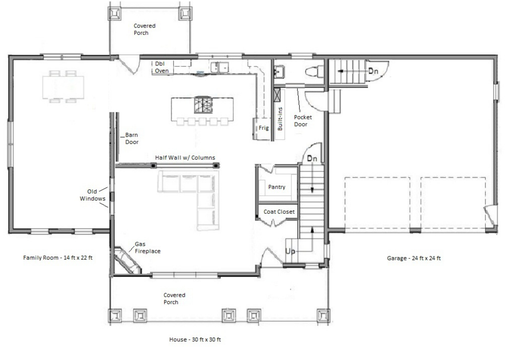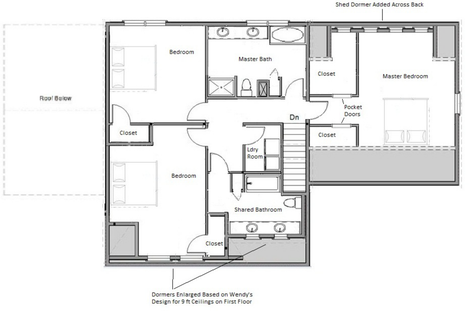
Bottom Row = Our Modified Designs