Artform Home Plans

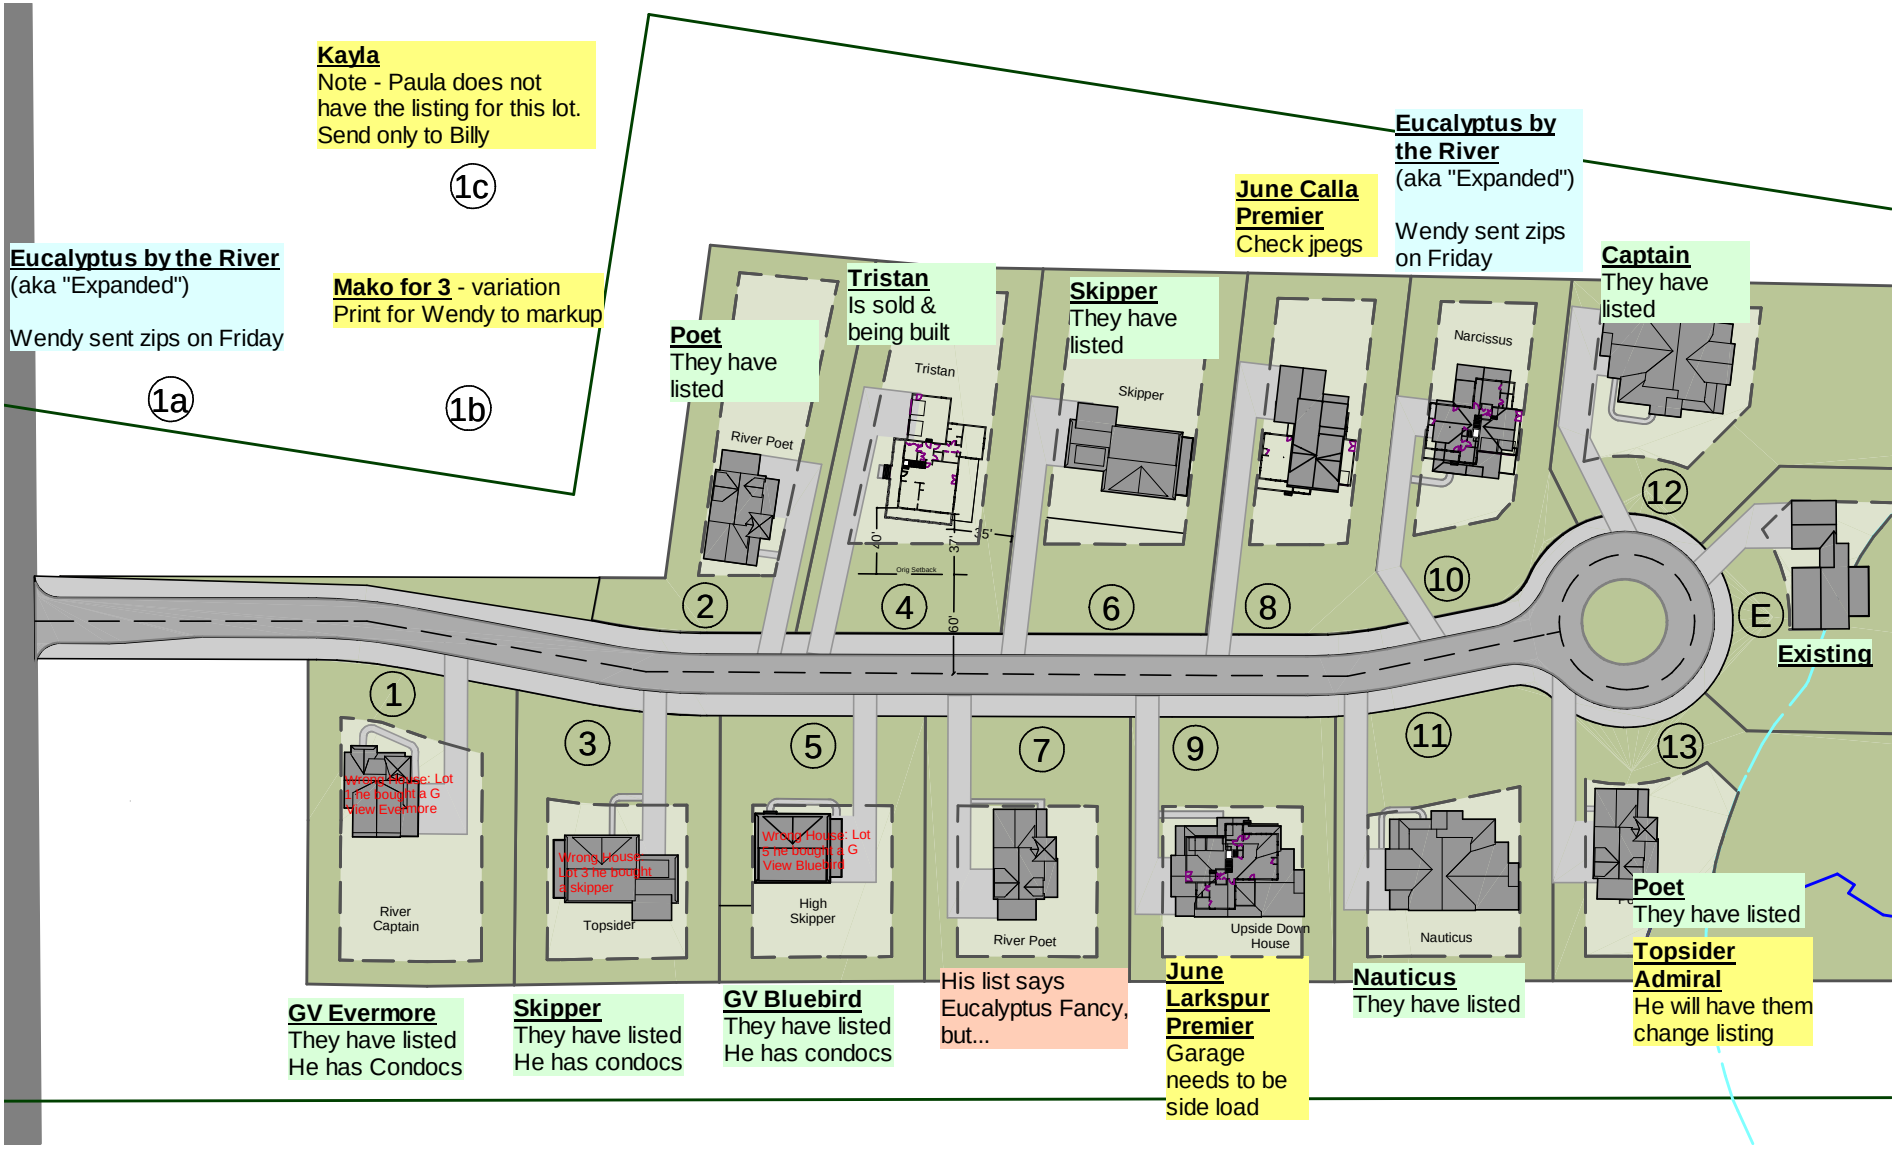


**Kayla**
Note - Paula does not have the listing for this lot. Send only to Billy

**Eucalyptus by the River**
(aka "Expanded")

Wendy sent zips on Friday

**Mako for 3** - variation
Print for Wendy to markup

**Poet**
They have listed

**Tristan**
Is sold & being built

**Skipper**
They have listed

**June Calla Premier**
Check jpegs

**Eucalyptus by the River**
(aka "Expanded")

Wendy sent zips on Friday

**Captain**
They have listed

**Poet**
They have listed

**Topsider Admiral**
He will have them change listing

**GV Evermore**
They have listed
He has Condocs

**Skipper**
They have listed
He has condocs

**GV Bluebird**
They have listed
He has condocs

His list says Eucalyptus Fancy, but...

**June Larkspur Premier**
Garage needs to be side load

**Nauticus**
They have listed