


extend back wall 18"

wrap porch

entry

15x20'



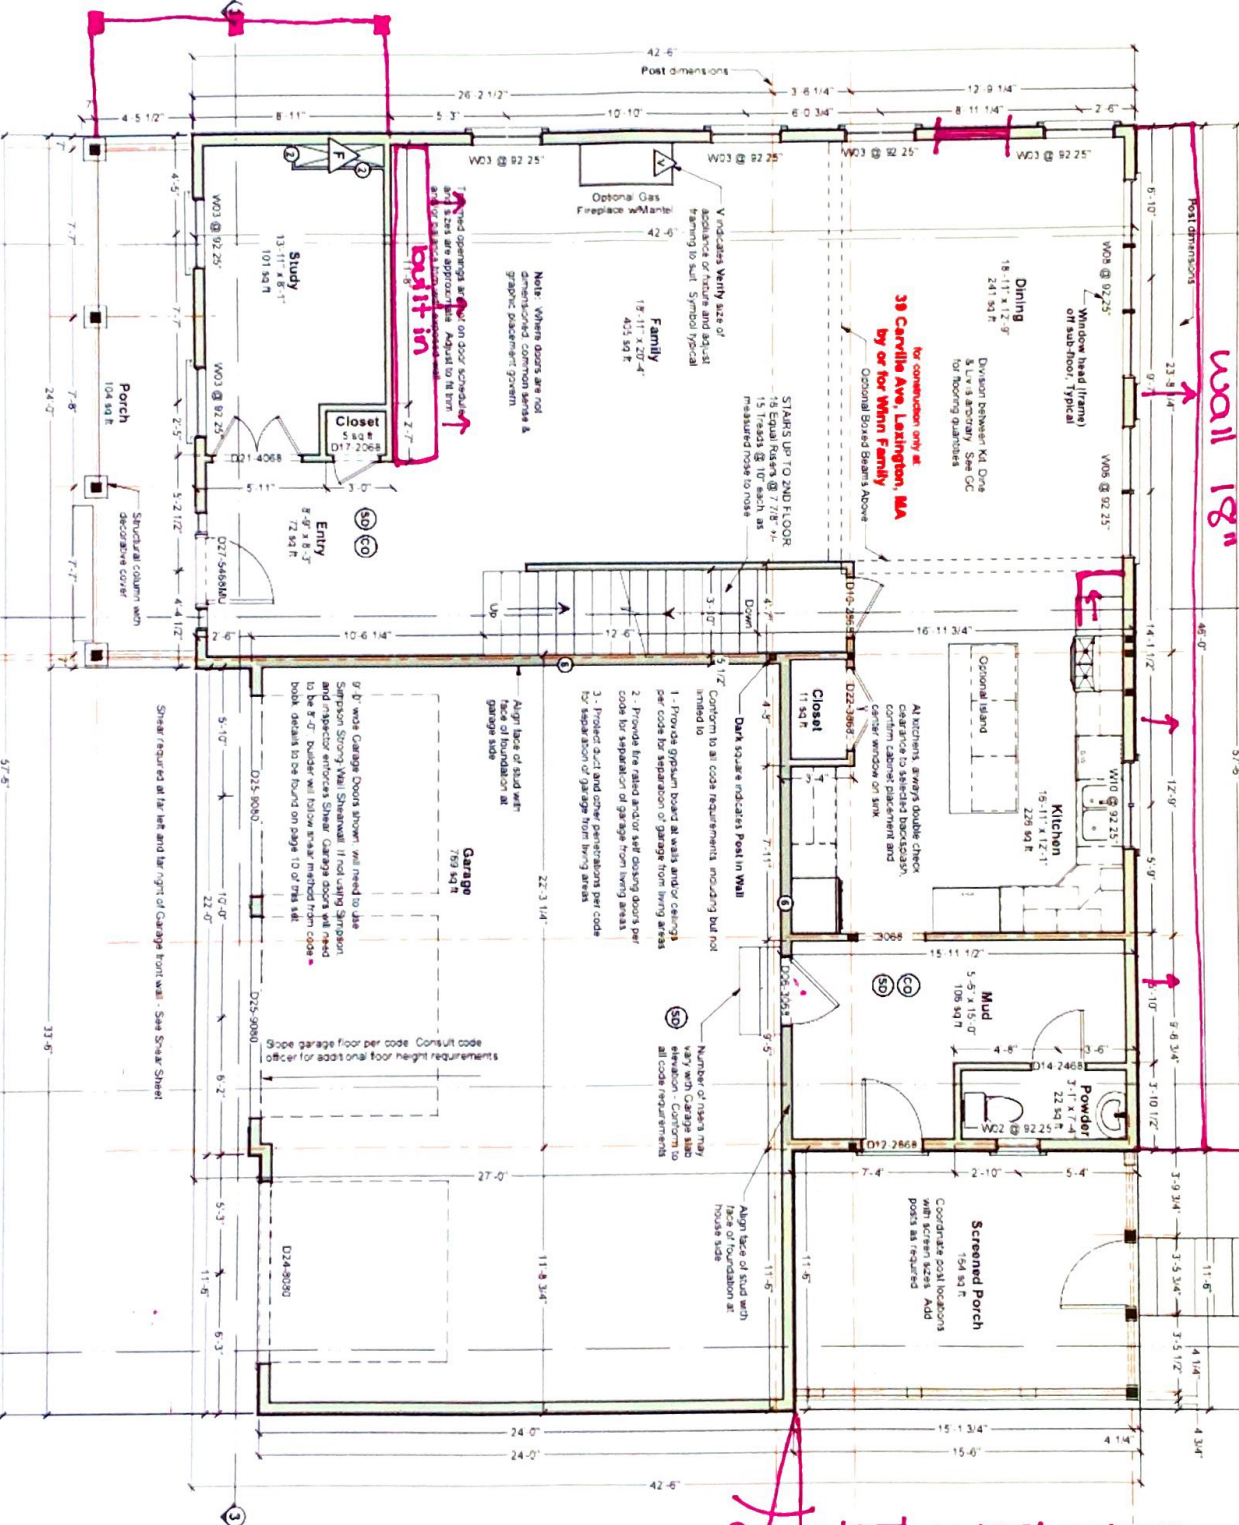

First Floor Plan
Living Area First Floor: 1371 SF

*mirror image plan

extend wall 18"

2

V indicates Verify size of
appliance or fixture and adjust
fitting to suit. Symbol typical


--

68 50 ft
B-1" x 8'-1

203

D.

1668

— 24.0 —

!

Second Floor Plan

Living Area Second Floor: 1900 SF

Line of wall below