



Artform Home Plans

2.2.2

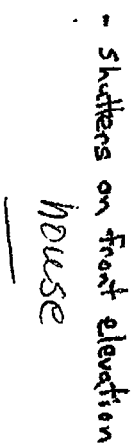

410.001

Second Floor

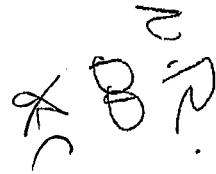

~~Not Sturdy Dining Room~~

Artform Home Plans

07/22/2013

Great Scott Cape 410.001

© 2013 Wendy Welton, all rights reserved. You may not build this design without purchasing a license, even with changes. Some Artform designs have geographic restrictions. Contact the Builder or RE Agent or call Artform at 803-431-9559

Artform Home Plans

Lower Level

