


Remove columns and half wall - Hang down beam

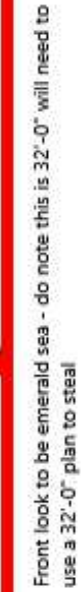

Living Area this Floor: 1298 sq. ft.
8 ft Finished Ceiling Height, unless noted otherwise



Living Area this Floor: 1057 sq ft
8ft Finished Ceiling Height