

erry Crisp


1. REMOVE DOOR
Rough FRAME only

R1: 8.19.14 - Decrease Garage size

We would like to have additional space beneath the window for furniture placement. Our view was to replace the existing windows with similar but smaller. The minimum space we require is 31-32" from the floor to the window bottom molding. Given that we wish to keep the design and "feel" the same as what exists, want to keep the top of the windows the same, and we need at least 32" underneath, we calculate a maximum window size of about 47" (You would have to confirm with architect/plan drawing agent). If possible we would like to retain the width, BUT understand it is best to stick with "standard" sizes and thus may not have that luxury (do not want custom windows).

Lot #5 (Armstrong) Master Bedroom – Back window size and placement change (viewed from inside the master bedroom)

Window
molding →

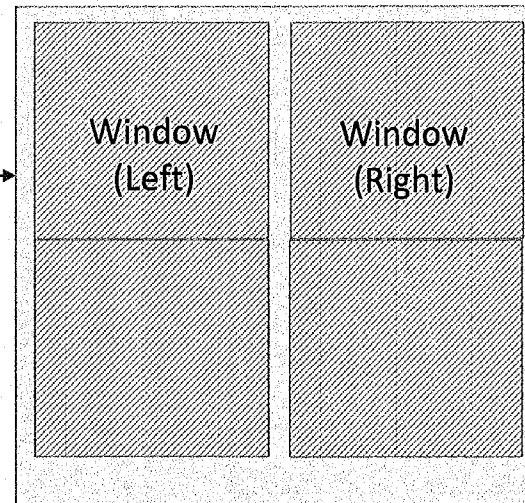

8 1/8" Current height

32" minimum space from
frame to floor