

# 418.124.v4 KR Sweet Peekaboo

## First Floor


	Area	Beds	Baths
Main	838 SF	0	0.5
Future	0 SF	0	0
Apt	0 SF	0	0
Total	838 SF	0	0.5

	Ceiling Height
Shown	8'-0"
Possible*	9'-0"

\* See Major Change information on plan page for cost

London Lot 57

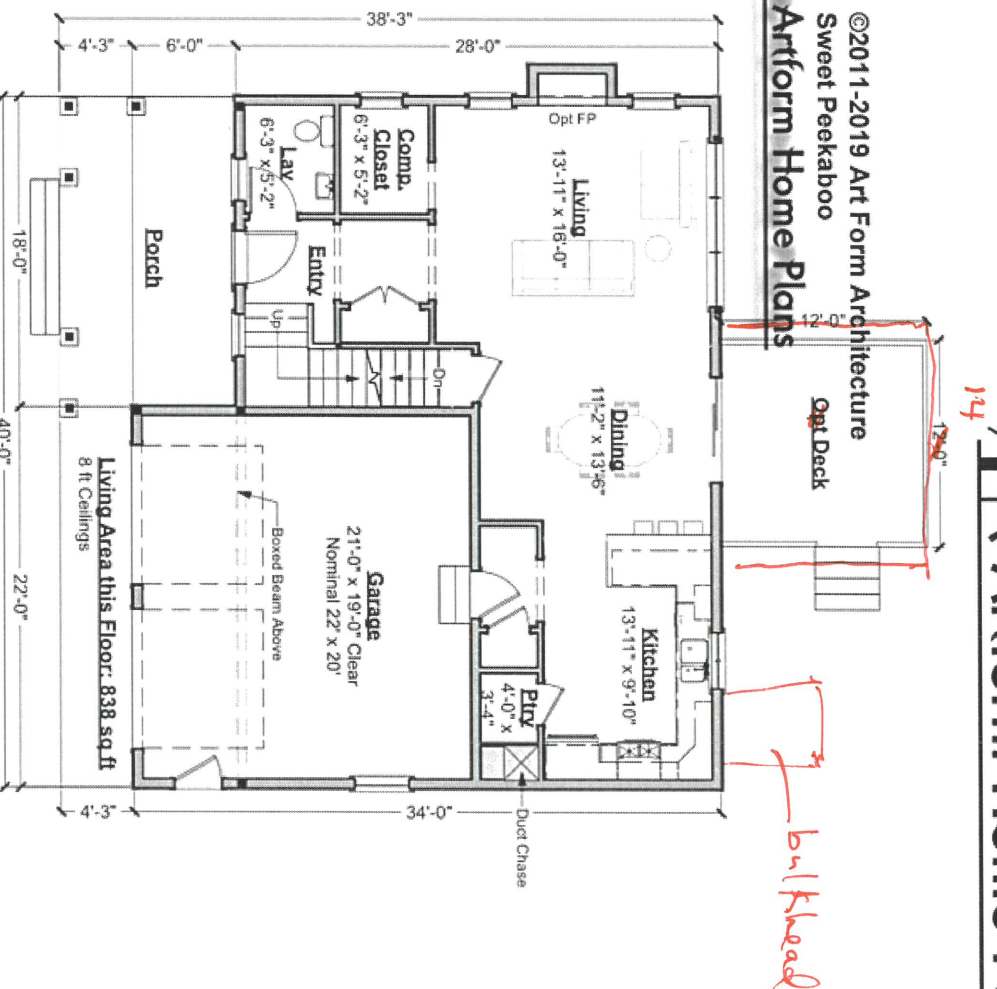


Use of this document is governed by our **Terms and Conditions**, found on our website:  
<http://www.artformhomeplans.com/TermsConditions.a5w>

© 2011 Art Form Architecture, Inc. ALL RIGHTS RESERVED.  
You may not build this Design without purchasing a License to Build (as defined in our Terms). Unauthorized changes are not permitted and violate copyright laws, which provide substantial penalties for infringement.

Some features show are optional. Your Purchase & Sale Agreement governs, whether items are labeled "optional" in this document or not.

We are not responsible for typographical errors.

# 418.124.v4 KR Sweet Peekaboo

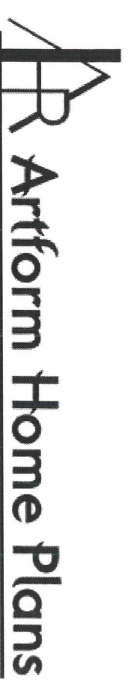

## Second Floor


Area	Beds	Baths
Main	1233 SF	3
Future	0 SF	0
Apt	0 SF	0
Total	1233 SF	3

### Ceiling Height

Shown 8'-0"

Possible\* 8'-0"

\* See Major Change information on plan page for cost

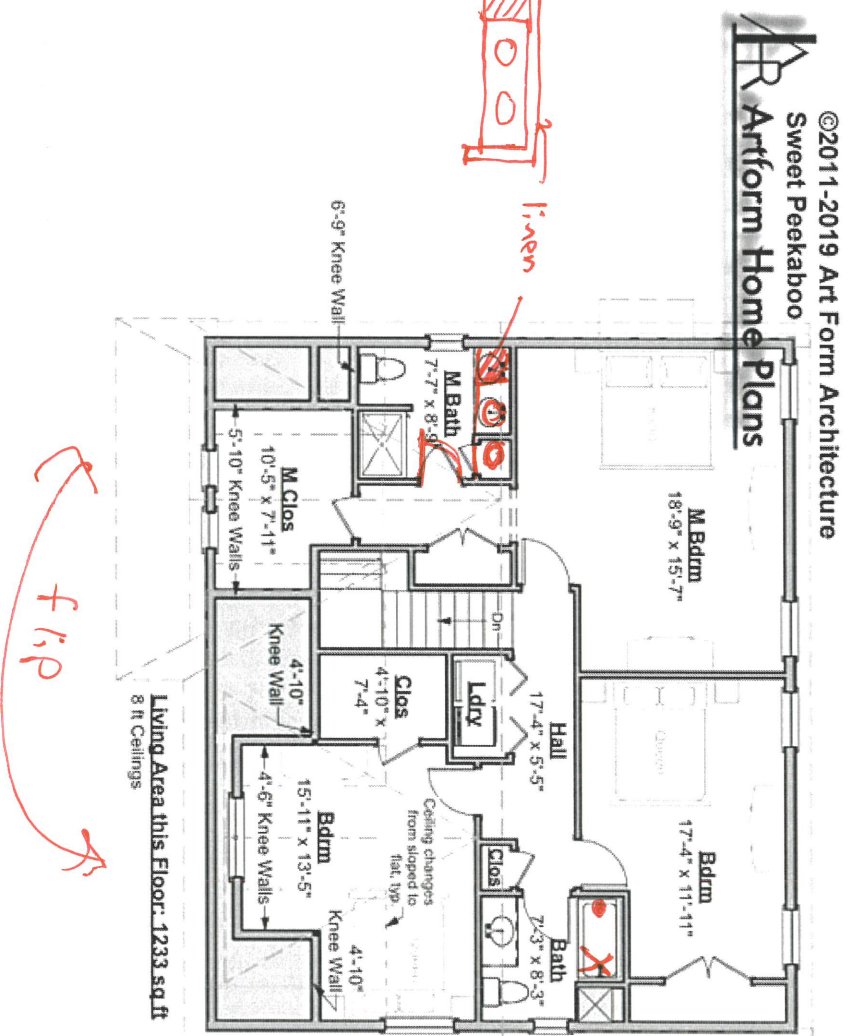

**Use of this document** is governed by our **Terms and Conditions**, found on our website:  
<http://www.artformhomeplans.com/TermsConditions.a5w>

© 2011 Art Form Architecture, Inc. ALL RIGHTS RESERVED.  
You may not build this Design without purchasing a License to Build (as defined in our Terms). Unauthorized changes are not permitted and violate copyright laws, which provide substantial penalties for infringement.

Some features show are optional. Your Purchase & Sale Agreement governs, whether items are labeled "optional" in this document or not.

We are not responsible for typographical errors.


418.124.v4 KR Sweet Peekaboo



Basement Floor

	Area	Beds	Baths
Main	0 SF	0	0
Future	0 SF	0	0
Apt	0 SF	0	0
Total	0 SF	0	0
Ceiling Height			
Shown	7'-8"		
Possible*	9'-0"		

\* See Major Change information on plan page for cost

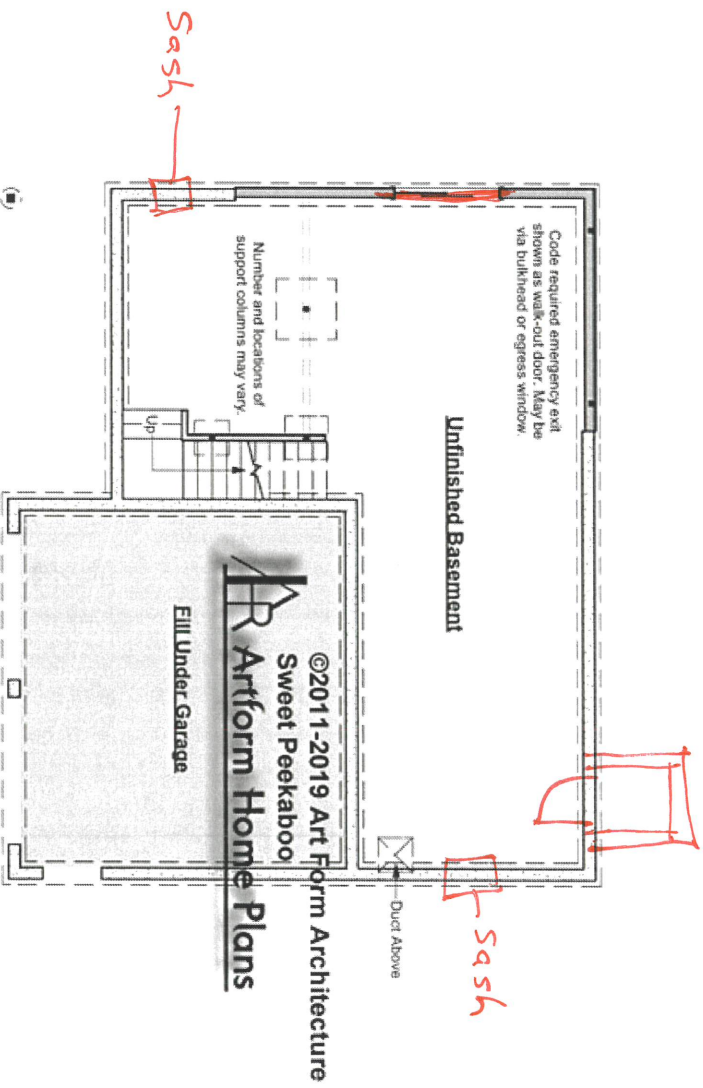


Use of this document is governed by our Terms and Conditions, found on our website:  
<http://www.artformhomeplans.com/TermsConditions.a5w>

© 2011 Art Form Architecture, Inc. ALL RIGHTS RESERVED.  
You may not build this Design without purchasing a License to Build (as defined in our Terms). Unauthorized changes are not permitted and violate copyright laws, which provide substantial penalties for infringement.

Some features show are optional. Your Purchase & Sale Agreement governs, whether items are labeled "optional" in this document or not.  
We are not responsible for typographical errors.

# 418.124.v4 KR Sweet Peekaboo

## Front Elevation

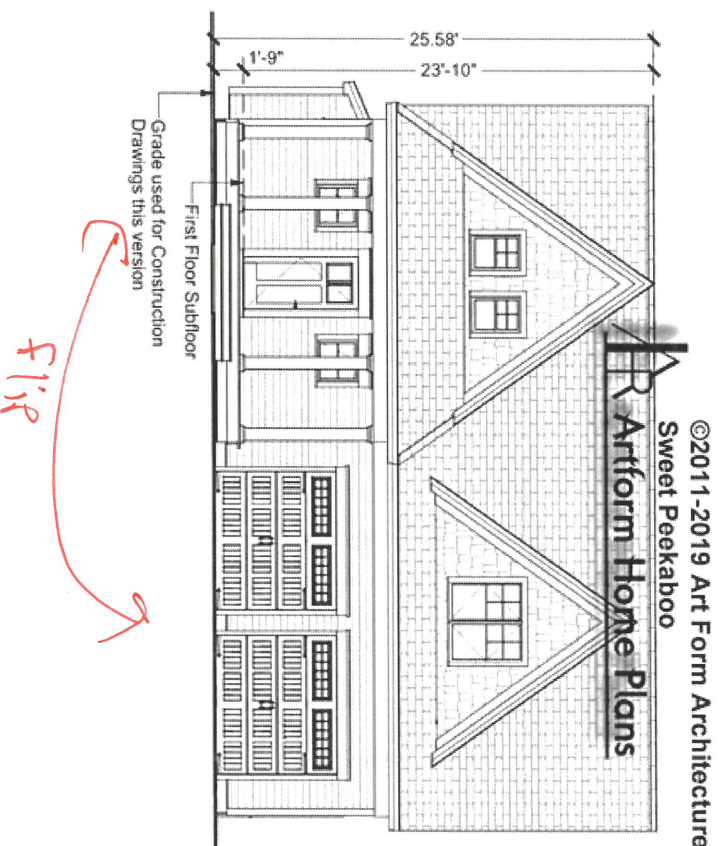

**Use of this document** is governed by our **Terms and Conditions**, found on our website:  
<http://www.artformhomeplans.com/TermsConditions.a5w>

© 2011 Art Form Architecture, Inc. ALL RIGHTS RESERVED.  
You may not build this Design without purchasing a License to Build (as defined in our Terms). Unauthorized changes are not permitted and violate copyright laws, which provide substantial penalties for infringement.


Some features show are optional. Your Purchase & Sale Agreement governs, whether items are labeled "optional" in this document or not.


We are not responsible for typographical errors.



# 418.124.v4 KR Sweet Peekaboo

## Right Elevation

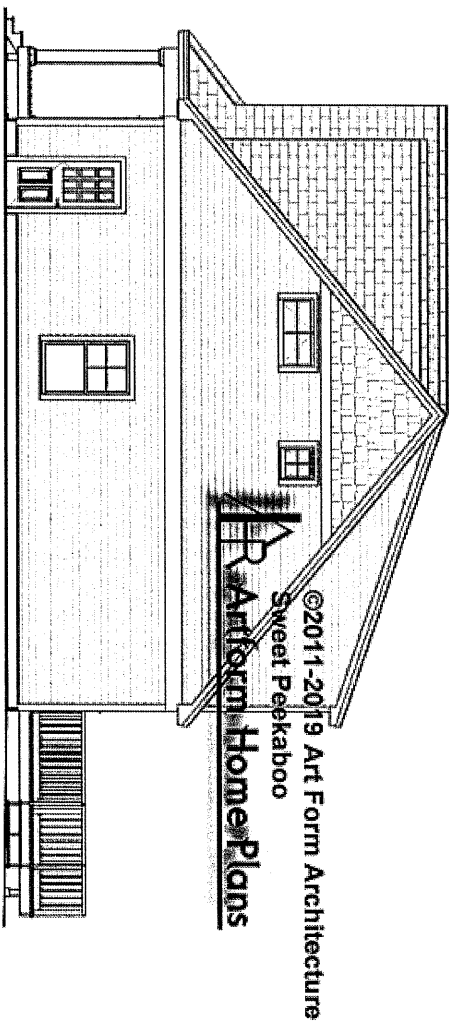

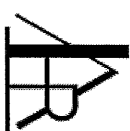 **Artform Home Plans**

**Use of this document** is governed by our **Terms and Conditions**, found on our website:  
<http://www.artformhomeplans.com/TermsConditions.aspx>


© 2011 Art Form Architecture, Inc. ALL RIGHTS RESERVED.  
You may not build this Design without purchasing a License to Build (as defined in our Terms). Unauthorized changes are not permitted and violate copyright laws, which provide substantial penalties for infringement.

Some features show are optional. Your Purchase & Sale Agreement governs, whether items are labeled "optional" in this document or not.

We are not responsible for typographical errors.

# 418.124.v4 KR Sweet Peekaboo

## Rear Elevation

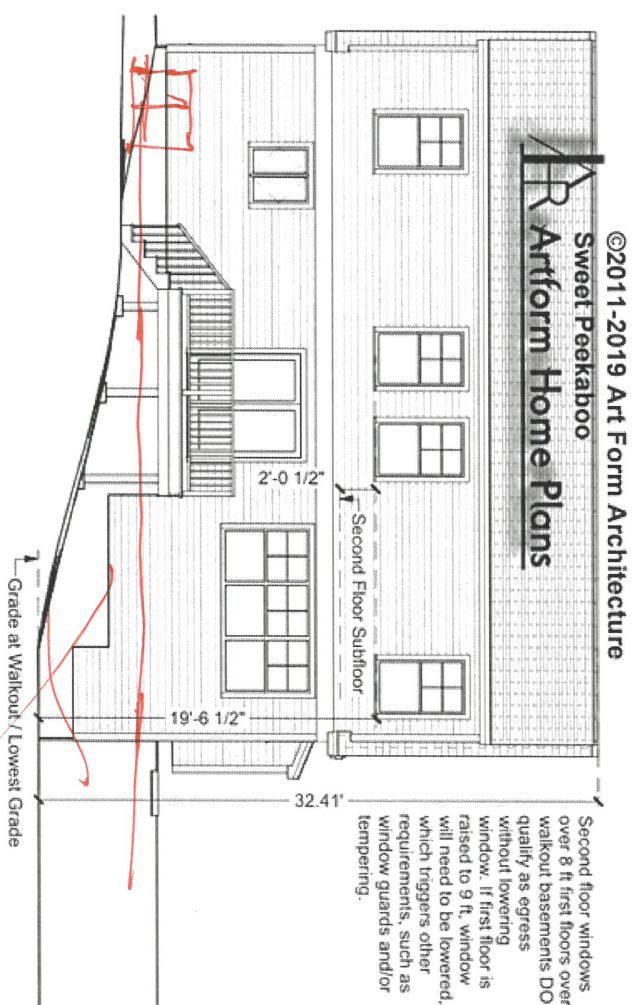

**Use of this document** is governed by our **Terms and Conditions**, found on our website:  
<http://www.artformhomeplans.com/TermsConditions.a5w>


© 2011 Art Form Architecture, Inc. ALL RIGHTS RESERVED.  
You may not build this Design without purchasing a License to Build (as defined in our Terms). Unauthorized changes are not permitted and violate copyright laws, which provide substantial penalties for infringement.

Some features show are optional. Your Purchase & Sale Agreement governs, whether items are labeled "optional" in this document or not.

We are not responsible for typographical errors.

# 418.124.v4 KR Sweet Peekaboo

## Left Elevation

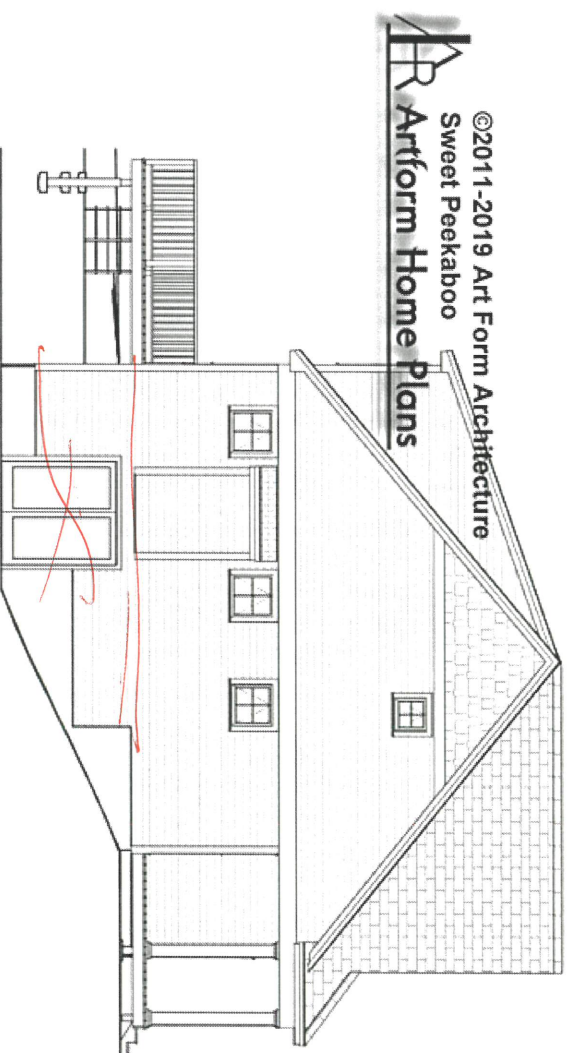

**Use of this document** is governed by our **Terms and Conditions**, found on our website:  
<http://www.artformhomeplans.com/TermsConditions.a5w>

© 2011 Art Form Architecture, Inc. ALL RIGHTS RESERVED.  
You may not build this Design without purchasing a License to Build (as defined in our Terms). Unauthorized changes are not permitted and violate copyright laws, which provide substantial penalties for infringement.

Some features show are optional. Your Purchase & Sale Agreement governs, whether items are labeled "optional" in this document or not.

We are not responsible for typographical errors.