

658.124


© 2014 Wendy Welton, all rights reserved. You may not build this design without purchasing a license, even if you make changes. This design may have geographic restrictions.



Top Side

Artform Home Plans

603-431-9559

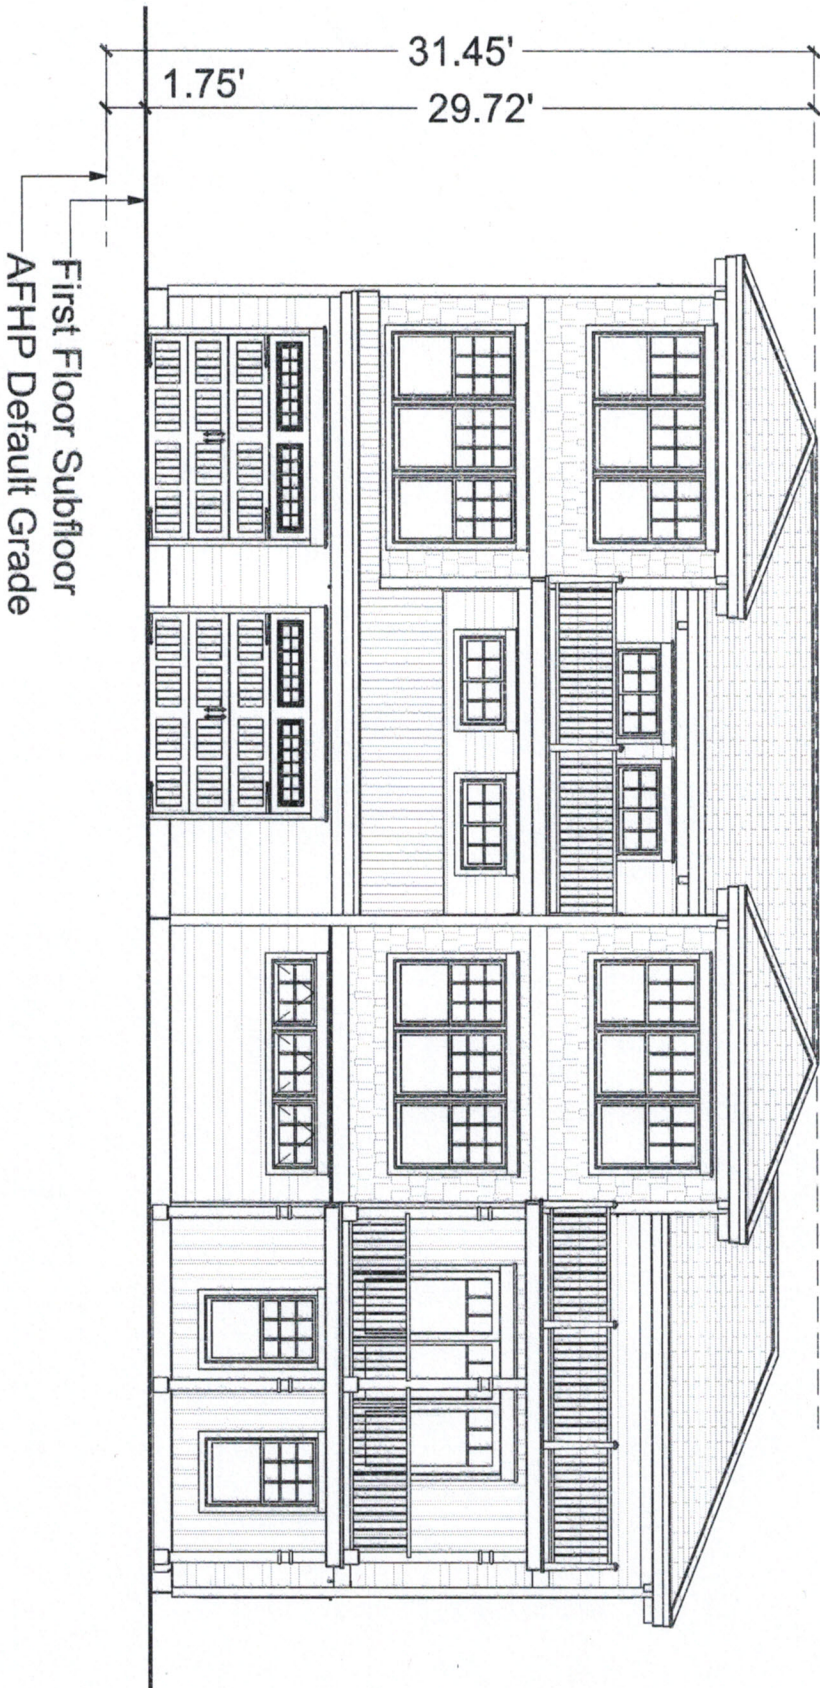


658.124

© 2014 Wendy Welton, all rights reserved . You may not build this design without purchasing a license, even if you make changes. This design may have geographic restrictions.

Artform Home Plans

603-431-9559

LOT E TOP SAIL

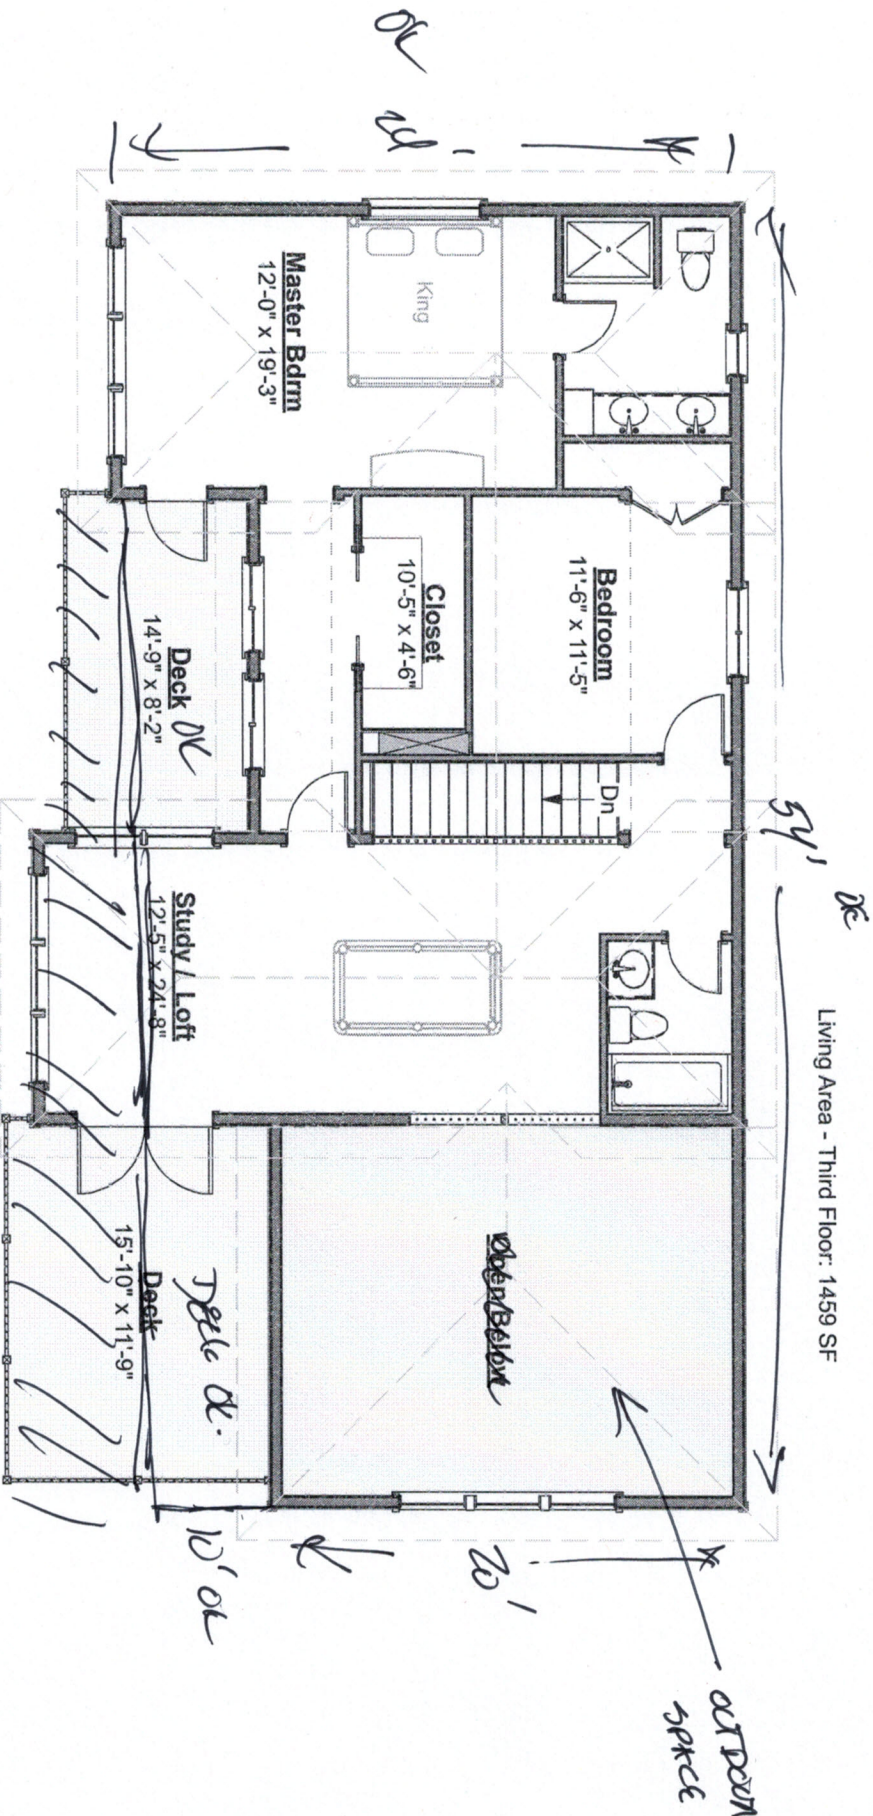

Third Floor Plan

4/17/2014

658.124

© 2014 Wendy Welton, all rights reserved. You may not build this design without purchasing a license, even if you make changes. This design may have geographic restrictions.


Artform Home Plans

603-431-9559

LOVE THE SAIL

VICU

Living Area - Second Floor: 1446 SF

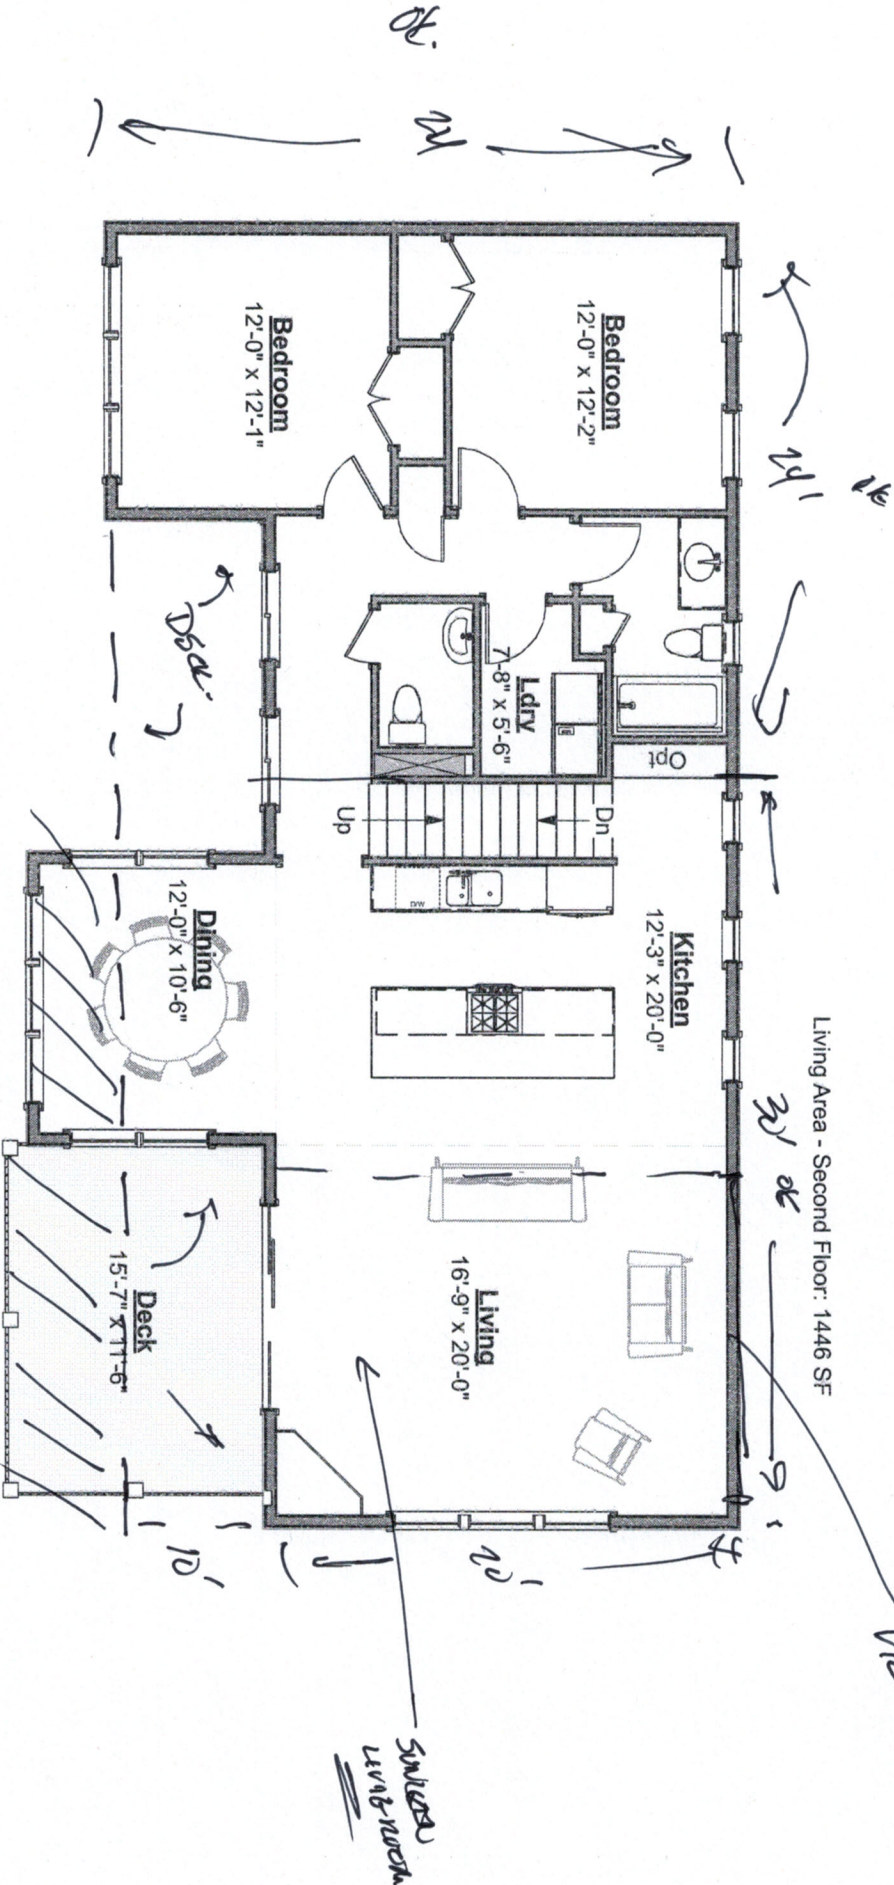

Second Floor Plan

658.124


© 2014 Wendy Welton, all rights reserved . You may not build this design without purchasing a license, even if you make changes. This design may have geographic restrictions.

1st & 2nd story

Artform Home Plans

603-431-9559

Living Area - First Floor: 1551 SF

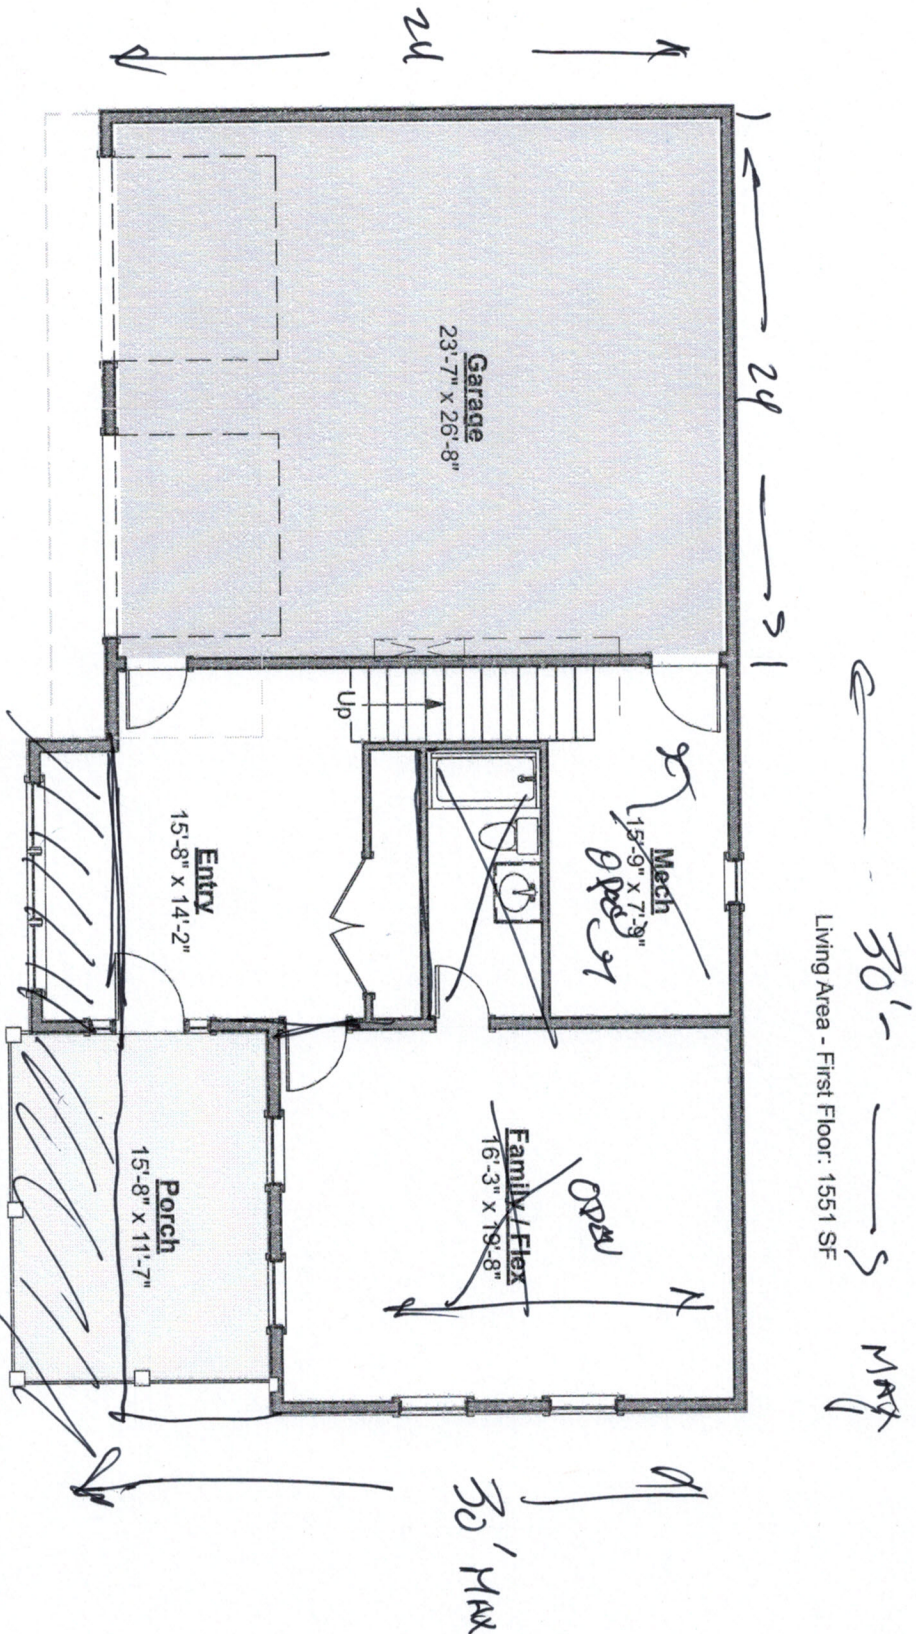

First Floor Plan