


12/16/2015

High Skipper, Expanded

389.120j v.?

© 2011-2015 Art Form Architecture, Inc., all rights reserved .
You may not build this design without purchasing a license,
even if you make changes. This design may have geographic
restrictions.

Artform Home Plans
Work in Progress 603-431-9559

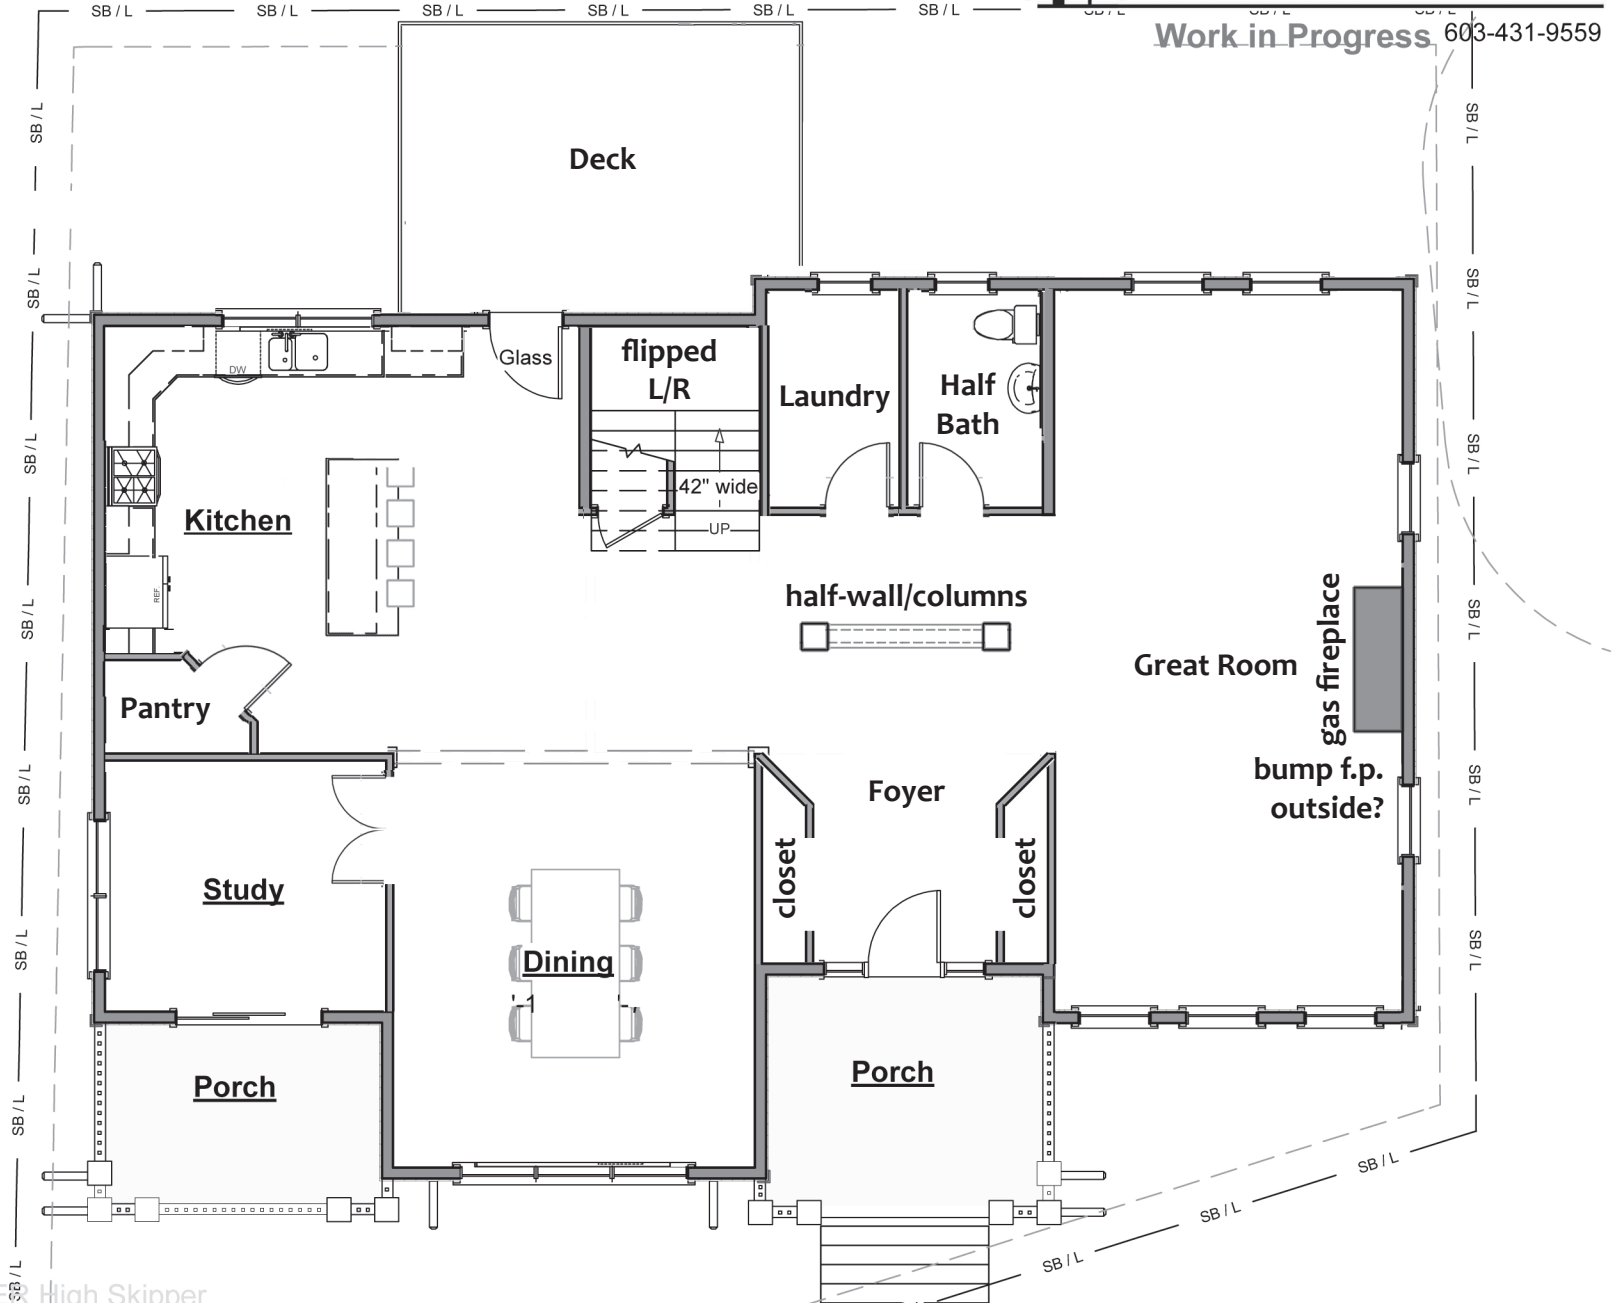



12/16/2015


High Skipper, Expanded

389.120j v.?

© 2011-2015 Art Form Architecture, Inc., all rights reserved .
You may not build this design without purchasing a license,
even if you make changes. This design may have geographic
restrictions.

Artform Home Plans
Prelim / Work in Progress 603-431-9559

Living Area this Floor: 1579 sq ft

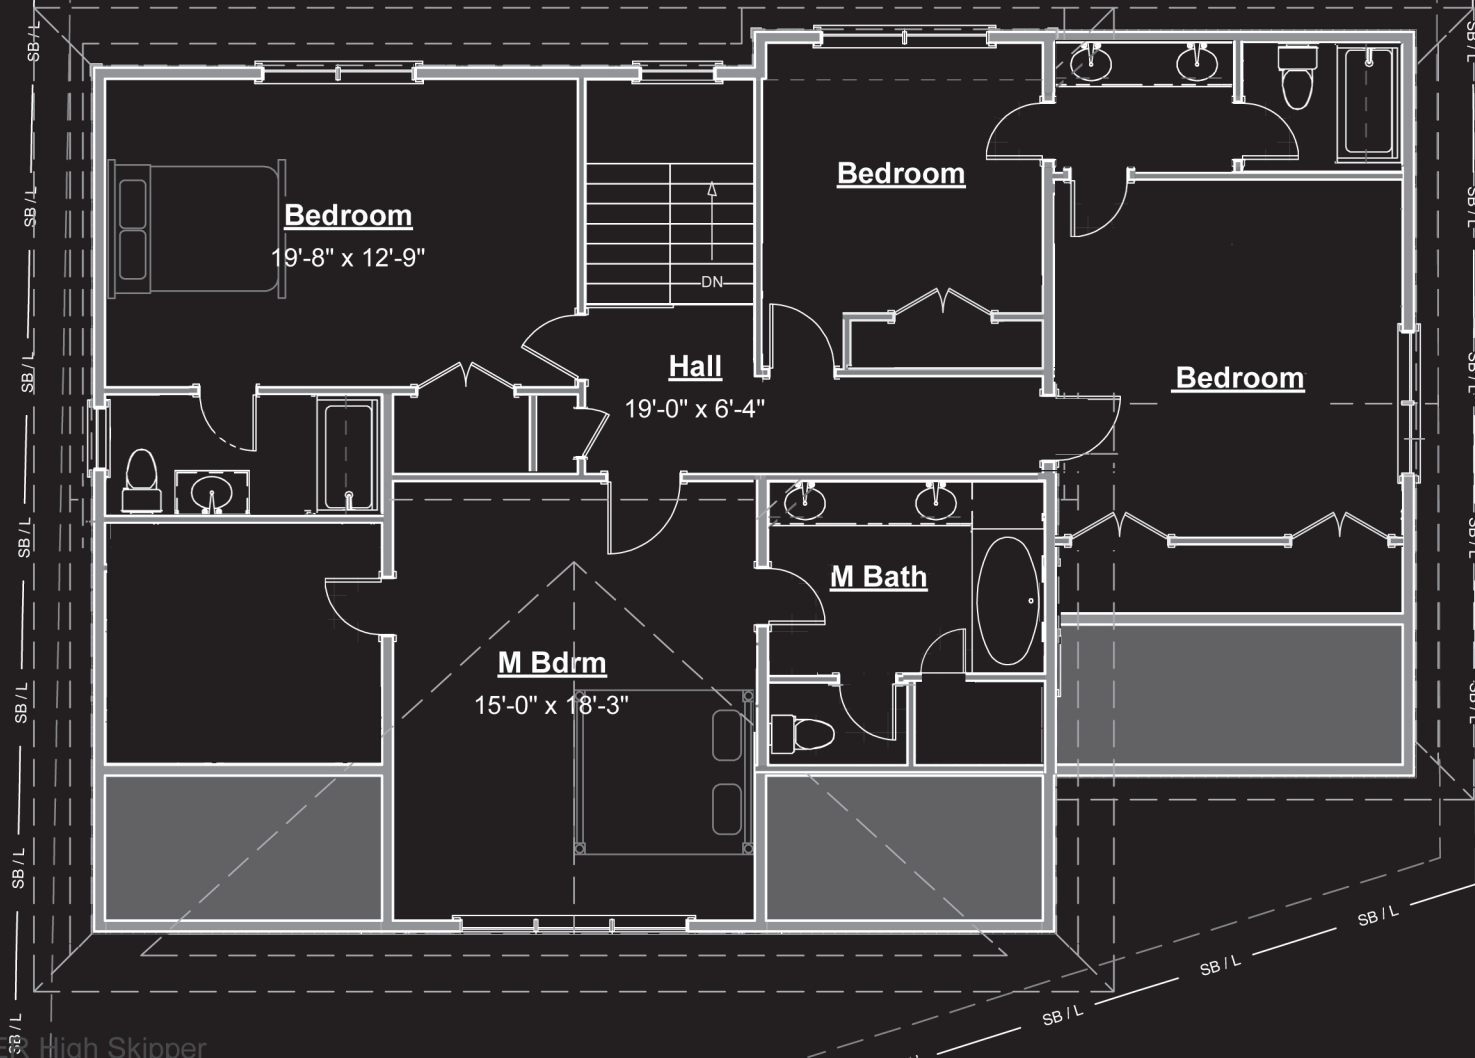

12/16/2015

High Skipper, Expanded

389.120j v.?

© 2011-2015 Art Form Architecture, Inc., all rights reserved .
You may not build this design without purchasing a license,
even if you make changes. This design may have geographic
restrictions.

 **Artform Home Plans**
Prelim / Work in Progress 603-431-9559



12/16/2015

High Skipper, Expanded

389.120j v.?

© 2011-2015 Art Form Architecture, Inc., all rights reserved .
You may not build this design without purchasing a license,
even if you make changes. This design may have geographic
restrictions.

 **Artform Home Plans**
Prelim / Work in Progress 603-431-9559

