


702.140 Boysenberry Biscotti

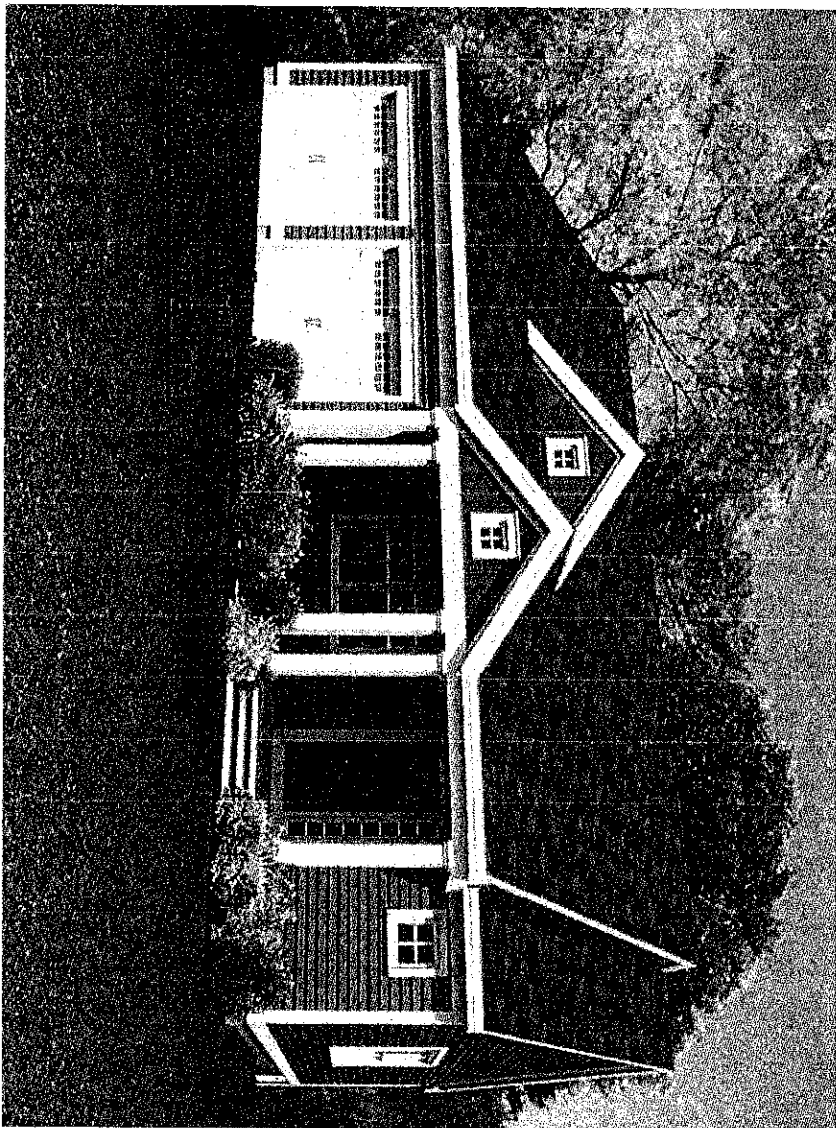

	Main	Future	Apt	Main + Future	Main + Apt	All
Living Area	1604 SF	0 SF	0 SF	1604 SF	1604 SF	1604 SF
Bedrooms	3	0	0	3	3	3
Baths	2.5	0.0	0.0	2.5	2.5	2.5

Use of this document is governed by our **Terms and Conditions**, found on our website:
<http://www.artformhomeplans.com/TermsConditions.aspx>

© 2008 Art Form Architecture, Inc. ALL RIGHTS RESERVED.
 You may not build this Design without purchasing a License to Build (as defined in our Terms). Unauthorized changes are not permitted and violate copyright laws, which provide substantial penalties for infringement.

William Melancon
 6-1-2016
David Melancon
 6-2-2016
 X

Artform Home Plans

Dear Builders and Home Buyers,

In addition to our Terms and Conditions (the "Terms"), please be aware of the following:

This design may not yet have Construction Drawings (as defined in the Terms), and is, therefore, only available as a Design Drawing (as defined in the Terms and together with Construction Drawings, "Drawings"). It is possible that during the conversion of a Design Drawing to a final Construction Drawing, changes may be necessary including, but not limited to, dimensional changes. Please see Plan Data Explained on www.ArtformHomePlans.com to understand room sizes, dimensions and other data provided. We are not responsible for typographical errors.

Artform Home Plans ("Artform") requires that our Drawings be built substantially as designed. Artform will not be obligated by or liable for use of this design with markups as part of any builder agreement. While we attempt to accommodate where possible and reasonable, and where the changes do not denigrate our design, any and all changes to Drawings must be approved in writing by Artform. It is recommended that you have your Drawing updated by Artform prior to attaching any Drawing to any builder agreement. Artform shall not be responsible for the misuse of or unauthorized alterations to any of its Drawings.

Facade Changes:

- To maintain design integrity, we pay particular attention to features on the front facade, including but not limited to door surrounds, window casings, finished porch column sizes, and roof friezes. While we may allow builders to add their own flare to aesthetic elements, we don't allow our designs to be stripped of critical details. Any such alterations require the express written consent of Artform.
- Increasing ceiling heights usually requires adjustments to window sizes and other exterior elements.

Floor plan layout and/or Structural Changes:

- Structural changes always require the express written consent of Artform
- If you wish to move or remove walls or structural elements (such as removal of posts, increases in house size, ceiling height changes, addition of dormers, etc), please do not assume it can be done without other additional changes (even if the builder or lumber yard says you can).

HYBRID BOYSENBERRY / RASPBERRY
BISCOTTI DESIGN.

PEARSON MEADOW - LOT 7


MELANSON RESIDENCE

Super Melan
Rising Melan 6-1-2016

KC

MAY 31, 2016 (PM)

©2008-2015 Art Form Architecture
Boysenberry Biscotti KR
Artform Home Plans

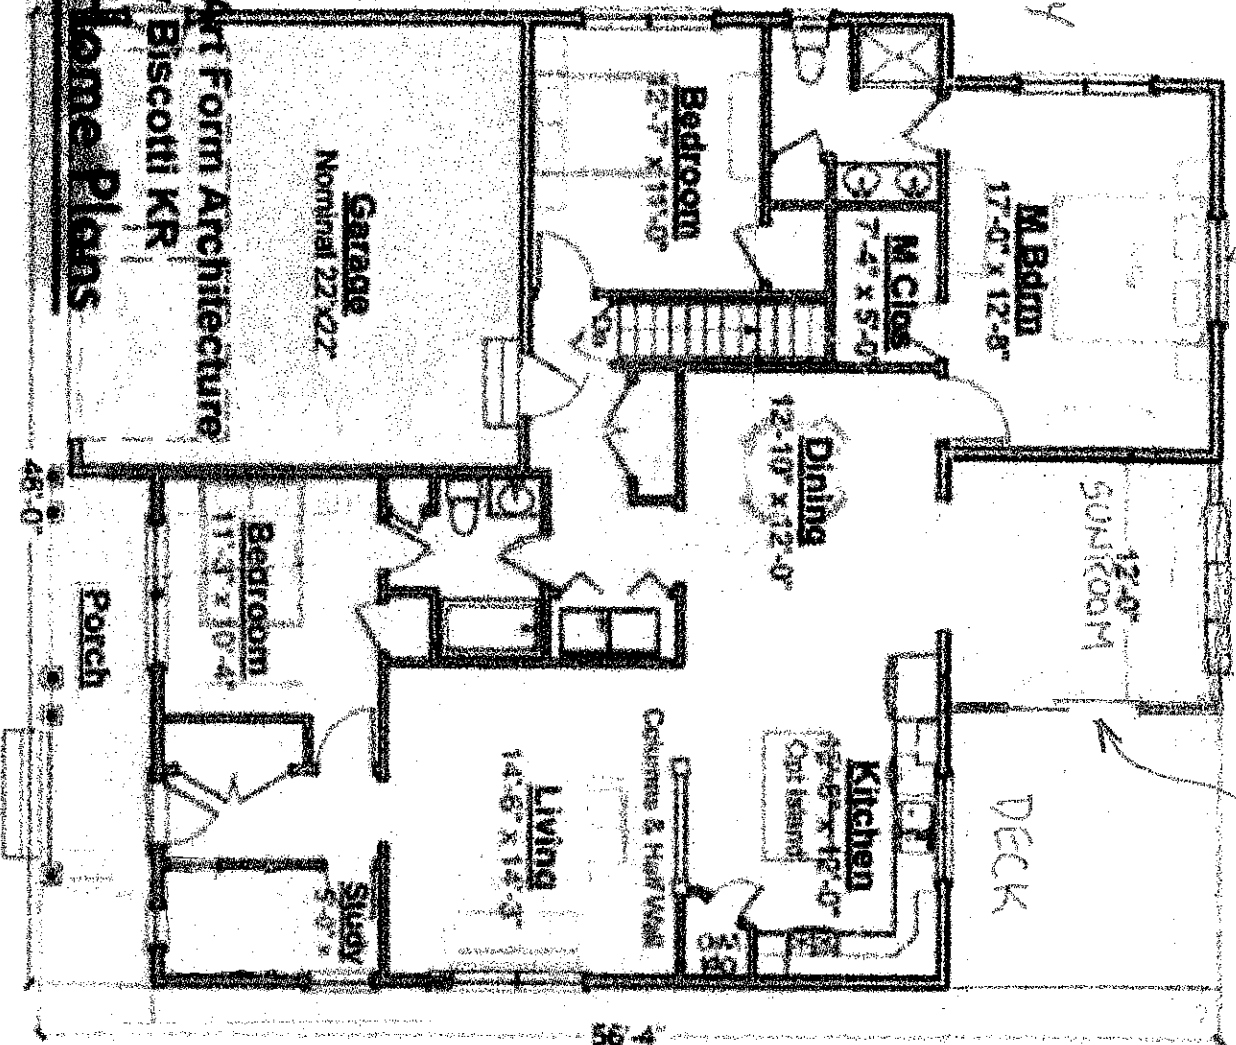

DOUBLE DOOR

702.140 Boysenberry Biscotti

Basement Floor

Area	Beds	Baths
Main 0 SF	0	0
Future 0 SF	0	0
Apt 0 SF	0	0
Total 0 SF	0	0


Ceiling Height

Shown 7'-8"

Possible* 9'-0"

* See Major Change information on plan page for cost

©2008-2015 Art Form Architecture
Boysenberry Biscotti KR
Artform Home Plans

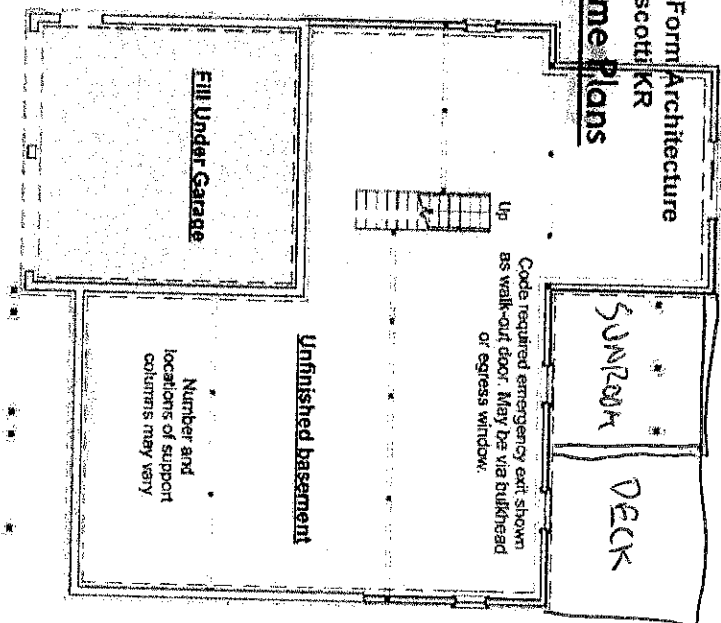

Artform Home Plans

Use of this document is governed by our Terms and Conditions, found on our website:
<http://www.artformhomeplans.com/TermsConditions.aspx>

© 2008 Art Form Architecture, Inc. ALL RIGHTS RESERVED.
You may not build this Design without purchasing a License to Build (as defined in our Terms). Unauthorized changes are not permitted and violate copyright laws, which provide substantial penalties for infringement.

Some features show are optional. Your Purchase & Sale Agreement governs, whether items are labeled "optional" in this document or not.
We are not responsible for typographical errors.



R. D. E. Melman
August 8 Melman
X

10-1-2016

6/2/2016

702.140 Boysenberry Biscotti

Front Elevation

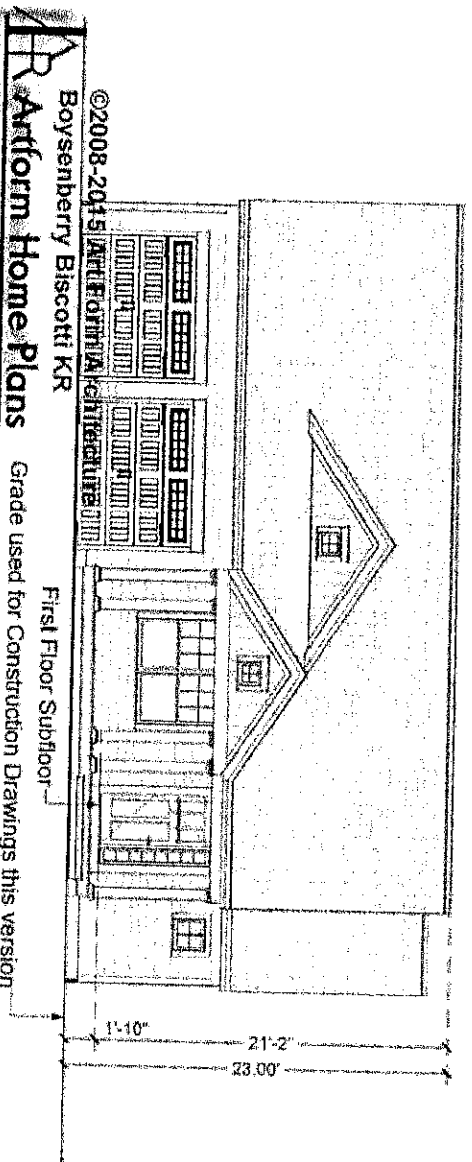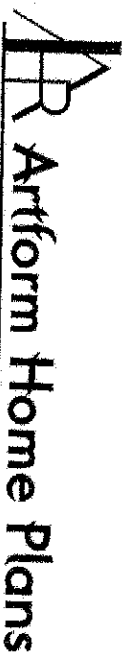

Use of this document is governed by our **Terms and Conditions**, found on our website:
<http://www.artformhomeplans.com/TermsConditions.aspx>

© 2008 Art Form Architecture, Inc. ALL RIGHTS RESERVED.
You may not build this Design without purchasing a License to Build (as defined in our Terms). Unauthorized changes are not permitted and violate copyright laws, which provide substantial penalties for infringement.

R. McFarlane

Robert McFarlane

RC

6-1-2016


6-2-2016

Some features show are optional. Your Purchase & Sale Agreement governs, whether items are labeled "optional" in this document or not.
We are not responsible for typographical errors.

702.140 Boysenberry Biscotti

Right Elevation

 Artform Home Plans

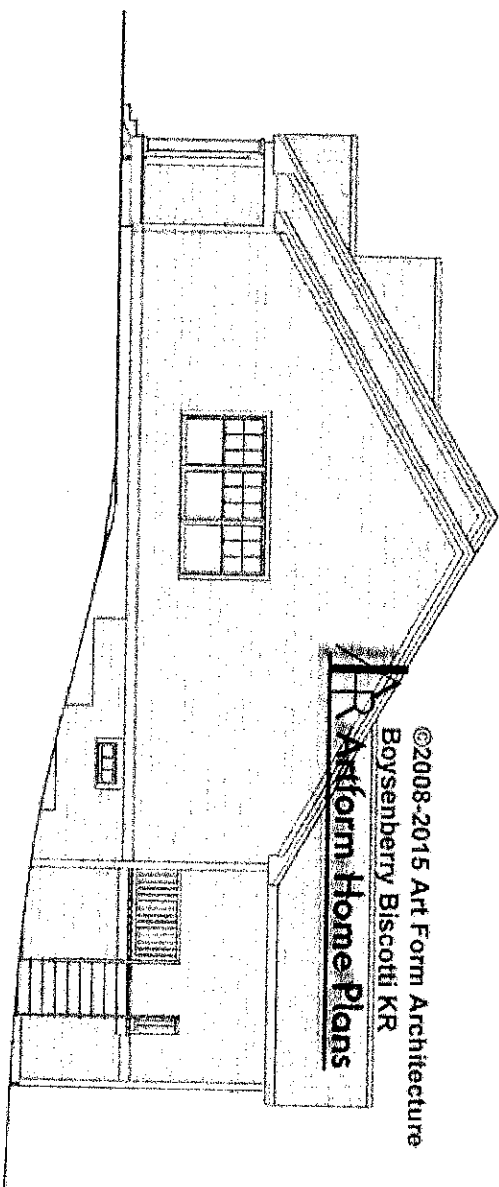

XC

Use of this document is governed by our **Terms and Conditions**, found on our website:
<http://www.artformhomeplans.com/TermsConditions.aspx>


© 2008 Art Form Architecture, Inc. ALL RIGHTS RESERVED.
You may not build this Design without purchasing a License to Build (as defined in our Terms). Unauthorized changes are not permitted and violate copyright laws, which provide substantial penalties for infringement.

Some features show are optional. Your Purchase & Sale Agreement governs, whether items are labeled "optional" in this document or not.
We are not responsible for typographical errors.


R. D. Sigelman 6-1-2016
Sigelman 6/2/2016


702.140 Boysenberry Biscotti

Rear Elevation

 Artform Home Plans

©2008-2015 Art Form Architecture
Boysenberry Biscotti KR

 Artform Home Plans

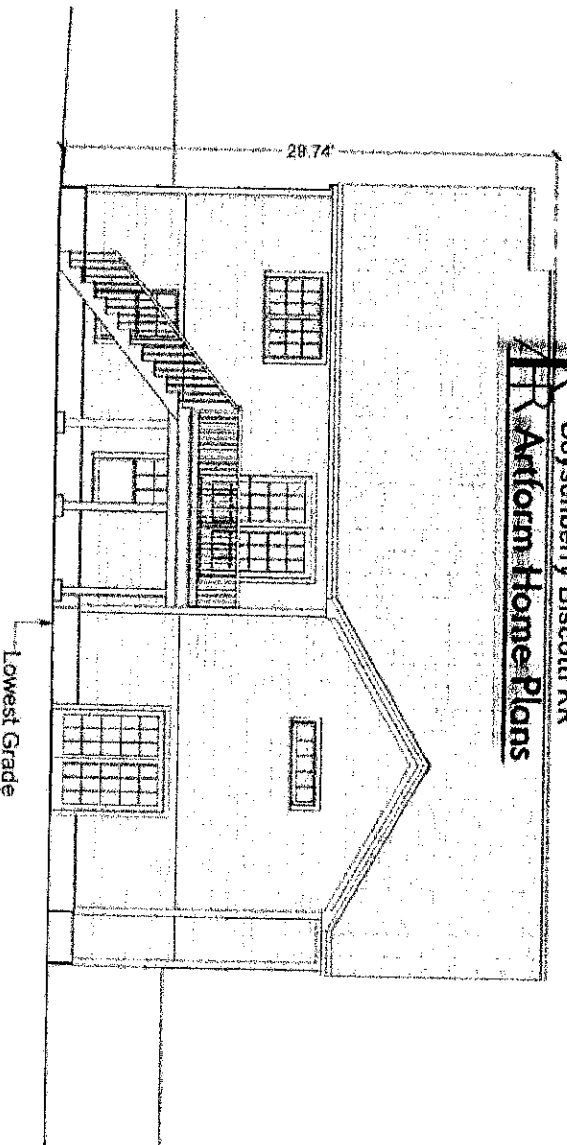

ADD SUNROOM
& DECK

XC


Use of this document is governed by our **Terms and Conditions**, found on our website:
<http://www.artformhomeplans.com/TermsConditions.aspx>

© 2008 Art Form Architecture, Inc. ALL RIGHTS RESERVED.
You may not build this Design without purchasing a License to Build (as defined in our Terms). Unauthorized changes are not permitted and violate copyright laws, which provide substantial penalties for infringement.

Some features show are optional. Your Purchase & Sale Agreement governs, whether items are labeled "optional" in this document or not.
We are not responsible for typographical errors.



6-1-2014

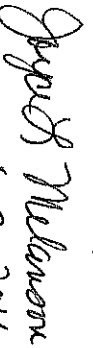


6-2-2016

702.140 Boysenberry Biscotti

Left Elevation

 Artform Home Plans

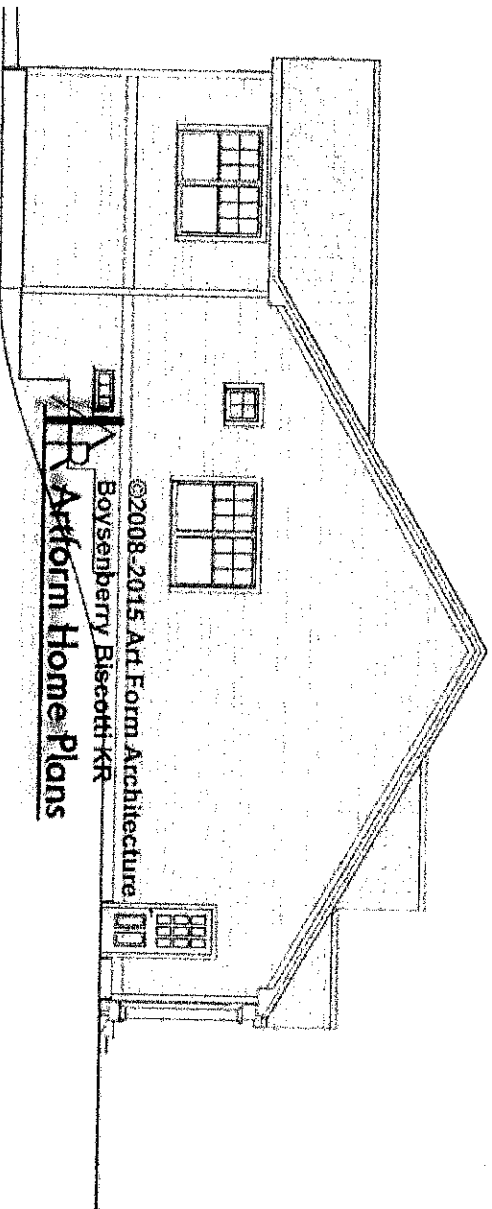

Use of this document is governed by our **Terms and Conditions**, found on our website:
<http://www.artformhomeplans.com/TermsConditions.a5w>

KC

© 2008 Art Form Architecture, Inc. ALL RIGHTS RESERVED.
You may not build this Design without purchasing a License to Build (as defined in our Terms). Unauthorized changes are not permitted and violate copyright laws, which provide substantial penalties for infringement.

Some features show are optional. Your Purchase & Sale Agreement governs, whether items are labeled "optional" in this document or not.
We are not responsible for typographical errors.

Artform Home Plans

6-1-2016

Artform Home Plans

6/2/2016