

Project: Kevin Roy Build  
 Lot: 5 Holly Lane  
 GREENLAND, NH

Model GFL  
 Skylights not shown on window schedule. Model GFL used from Velux or equivalent






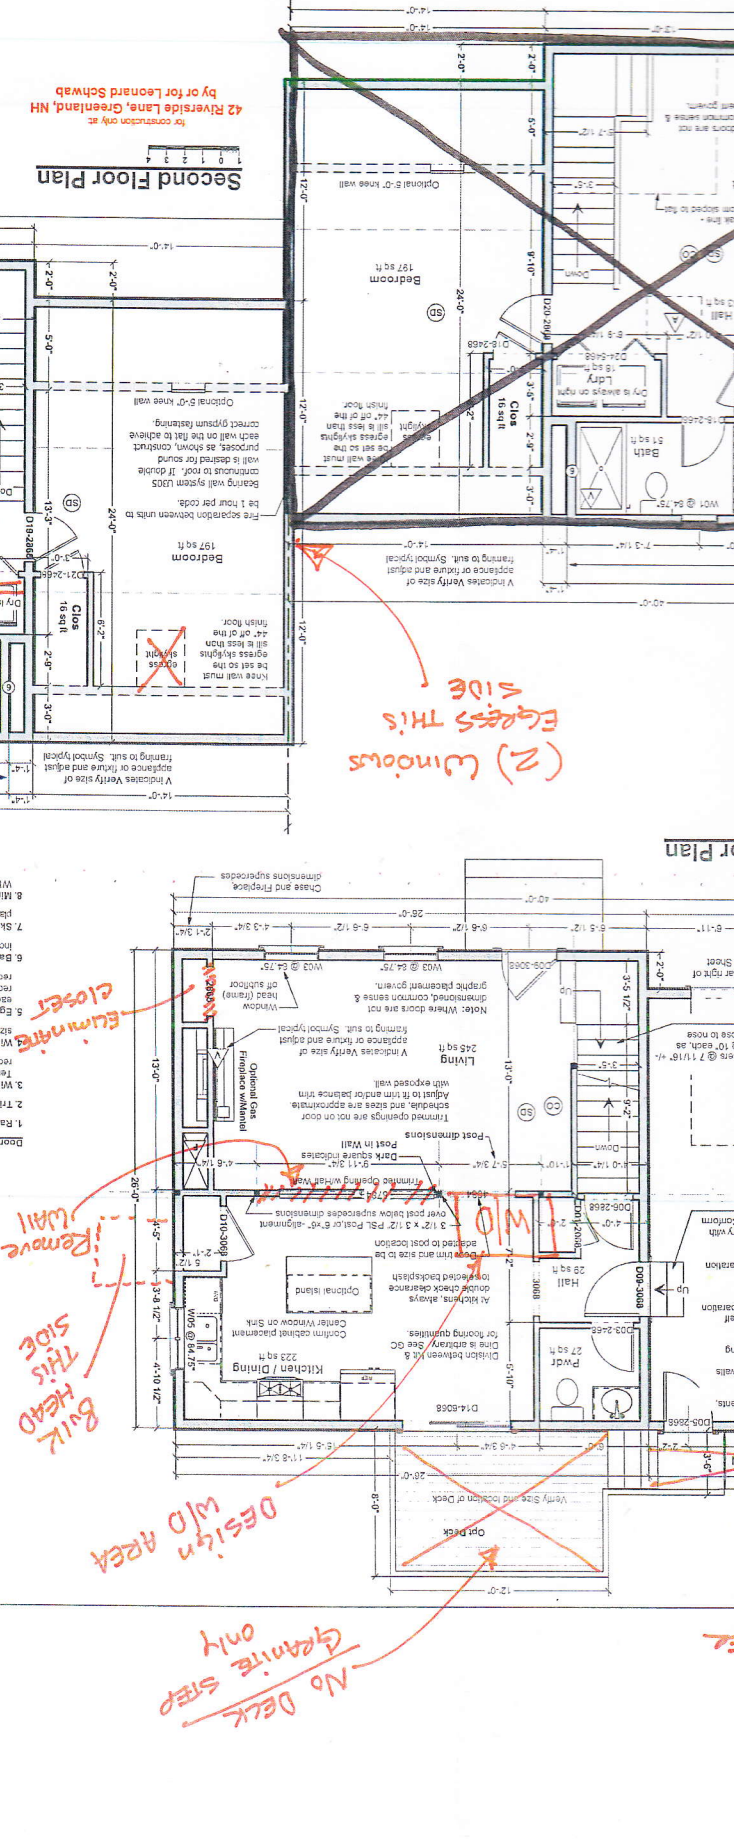










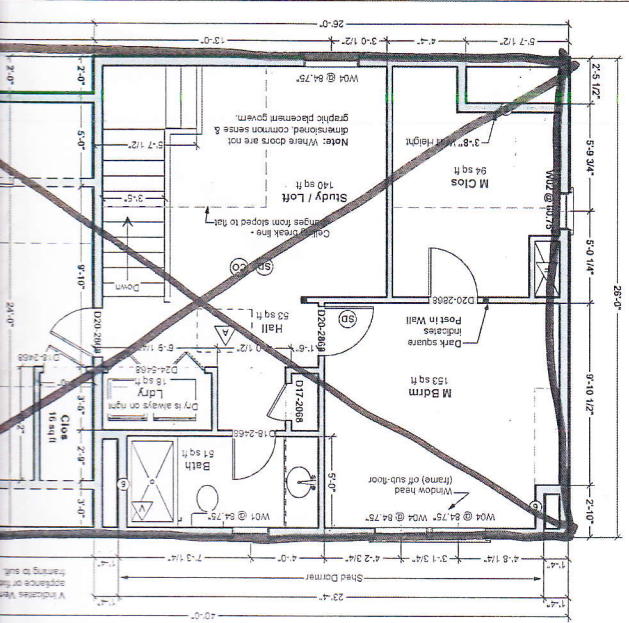

**Notes**

- 1 - Exterior walls 2x4 wood stud @ 16" oc. Provide insulation & sheathing 1/2" gypsum board. Provide 1/2" exterior finish. Provide step flashing at walls adjacent to roof planes.
- 2 - Interior walls 2x4 wood stud @ 16" oc. unless noted otherwise.
- 3 - Roof - see structural for rafter sizes. Provide 6" asphalt shingles or metal roofing. Structure not calculated to support snow or live flat at penetrations. Provide shield at eaves and valleys. Aluminum drip edge and flashing. Provide 1/2" gypsum board at eaves and valleys.
- 4 - Provide roof and/or ceiling insulation per code. Provide soft and rigid vents where required for insulation strategy. (Verify with code official - closed cell spray foam or dense pack cellulose fibrous in place and filling all penetrations. Provide generally vented - indicates venting, but insulation always requires venting)
- 5 - Provide smoke detectors where shown, where required by code and where required by local authorities.
- 6 - Provide fire resistive materials where required by code, including but not limited to, re-roofing at penetrations, 1/2" gypsum board, and protection of flameless insulation separation or ceilings (where more than one level of ceiling is present in design) and protection of flameless insulation. Double stud or structural mull - adapt to suit chosen window brand.
- 7 - Casement bottom of window opening relative to frame. Adjust head heights as required to conform to IRC 2009. Clearances, (halway widths, room sizes, etc) assume 1/2" clearances. Adjust as required if materials differ.
- 8 - Compliance with code requirements for rooms size and clearances. (halway widths, room sizes, etc) assume 1/2" clearances. Adjust as required if materials differ.
- 9 - Some windows must be treated with a head height greater or lesser than the standard 80" or 82 1/2" to provide clearances at kitchen counters to meet code sill height or door tops. Where space for head height is called for, adjust as required. See Section R502.10.4 (pages 173 - 175) of the IRC 2009.
- 10 - Shear is only cut where Continuous Portal Frames will not suffice. See Section R502.10.4 (pages 173 - 175) of the IRC 2009.

- Wall Types**
- Exterior walls 2x4 wood stud, unless noted otherwise.
- Wall Keys**
- 1 - 2x4 wood studs on the wall
- Key Notes**
- 1 - 30" x 22" Minimum R10, R15, R20
  - 2 - Panel - Insulation (R10, R15, R20)
  - 3 - Flat locate for plumb or mechanical
  - 4 - Verify size of fixture or appliance
  - 5 - Door or window trim will be hung and may need to be cut down
  - 6 - Gate - Place door or window centered on wall
  - 7 - Double Stud or structural mull - adapt to suit chosen window brand.
  - 8 - Adjust to have same "box" for curtain hardware and exterior aesthetics.
  - 9 - Smoke Detector
  - 10 - Carbon Monoxide Detector
- Dimensions**
- Dimensions are to face of stud, unless noted otherwise. Credits are 2" clear inside, unless dimensioned otherwise.
- Square Footages**
- 1 - Sq ft numbers are meter to room for use in calculating finishes.
  - 2 - Add for doorways when floor finishes run through.
  - 3 - Chairs and boxes not subtracted.

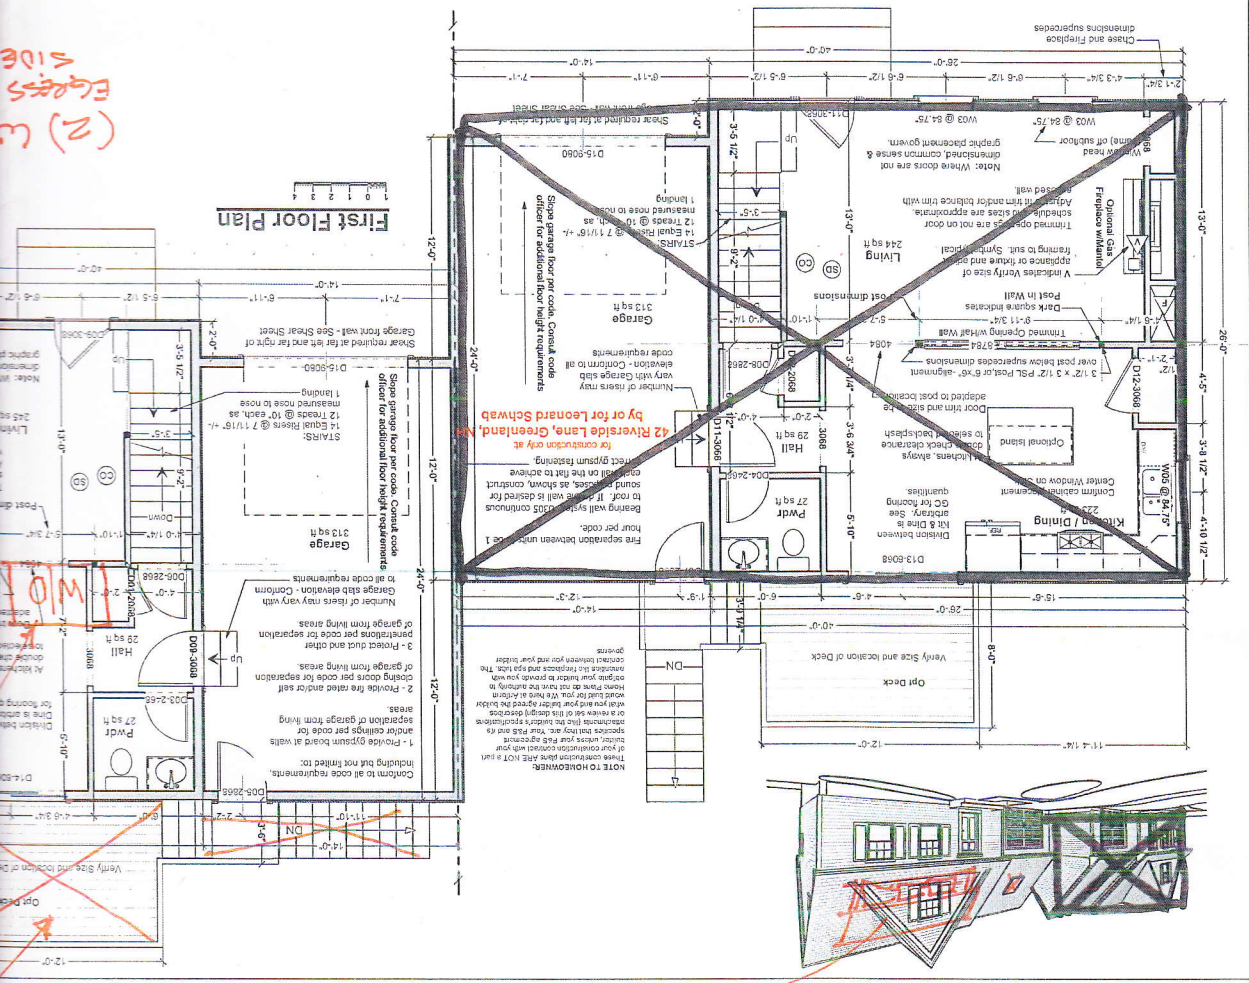

CHANGE TO SHEO DORMER

\* FLAT LOT 12" - 18" EXPOSED FOUNDATION ALL AROUND  
NO SKYLIGHTS