Gordon variation

© 2014 Wendy Welton, all rights reserved . You may not build this design without purchasing a license, even if you make changes. This design may have geographic restrictions.

Artform Home Plans

Prelim / Work in Progress 603-431-9559
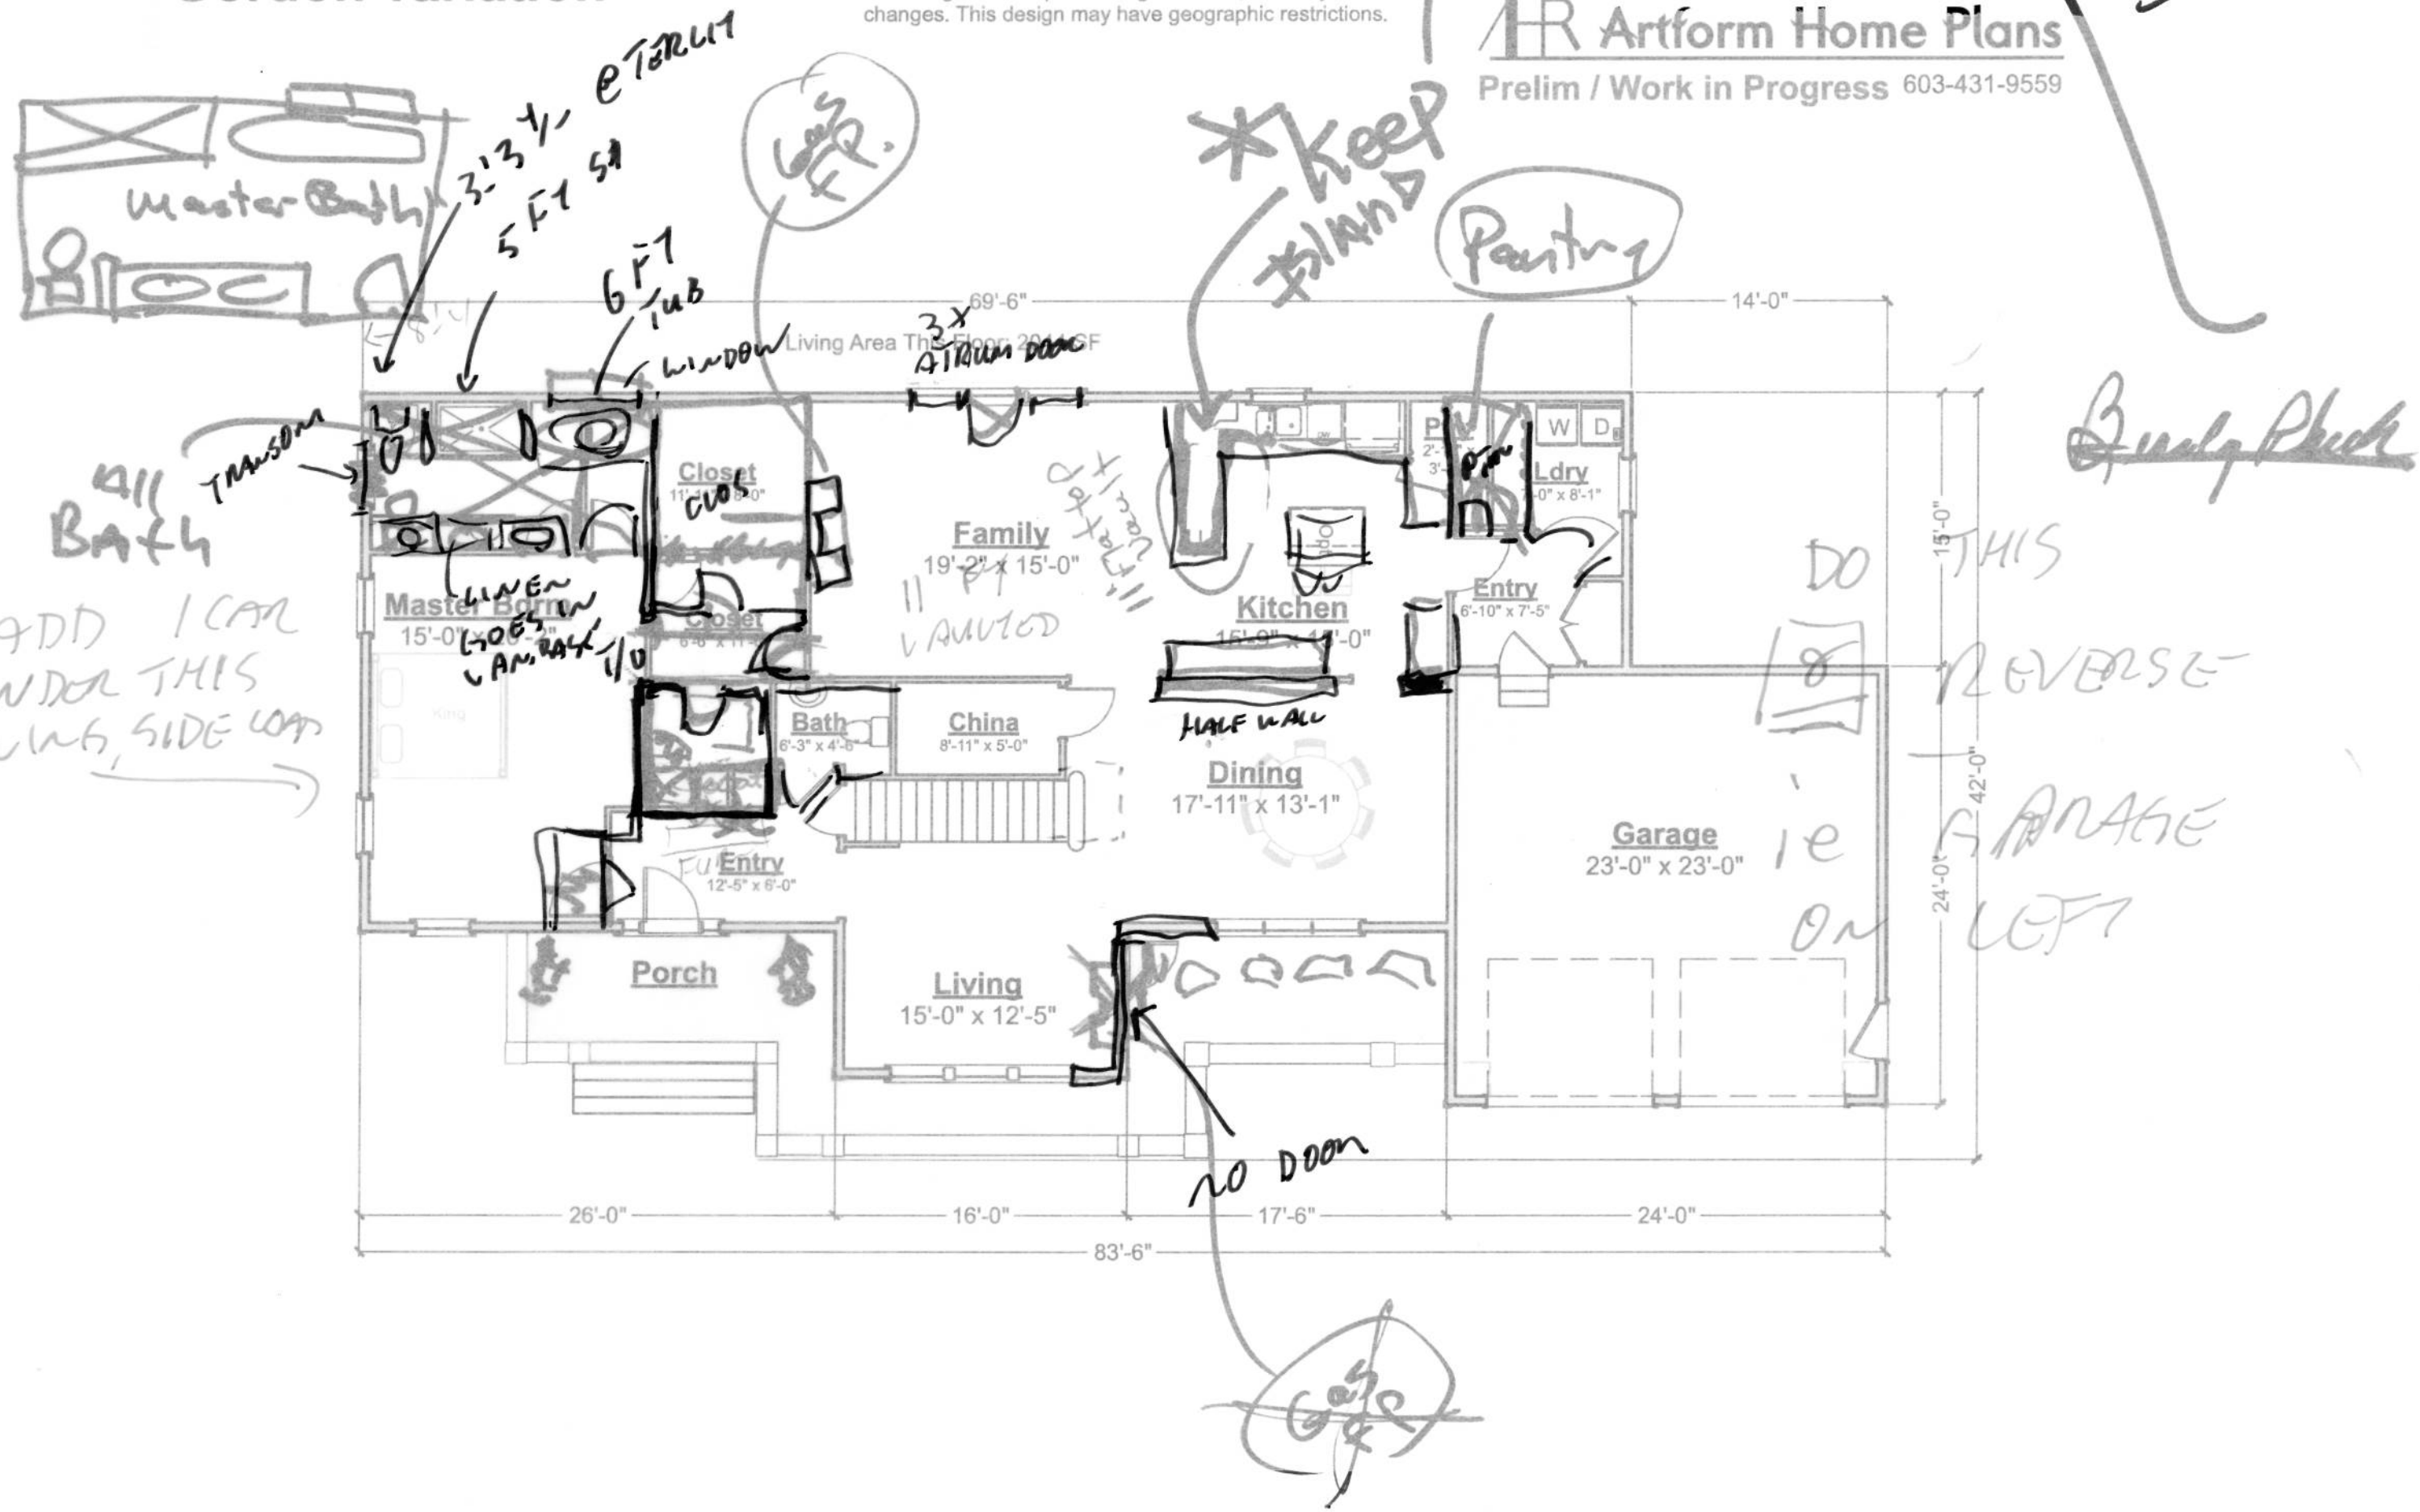
Jenna
I change Back
TO ISLAND
11/25/14