


Bonnie Ranch

679.124.v29 GR

© 2014-2020 Art Form Architecture, Inc., all rights reserved.
You may not build this design without purchasing a license,
even if you make changes. This design may have geographic
restrictions.

Artform Home Plans

603-431-9559

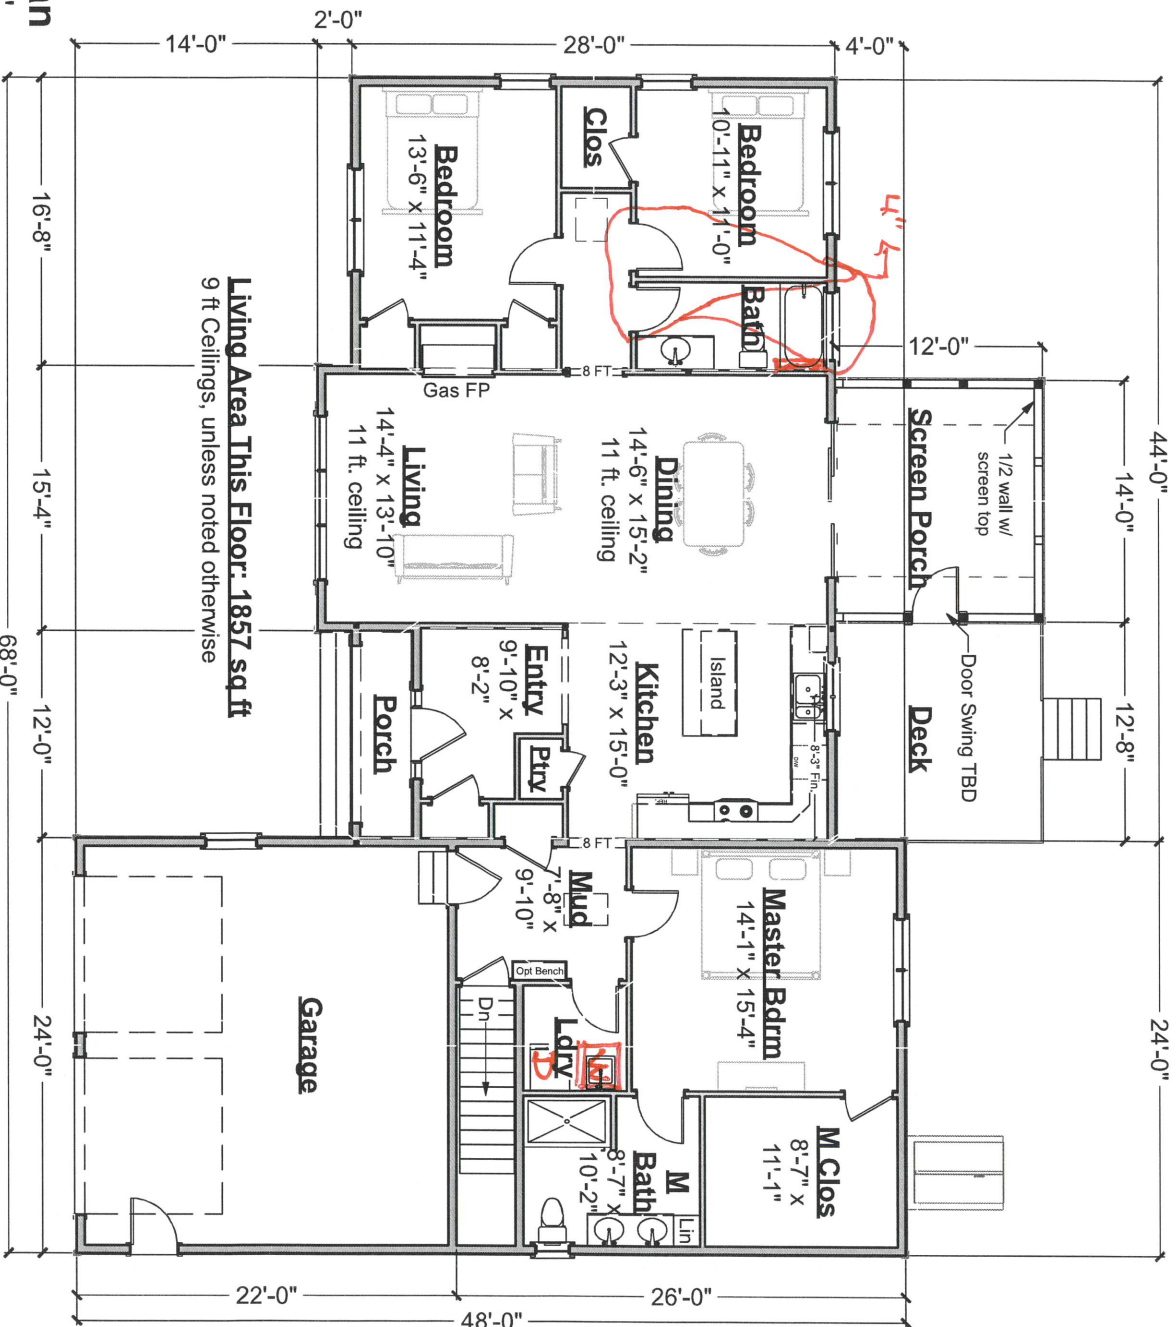

First Floor Plan

Scale: 3/32" = 1'-0"