

Lot 3 Bramble Meadow - Exeter

Garnet Delux


384.130.v2 SL

© 2011-2019 Art Form Architecture, Inc., all rights reserved. You may not build this design without purchasing a license, even if you make changes. This design may have geographic restrictions.



First Floor Plan

Scale: 1/8"=1'-0"

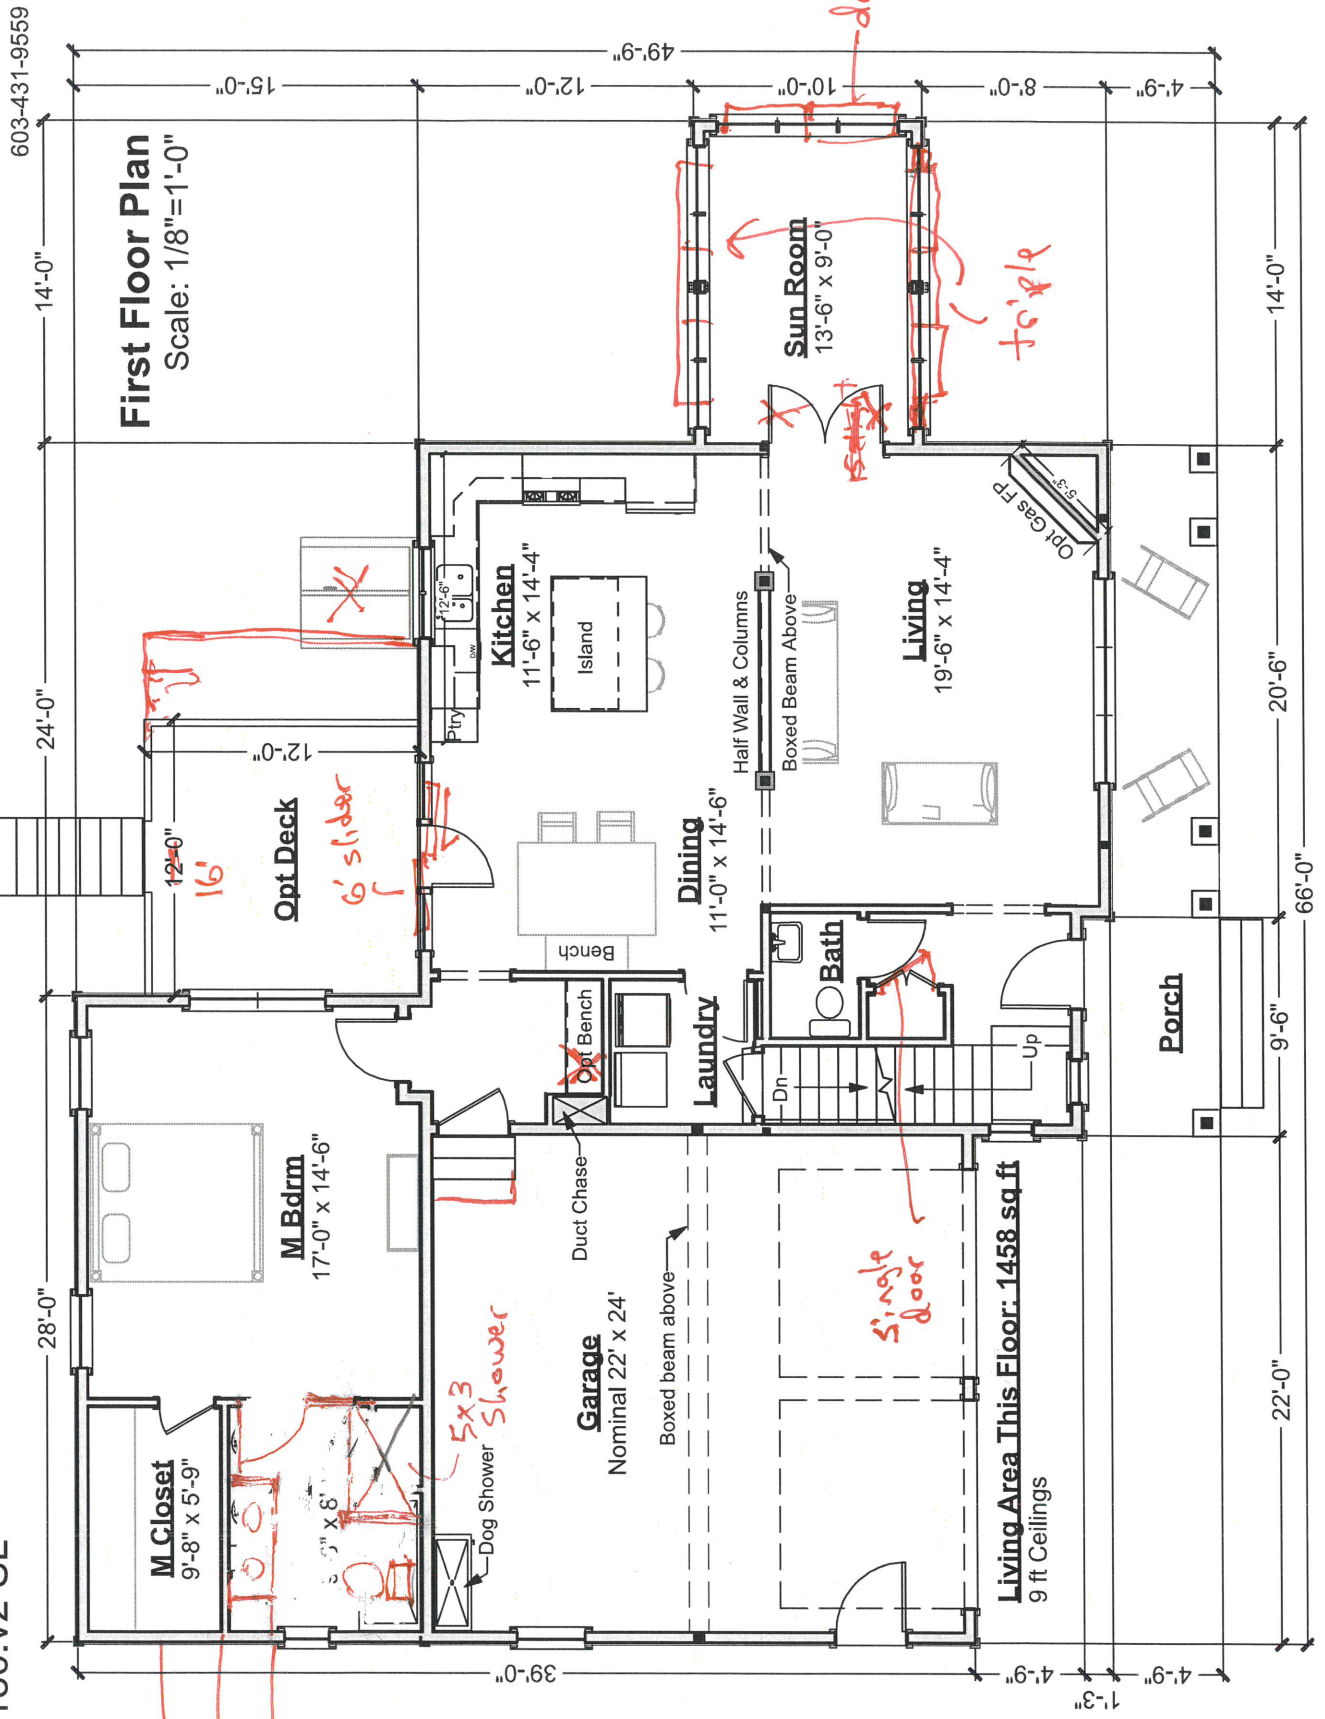



603-431-9559

Garnet Delux

384.130.v2 SL

© 2011-2019 Art Form Architecture, Inc., all rights reserved. You may not build this design without purchasing a license, even if you make changes. This design may have geographic restrictions.

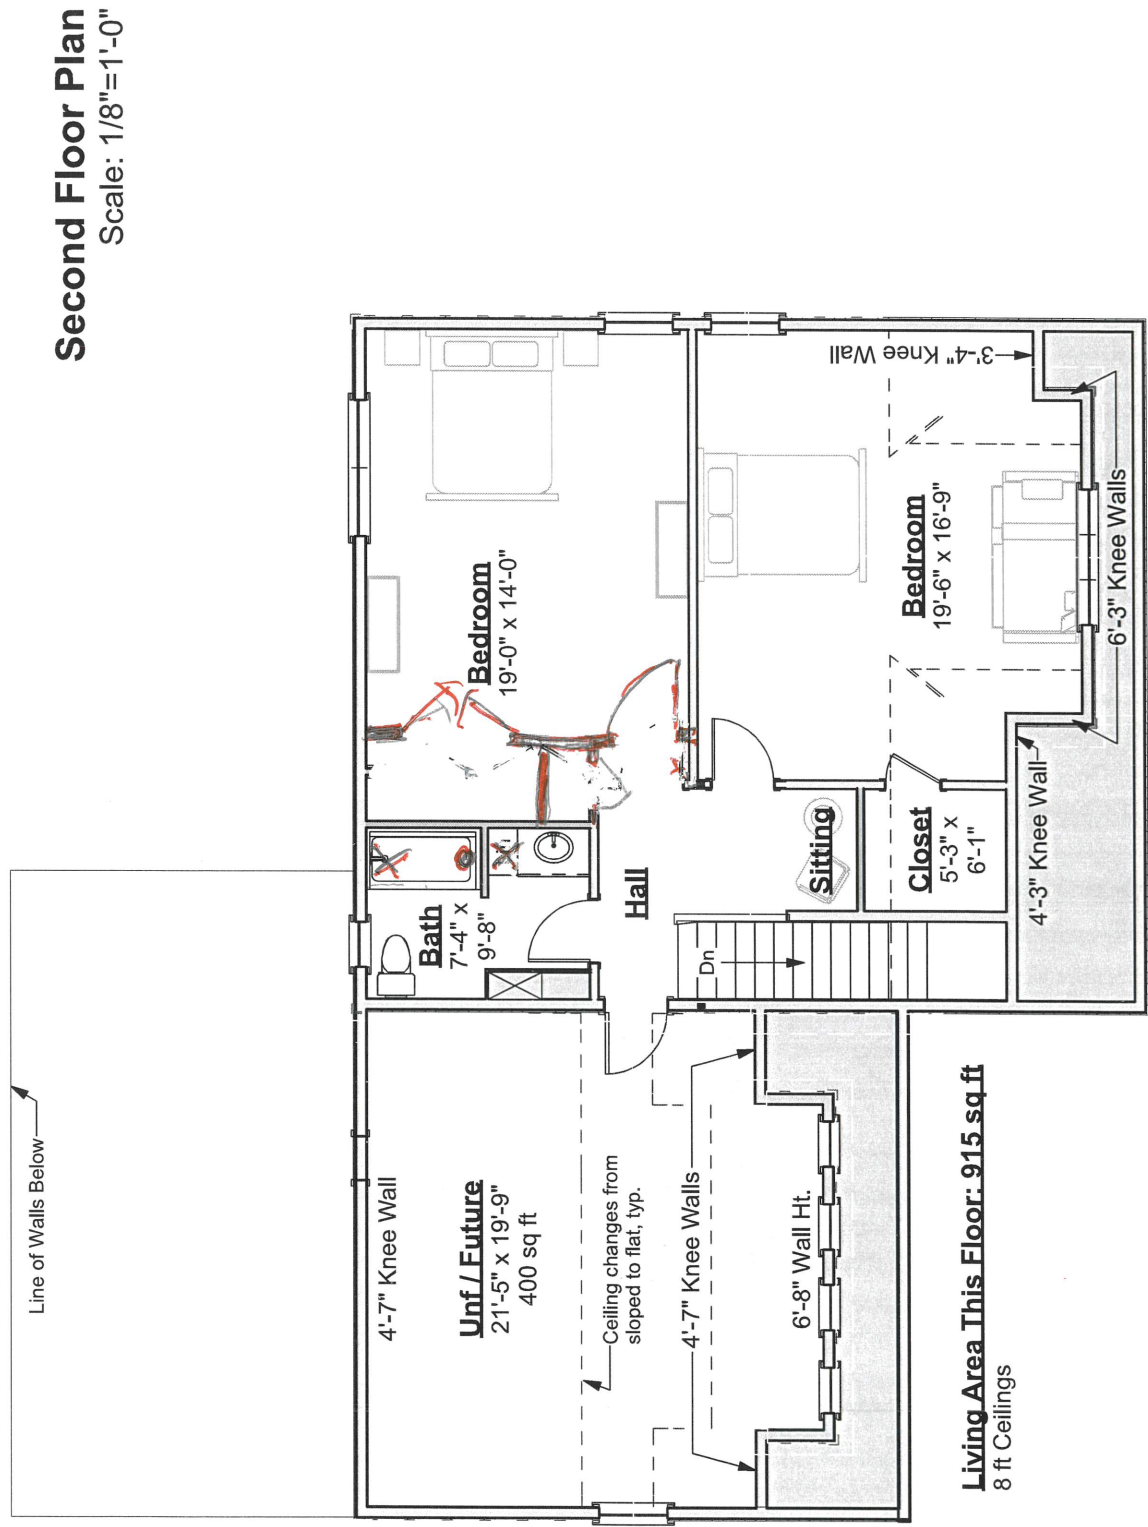

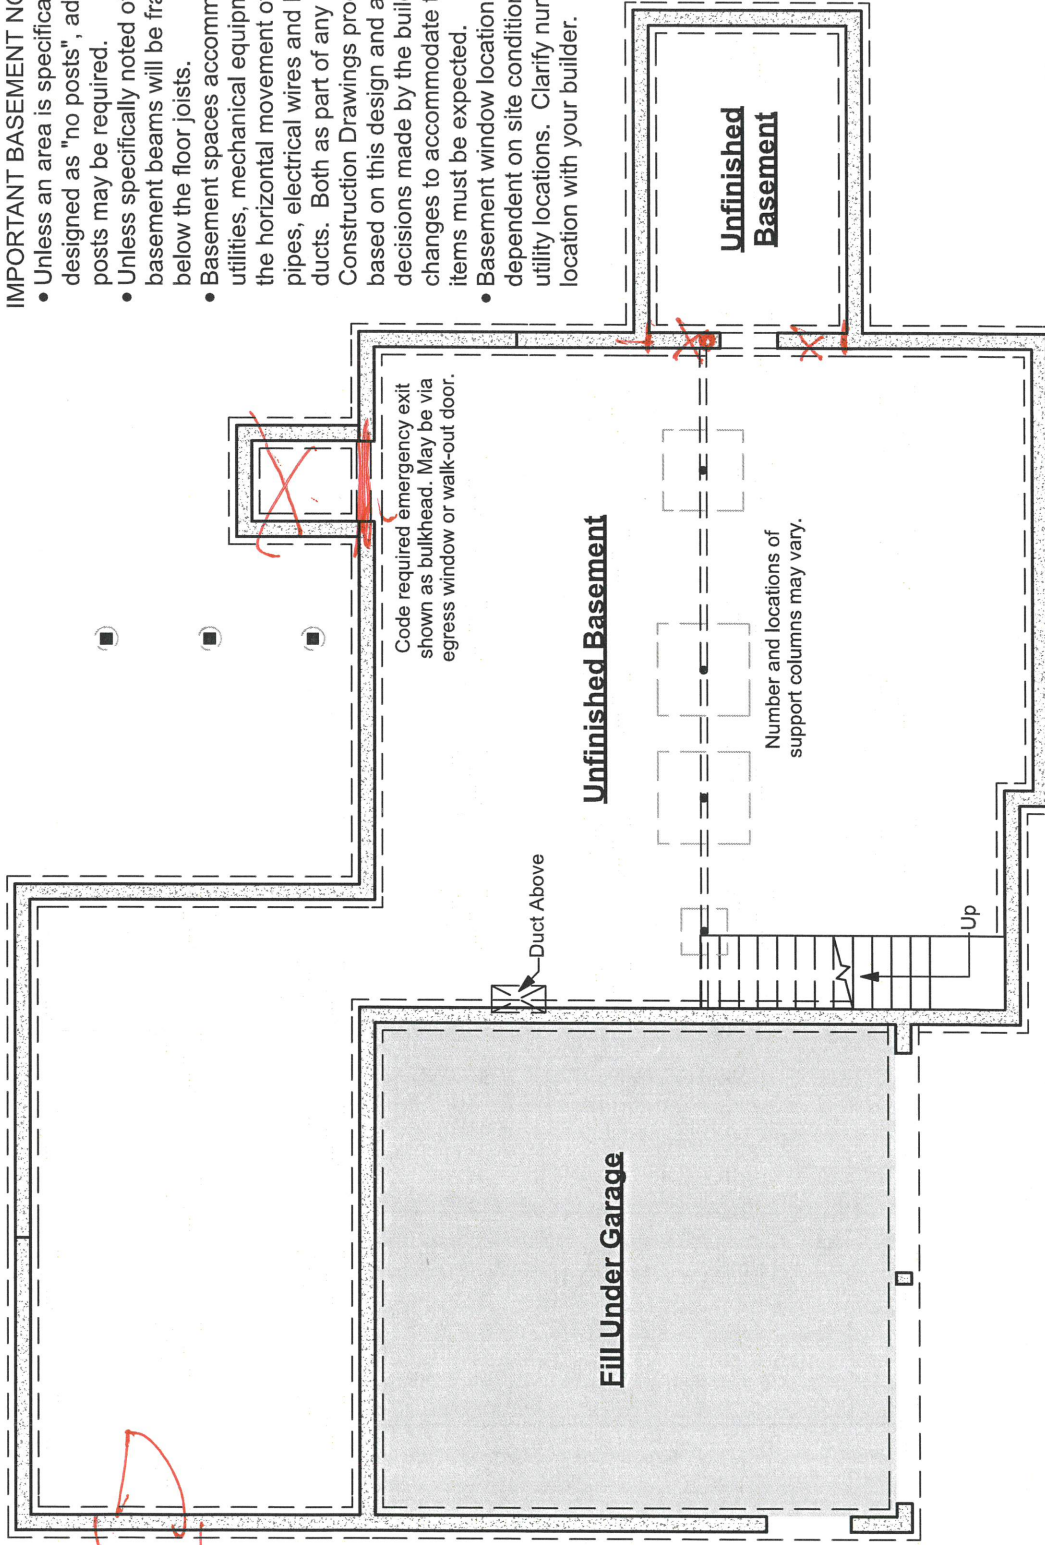

- IMPORTANT BASEMENT NOTES:**
- Unless an area is specifically designed as "no posts", additional posts may be required.
 - Unless specifically noted otherwise, basement beams will be framed below the floor joists.
 - Basement spaces accommodate utilities, mechanical equipment and the horizontal movement of plumbing pipes, electrical wires and heating ducts. Both as part of any Construction Drawings produced based on this design and as future changes to accommodate these items must be expected.
 - Basement window locations are dependent on site conditions and utility locations. Clarify number and location with your builder.

Foundation Plan
Scale: 1/8"=1'-0"

Garnet Deluxe


384.130.v2 SL

© 2011-2019 Art Form Architecture, Inc., all rights reserved. You may not build this design without purchasing a license, even if you make changes. This design may have geographic restrictions.



Front Elevation

Scale: 1/8"=1'-0"

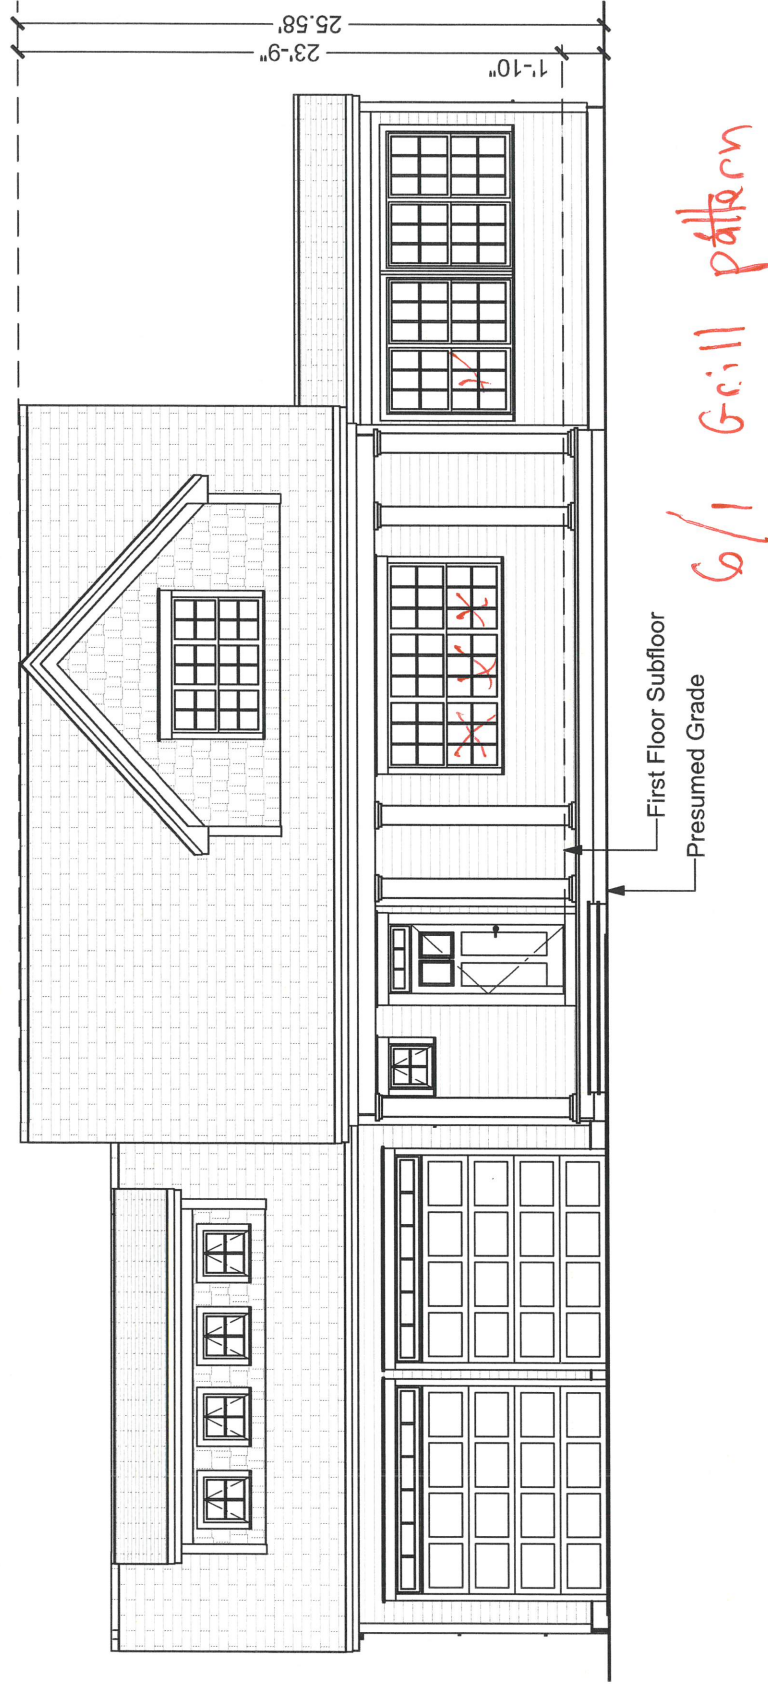


Garnet Delux
384.130.v2 SL

© 2011-2019 Art Form Architecture, Inc., all rights reserved . You may not build this design without purchasing a license, even if you make changes. This design may have geographic restrictions.



Right Elevation
Scale: 1/8"=1'-0"

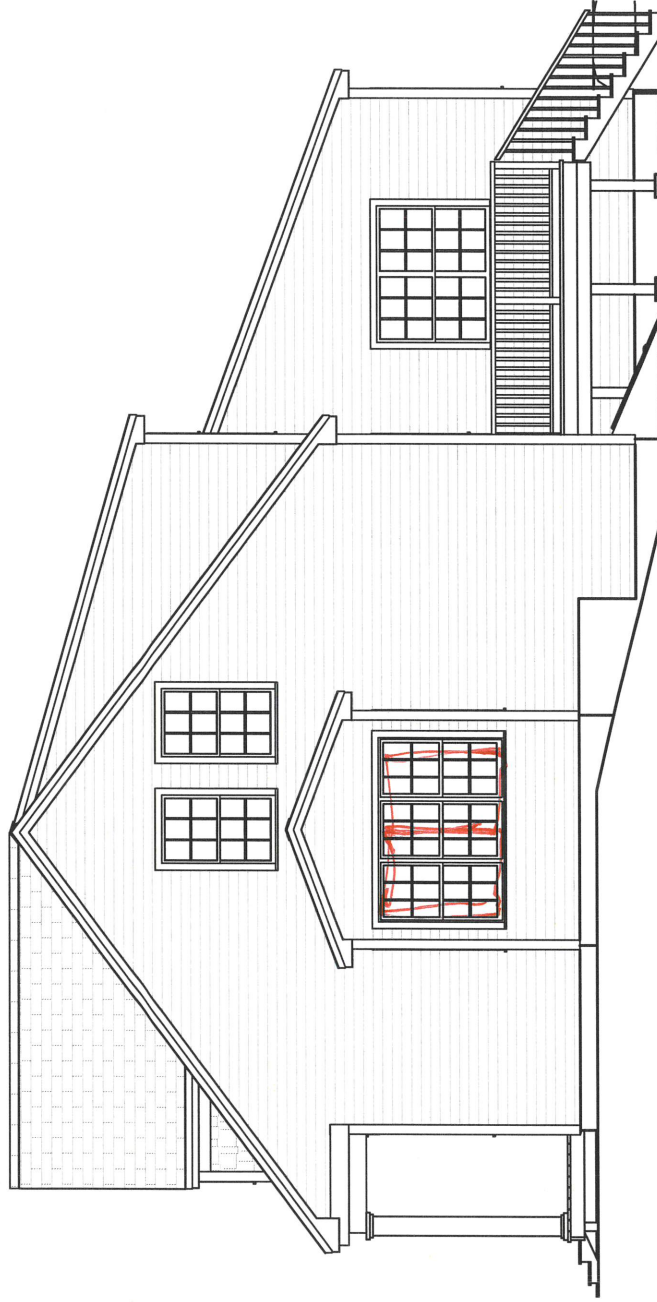

Garnet Deluxe
384.130.v2 SL

© 2011-2019 Art Form Architecture, Inc., all rights reserved. You may not build this design without purchasing a license, even if you make changes. This design may have geographic restrictions.



603-431-9559

Rear Elevation
Scale: 1/8"=1'-0"



Garnet Delux
384.130.v2 SL

© 2011-2019 Art Form Architecture, Inc., all rights reserved . You may not build this design without purchasing a license, even if you make changes. This design may have geographic restrictions.



603-431-9559

Left Elevation
Scale: 1/8"=1'-0"

