

Sunny Laughing Daffodil


580.121.v3 KL (6/4/2020)

© 2013-2020 Artform Architecture, Inc., all rights reserved. You may not build this design without purchasing a license, even if you make changes. This design may have geographic restrictions.

Artform Home Plans

603-431-9559

Huntington
Lot 4

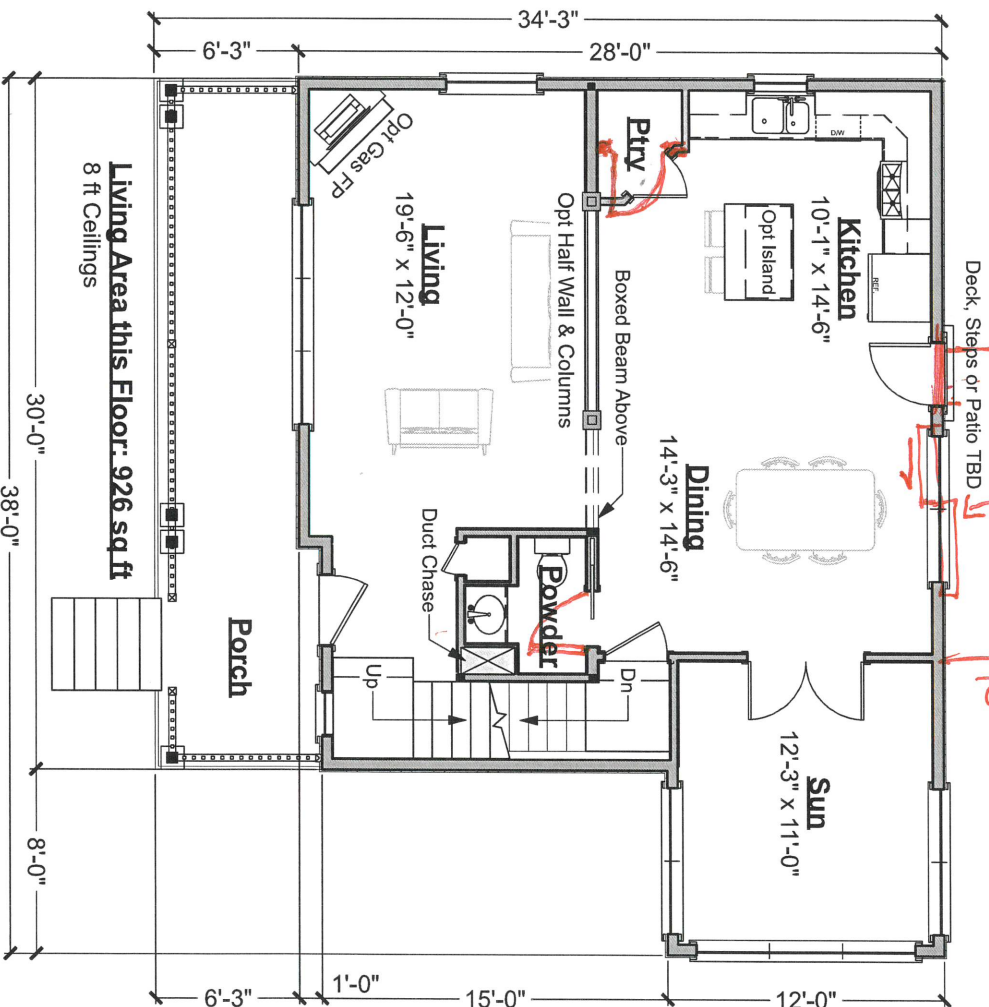

12' x 10' Deck

6' slider

Deck, Steps or Patio TBD

10'

Flip

First Floor Plan
Scale: 1/8" = 1'-0"


Sunny Laughing Daffodil

580.121.v3 KL (6/4/2020)

© 2013-2020 Art Form Architecture, Inc., all rights reserved . You may not build this design without purchasing a license, even if you make changes. This design may have geographic restrictions.



603-431-9559

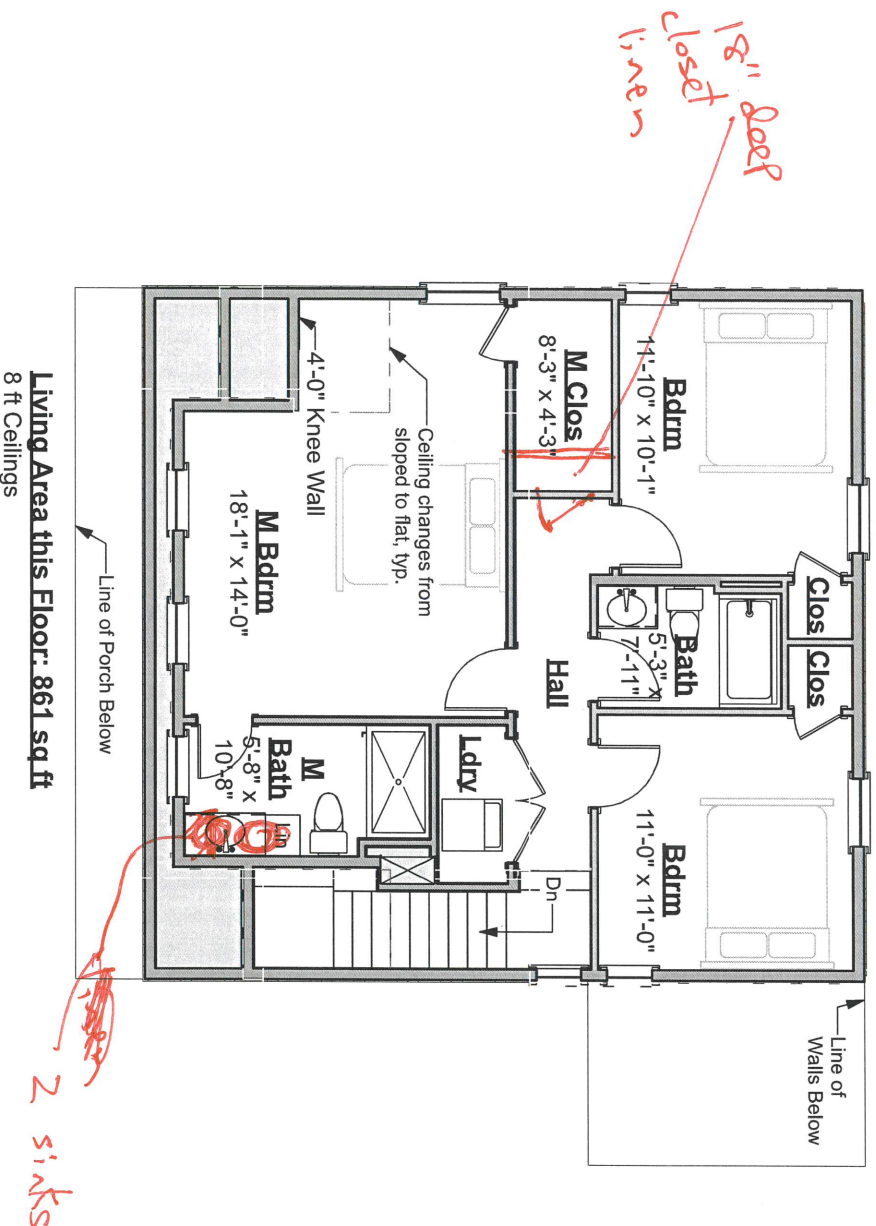

Second Floor Plan

Scale: 1/8" = 1'-0"


Sunny Laughing Daffodil

580.121.v3 KL (6/4/2020)

© 2013-2020 Art Form Architecture, Inc., all rights reserved . You may not build this design without purchasing a license, even if you make changes. This design may have geographic restrictions.



603-431-9559

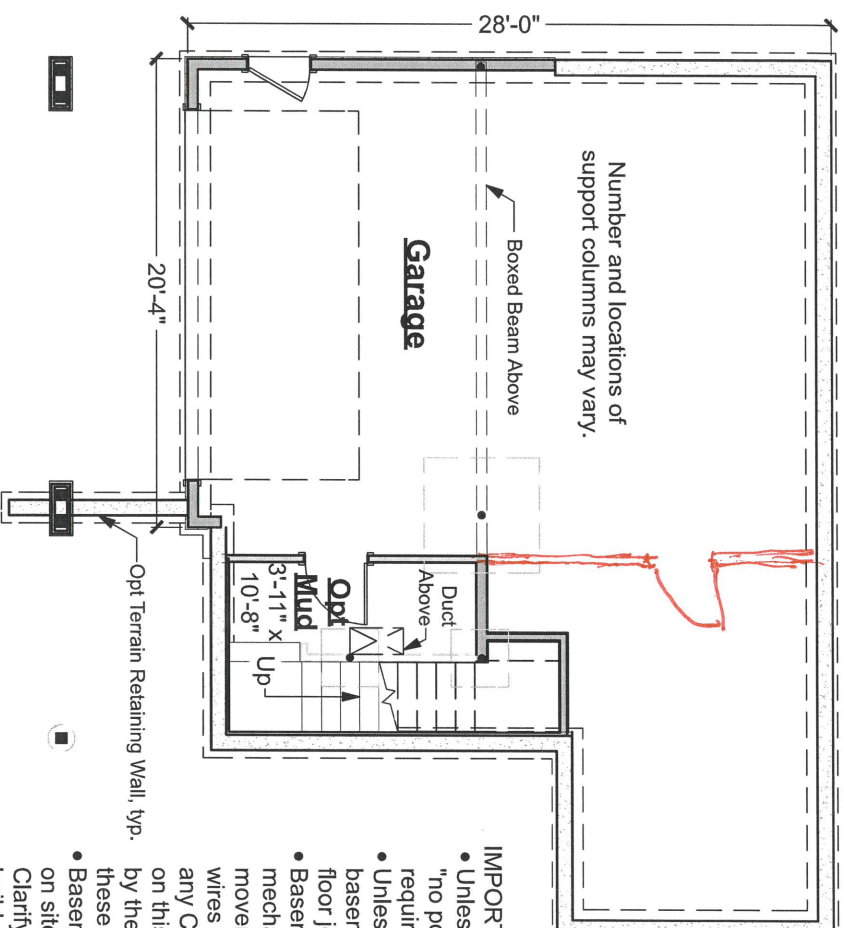

IMPORTANT BASEMENT NOTES:

- Unless an area is specifically designed as "no posts", additional posts may be required.
- Unless specifically noted otherwise, basement beams will be framed below the floor joists.
- Basement spaces accommodate utilities, mechanical equipment and the horizontal movement of plumbing pipes, electrical wires and heating ducts. Both as part of any Construction Drawings produced based on this design and as future decisions made by the builder, changes to accommodate these items must be expected.
- Basement window locations are dependent on site conditions and utility locations. Clarify number and location with your builder.

Foundation Plan

Scale: 1/8" = 1'-0"

Sunny Laughing Daffodil
580.121.v3 KL (6/4/2020)

© 2013-2020 Art Form Architecture, Inc., all rights reserved . You may not build this design without purchasing a license, even if you make changes. This design may have geographic restrictions.

Artform Home Plans

603-431-9559



Front Elevation
Scale: 1/8" = 1'-0"


Sunny Laughing Daffodil

580.121.v3 KL (6/4/2020)

© 2013-2020 Art Form Architecture, Inc., all rights reserved . You may not build this design without purchasing a license, even if you make changes. This design may have geographic restrictions.

 **Artform Home Plans**

603-431-9559

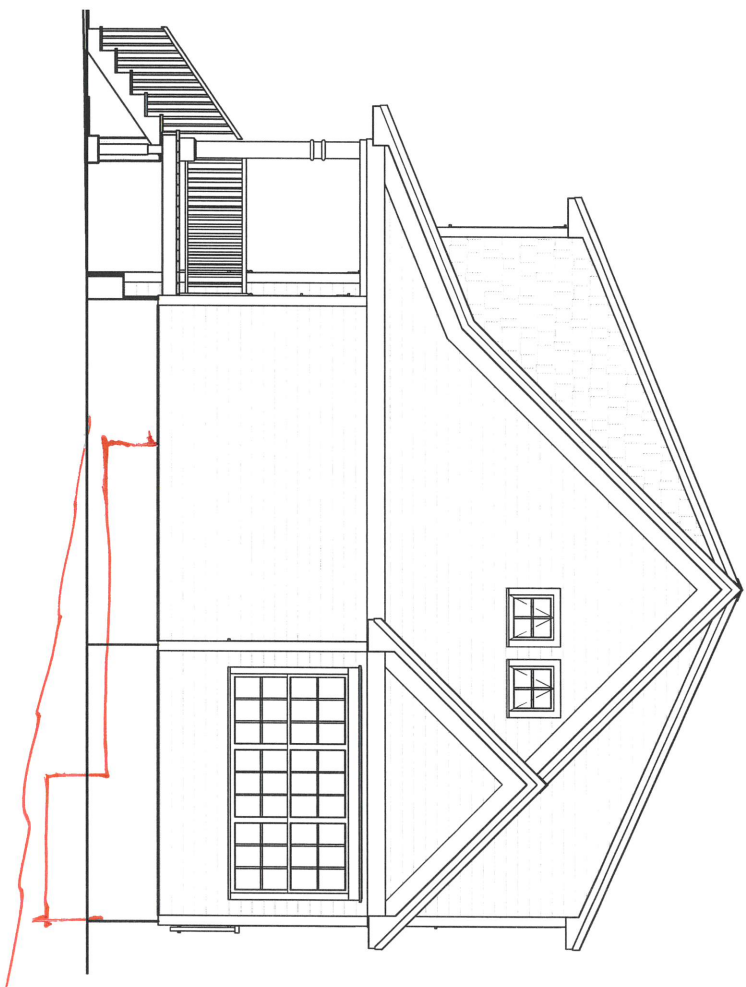

Right Elevation

Scale: 1/8" = 1'-0"


Sunny Laughing Daffodil

580.121.v3 KL (6/4/2020)

© 2013-2020 Art Form Architecture, Inc., all rights reserved . You may not build this design without purchasing a license, even if you make changes. This design may have geographic restrictions.

 Artform Home Plans

603-431-9559

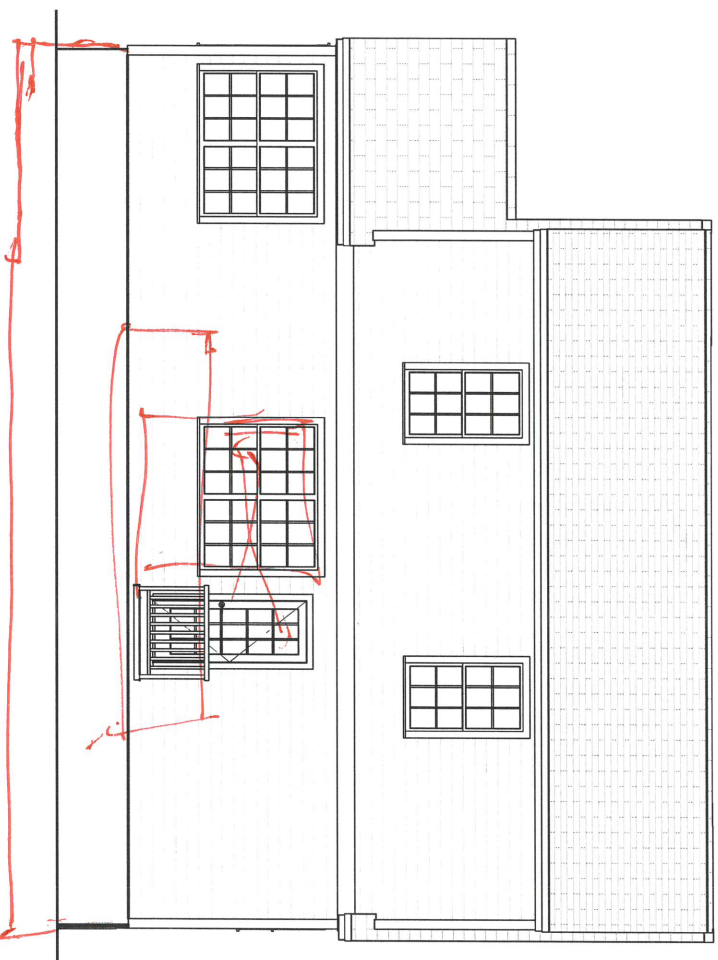

Rear Elevation
Scale: 1/8" = 1'-0"


Sunny Laughing Daffodil

580.121.v3 KL (6/4/2020)

© 2013-2020 Art Form Architecture, Inc., all rights reserved . You may not build this design without purchasing a license, even if you make changes. This design may have geographic restrictions.

 **Artform Home Plans**

603-431-9559

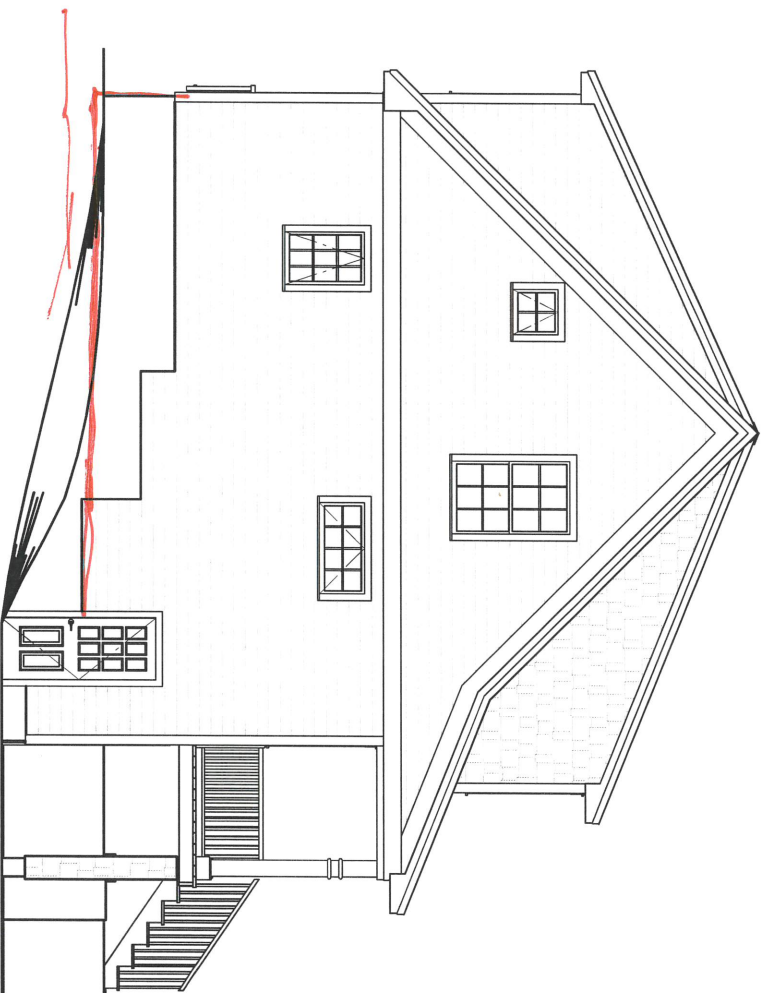

Left Elevation

Scale: 1/8" = 1'-0"