

**Wall Types**  
Exterior walls 2x6 wood stud, unless noted otherwise  
Interior walls 2x4 wood stud, unless noted otherwise

**Wall Keys**

- 2x wood studs on the flat
  - 2x4 wood stud wall, 16" oc
  - 2x6 wood stud wall, 16" oc
- Note: 2x4 wood stud wall, 16" oc unless otherwise noted

**Key Notes**

- 30" x 22" Minimum Attic Access Panel - Insulated (R0 34" x 28")
- Field locate for plumbing or mechanical
- Verify size of fixture or appliance
- Adjust dimensions to accommodate
- Shing - Door or window trim will be shing and may need to be cut down
- Center - Place door or window centered
- Double Shut or structural mull - adapt to suit chosen window brand
- Object is to have some "bite" for curtain hardware and exterior aesthetics.
- Smoke Detector
- Carbon Monoxide Detector
- Heat Detector

**Dimensions**

- 1. Dimensions are to face of stud, unless noted otherwise.
- 2. Closets are 24" clear inside, unless dimensioned otherwise.

**Square Footages**

- 1. Sq ft numbers are interior to room for use in calculating finishes.
- 2. Cabinets and fixtures not subtracted.
- 3. Add for doorways when floor finishes run through.

**Notes**


- 1. Exterior walls 2x6 wood stud @ 16" oc. Provide insulation & vapor barrier conforming to state or local codes. Interior sheathing 1/2" gypsum board. Provide 1/2" exterior rated sheathing, house wrap adjacent to roof planes. Provide step flashing at walls adjacent to roof planes.
- 2. Interior walls 2x4 wood stud @ 16" oc, unless noted otherwise.
- 3. Roof - see structural for rafter sizes. Provide 5/8" exterior rated roof sheathing 15g roofing felt, ice & water shield at eaves and valleys, aluminum drip edges and asphalt shingles or metal roofing. Structure not calculated to support slate or tile. Flash all penetrations. Provide cricket at any added chimneys.
- 4. Provide roof and/or ceiling insulation per code. Provide soffit and ridge vents where required for insulation strategy. (Verify with code officer - closed cell spray foam or dense-pack cellulose installed at batt insulation always requires venting).
- 5. Provide smoke detectors where shown, where required by code and where required by local authorities.
- 6. Provide fire protective materials where required by code, including but not limited to, firestopping at penetrations, 1/2" drywall on walls and 5/8" drywall on ceilings to separate garage (where garage present in design) from dwelling, and separation of dwellings where more than one dwelling present in design, and protection of flammable insulation materials.
- 7. Compliance with code requirements for rooms size and clearances, (hallway widths, room sizes, etc) assume 1/2" drywall on walls and 1/2" drywall on 3/4" stepping on ceilings. Adjust as required if materials differ.
- 8. Shear is only called out where Continuous Portal Frame will not suffice. See Section R802.10.4 (Pages 173 - 179) of the IRC 2009.

# April Yarrow

for construction only at  
Lot 9 Riverlee Commons, Lee, NH  
by or for Chibburg Builders

Verify Size and location of Deck


Opt Deck  
160 sq ft

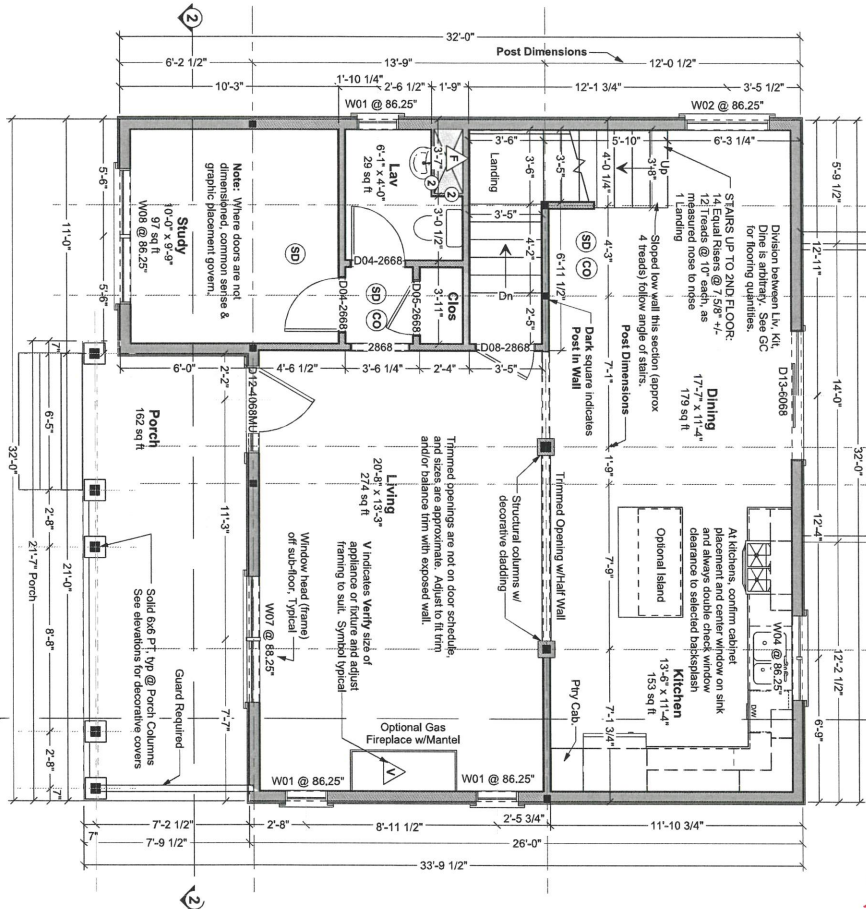

## First Floor Plan

Living Area this Floor: 898 sq ft  
8ft Finished Ceiling Height

These drawings are intended for use by an experienced professional builder in responsible charge of the entire project, including but not limited to mechanical, electrical and slawork. Any additional adaptation for these trades or other trades must be determined prior to start of construction. Contact Artform for any adjustments needed.

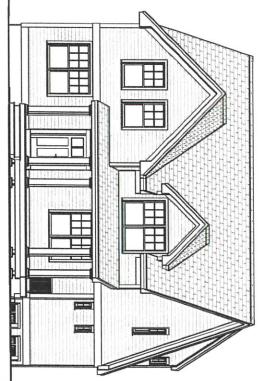

**Dear Code Officer:**

These are pre-designed home plans, designed to bring good design faster into the building process. We encourage the future "owner" to take responsibility for the design and construction of the home. 

1. Room sizes (Section R302)  
2. Floor space & ceiling height at Tallest Bath and Shower Spaces (Section R307)  
**Artform Home Plans**


APRIL YARROW

1

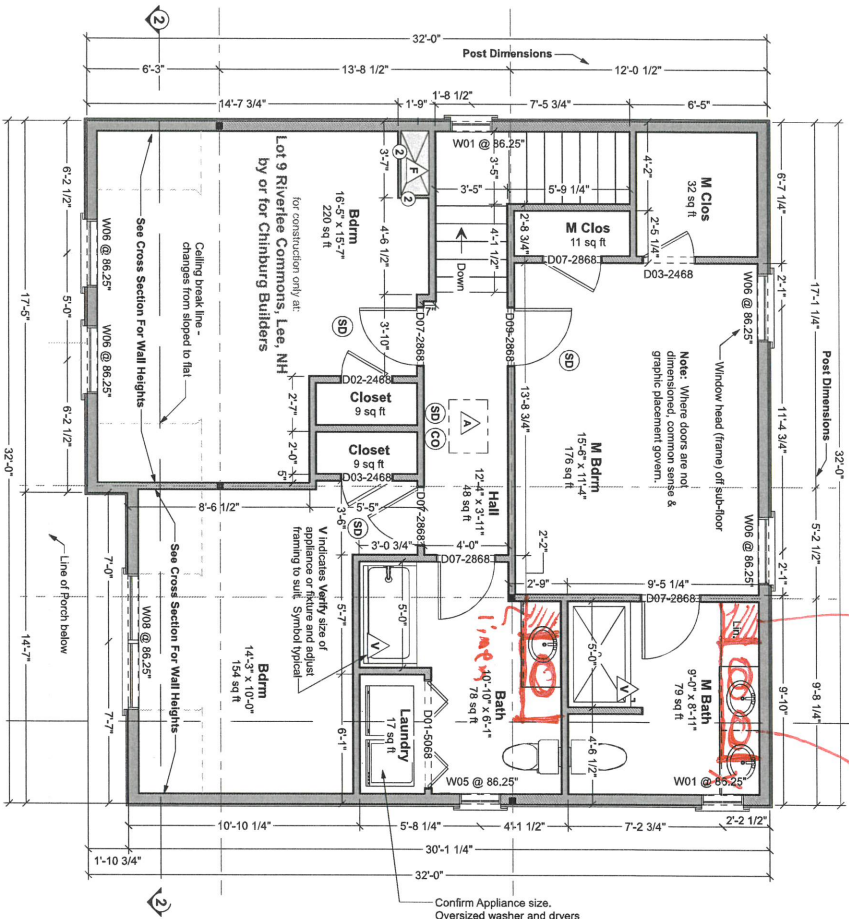

**Second Floor Plan**  
Living Area this Floor: 996 sq ft  
8ft Finished Ceiling Height

NUMBER	QTY	FLOOR	SIZE	DOOR SCHEDULE	HEIGHT	TYPE	COMMENTS
D01	1	2	50/8 LR	80"	80"	4 DR. BIFOLD	
D02	1	2	24/8 R	28"	80"	HINGED	
D03	1	2	24/8 R	28"	80"	HINGED	
D04	2	2	24/8 R	30"	80"	HINGED	
D05	1	0	24/8 R	30"	80"	HINGED	
D06	1	0	24/8 R	30"	80"	HINGED	
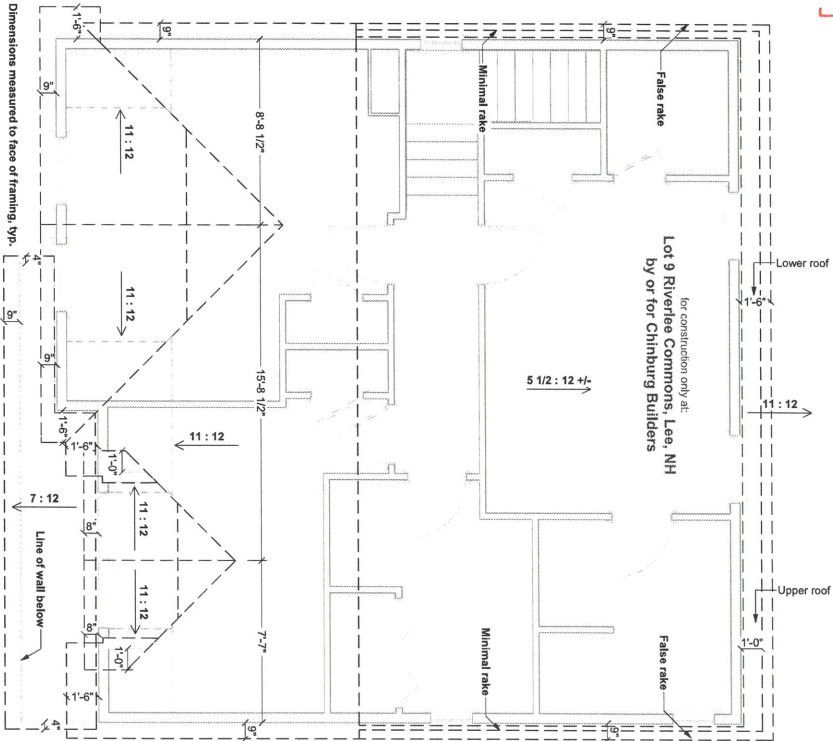

**Roof Plan**  
Dimensions measured to face of framing, 9/8\"/>

- Door & Window Notes**
- Rated Doors:** Provide fire rated and/or self-closing doors where required by local codes or local authorities.
  - Trimmed Openings:** Trimmed openings not shown on schedule. See Plan.
  - Window Tempering:** Provide tempered windows where required by local codes or local authorities. Tempering column provided here for convenience. Windows have not been reviewed for tempering requirements.
  - Window RCs:** 1/4" or 1/2" on each of 4 sides allowed for window RCs, typical. Review framing size vs RC size. Adjust per manufacturer's requirements and/or builder preference.
  - Egress Windows:** Provide minimum one door or window meeting egress requirements in basement, in each sleeping room, in each potential sleeping room, and other locations required by local code, in sizes required by local code. Note that casement windows coded by manufacturer as meeting IRC 2006 egress (Section R310.1.1, R310.1.2, R310.1.3 and R310.1.4). Will also comply with NFPA 101.
  - Basement Windows:** Add basement windows as required to meet state or local code requirements, including but not limited to egress and light/ventilation.
  - Skylights:** Skylights are not shown on this schedule, but may be required. Consult builder and/or see floor plan.
  - Minimum window sill height:** IRC 2006 and later requires that floor window sills be 24" from floor. Confirm bottom of window opening relative to frame. Adjust head heights as required to conform to IRC 2009 R312.2, or provide code approved gables.

NUMBER	QTY	WIDTH	HEIGHT	RC	WINDOW SCHEDULE	EGRESS	TEMPERED	SINGLE AWNING	MANUFACTURER	COMMENTS
W01	5	47 1/2"	23 1/2"	24"x24"	PARADIGM	YES		SINGLE AWNING		
W02	1	28 1/2"	47 1/2"	48"x24"	PARADIGM			SINGLE CASSEMENT		
W03	1	28 1/2"	47 1/2"	30"x48"	PARADIGM			DOUBLE HUNG		
W04	1	28 1/2"	47 1/2"	30"x48"	PARADIGM			DOUBLE HUNG		
W05	1	28 1/2"	47 1/2"	30"x48"	PARADIGM			DOUBLE HUNG		
W06	4	38"	61 1/2"	38 1/2"x62"	PARADIGM	YES		DOUBLE HUNG		
W07	1	71"	61 1/2"	71 1/2"x62"	PARADIGM	YES		DOUBLE HUNG		
W08	2	76"	61 1/2"	76 1/2"x62"	PARADIGM	YES		DOUBLE HUNG		

Your use of these drawings constitutes an acceptance of responsibility as outlined in "Dear Code Officer" on the first page of these drawings, and on our web site: <http://www.artformhomeplans.com/contact-us>

If you have any concerns or questions, please feel free to contact us. We are happy to clarify matters that fall within our scope, as listed on the first page. We can also often provide as energy design/analysis, or additional detailing.

**Artform Home Plans**  
AHP Design # 326.120.v10 SL  
© 2008-2019 Artform Architecture 603.437.5559  
April Yarrow  
Lot 9 Riverlee Commons  
Lee, NH 03801



1. Builder shall consult and follow the building code and other regulations in effect for the building site for all construction details not shown in these drawings. Requirements described here are specific to this design and/or are provided as reference. Additional building code or local requirements may apply.

2. Builder shall maintain a safe worksite, including but not limited to, provision of temporary supports where appropriate and adherence to applicable safety standards.
3. Design is based on the snow load listed on the framing plans, 100 mph wind speed, Exposure (psd) B, soil bearing capacity of 2000 psf, and Seismic Category C, unless otherwise noted on the framing plans. Builder shall promptly inform Atlanta Home Plans of differing conditions.

1. No footing shall be poured on loose or unsuitable soils, in water or on frozen ground.

2. All exterior footings to conform to all applicable code requirements for frost protection.

3. All concrete shall have a minimum compressive strength of at least 3000 PSI at 28 days.

4. Foundation anchorage to comply with IRC 2009 Section R403.5. It shall consist of minimum size 1/2" diameter anchor bolts with 3/16" x 2" x 2" washers at a maximum of 12" for two stories or 48" or more than two stories, max of 12" for each corner min of 2 bolts per wall. Anchor bolt shall extend 7" into concrete or grouted cells of concrete masonry units. Be aware that a garage under may be counted by your code official as a story. Additional anchorage may be required at drilled walls.

1. All structural wood shall be identified by a grade mark or certificate of inspection by a recognized inspection agency.
2. Structural wood shall be Spruce-Pine-Fir (SPF) #2 or better.
3. When used, LVL or PSL indicate Laminated Veneer Lumber or Parallel Strand Lumber, respectively. Products used shall equal or exceed the strength properties for the size indicated as manufactured by Trusjoist.

4. When used, AJS indicates wood Joists as manufactured by Boise Cascade. Products of alternate manufacturers may be substituted provided they meet or exceed the strength properties for the member specified.
5. All floor joists shall have bridging installed at mid-span or at 8'-0" or maximum.

6. Floor systems are designed for performance with subfloor glued and screwed.
7. All posts provide full 1/2" bearing length for all beams and headers, unless noted otherwise.
8. All wood permanently exposed to the weather, in contact with soil, or in contact with water, shall meet the code requirements for wood in these environments.
9. Deck ledgers shall be securely attached to the structure and/or independently supported, including stairs and lateral bracing.
10. Deck fasteners shall be installed in accordance with local practices. Unless otherwise noted, decks shall have solid 4x4 posts up to 6 ft above grade, and solid 8x8 for heights above that.

10. Wherever beams are noted as Flush framed, install joist hangers *all joists*, sized appropriately for the members being connected.
11. Support the lower end of roof beams via minimum 2" horizontal bearing on a post, ledger or via an appropriately sized and configured hanger.
12. Where multiple beams are supported on one post, provide min 2" bearing for each, via either appropriately sized post cap or additional post(s).
13. Hangers, post caps, and other connectors shall be as manufactured by Simpson Strong Tie, as designed to connect the members shown, and shall be installed per manufacturer's instructions.

### TYPICAL PERIMETER FOUNDATION WALL

### TYPICAL PERIMETER FOUNDATION WALL


- 8" poured concrete, 8 ft forms, min 7'-10" finished, with total of 3 rebar, as follows:
  - (1) #4 rebar, 4" from top
  - (1) #4 rebar @ vertical midpoint. Omit this rebar at walls 4 ft high or less.
  - (1) #4 rebar, min 3" from bottom or per code
- Laid corners & splices of rebar per code.

wood sill splices - If built-up sill, bolts must extend through a sill plates or straps must secure all sill plates.

2. Select column for row load shown on the structural plans.
3. Select soil bearing pressure based on soil type and/or consultation with case officer.
4. The required footing size is the intersection of the Snow Load and Soil PSI. Repair is not required. Key or pin foundation wall to footing per code. For the purposes of permitting, soil bearing for New England is assumed to be 2,000 PSI.
5. F&G - adding repair to footings does not reduce the required width. Repair affects performance with earth movement, like an earthquake and has new zero effect on bearing capacity.


3,000	Sandy gravel and/or gravel (GW and GP)
2,000	Sand, silty sand, clayey sand, silty gravel and clayey gravel (SW, SP, SM, SC, GM and GC)
1,500	Clay, sandy clay, silty clay, clayey silt, silt and sandy silt (CL, ML, MH and CH)

<b>Footling Size Type 8.8.28</b>  up to 28 ft plan depth 8 ft nominal basement height 8" foundation wall Full basement plus 2 stories	<b>Snow Load</b>		
	50	80	80
	16" x 8"	16" x 8"	16" x 8"
	16" x 8"	16" x 8"	20" x 8"
	22" x 6"	24" x 6"	24" x 6"
<b>Soil</b> 3,000 2,000 PSI 1,500	16" x 8" 16" x 8" 16" x 8" 22" x 6"	16" x 8" 16" x 8" 16" x 8" 24" x 6"	16" x 8" 20" x 8" 24" x 6" 24" x 6"

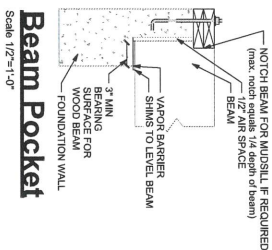



## Beam Pocket

Scale 1/2"=1'-0"

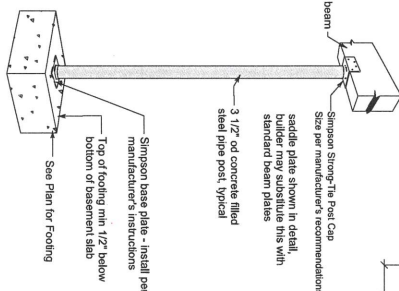

**Typical Basement Post**

Not to Scale

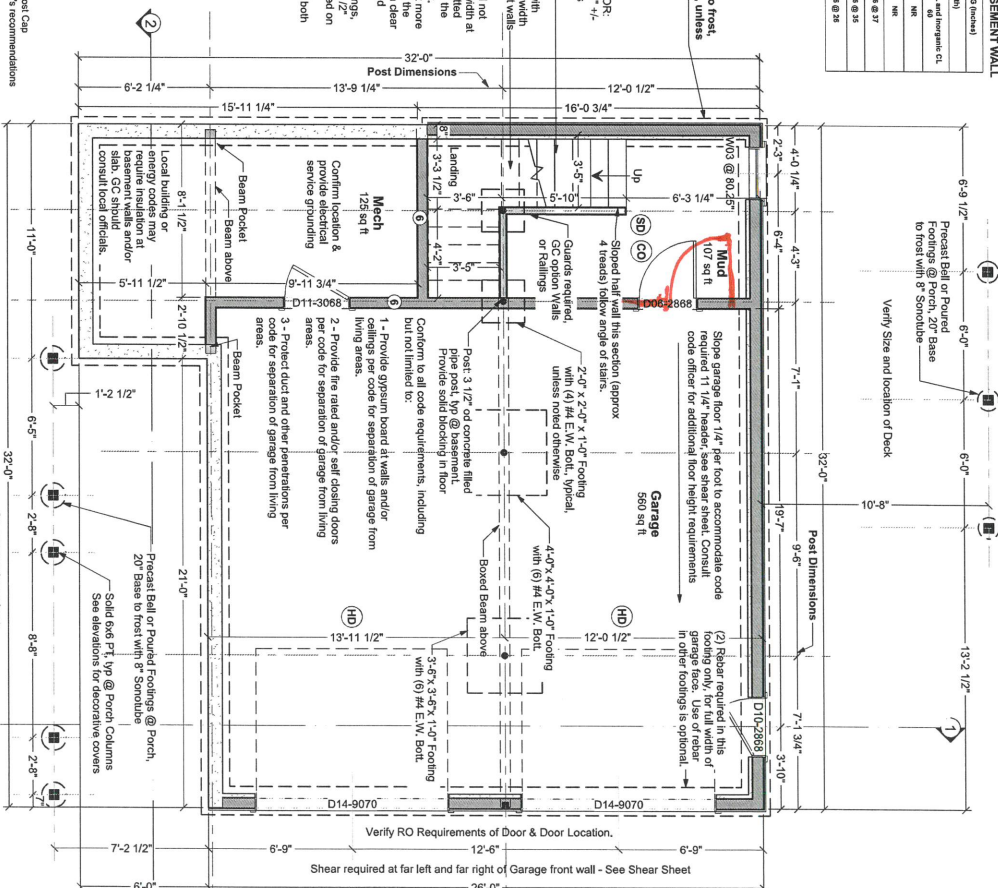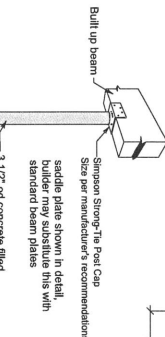

## Foundation Plan

Structure designed for  
Snow Load of 50 PSF

**Foundation Contractor Check List**

- Initials Date Checked

- |  |       |
|--|-------|
| Confirmed soil bearing   | _____ |
| Checked w/GC for added foundation steps to suit grade                | _____ |
| Confirm sill plate thickness (foundation bolts to extend through all | _____ |

---

## Artform Home Plans

AFHP Design # 326.120.v10 S  
© 2008-2019 Art Form Architecture 603

April Yarrow

3	Issued for: Construction
---	-----------------------------