

4/13/2015


Twin Peaks

442.124.v4

© 2015 Wendy Welton, all rights reserved. You may not build this design without purchasing a license, even if you make changes. This design may have geographic restrictions.



603-431-9559

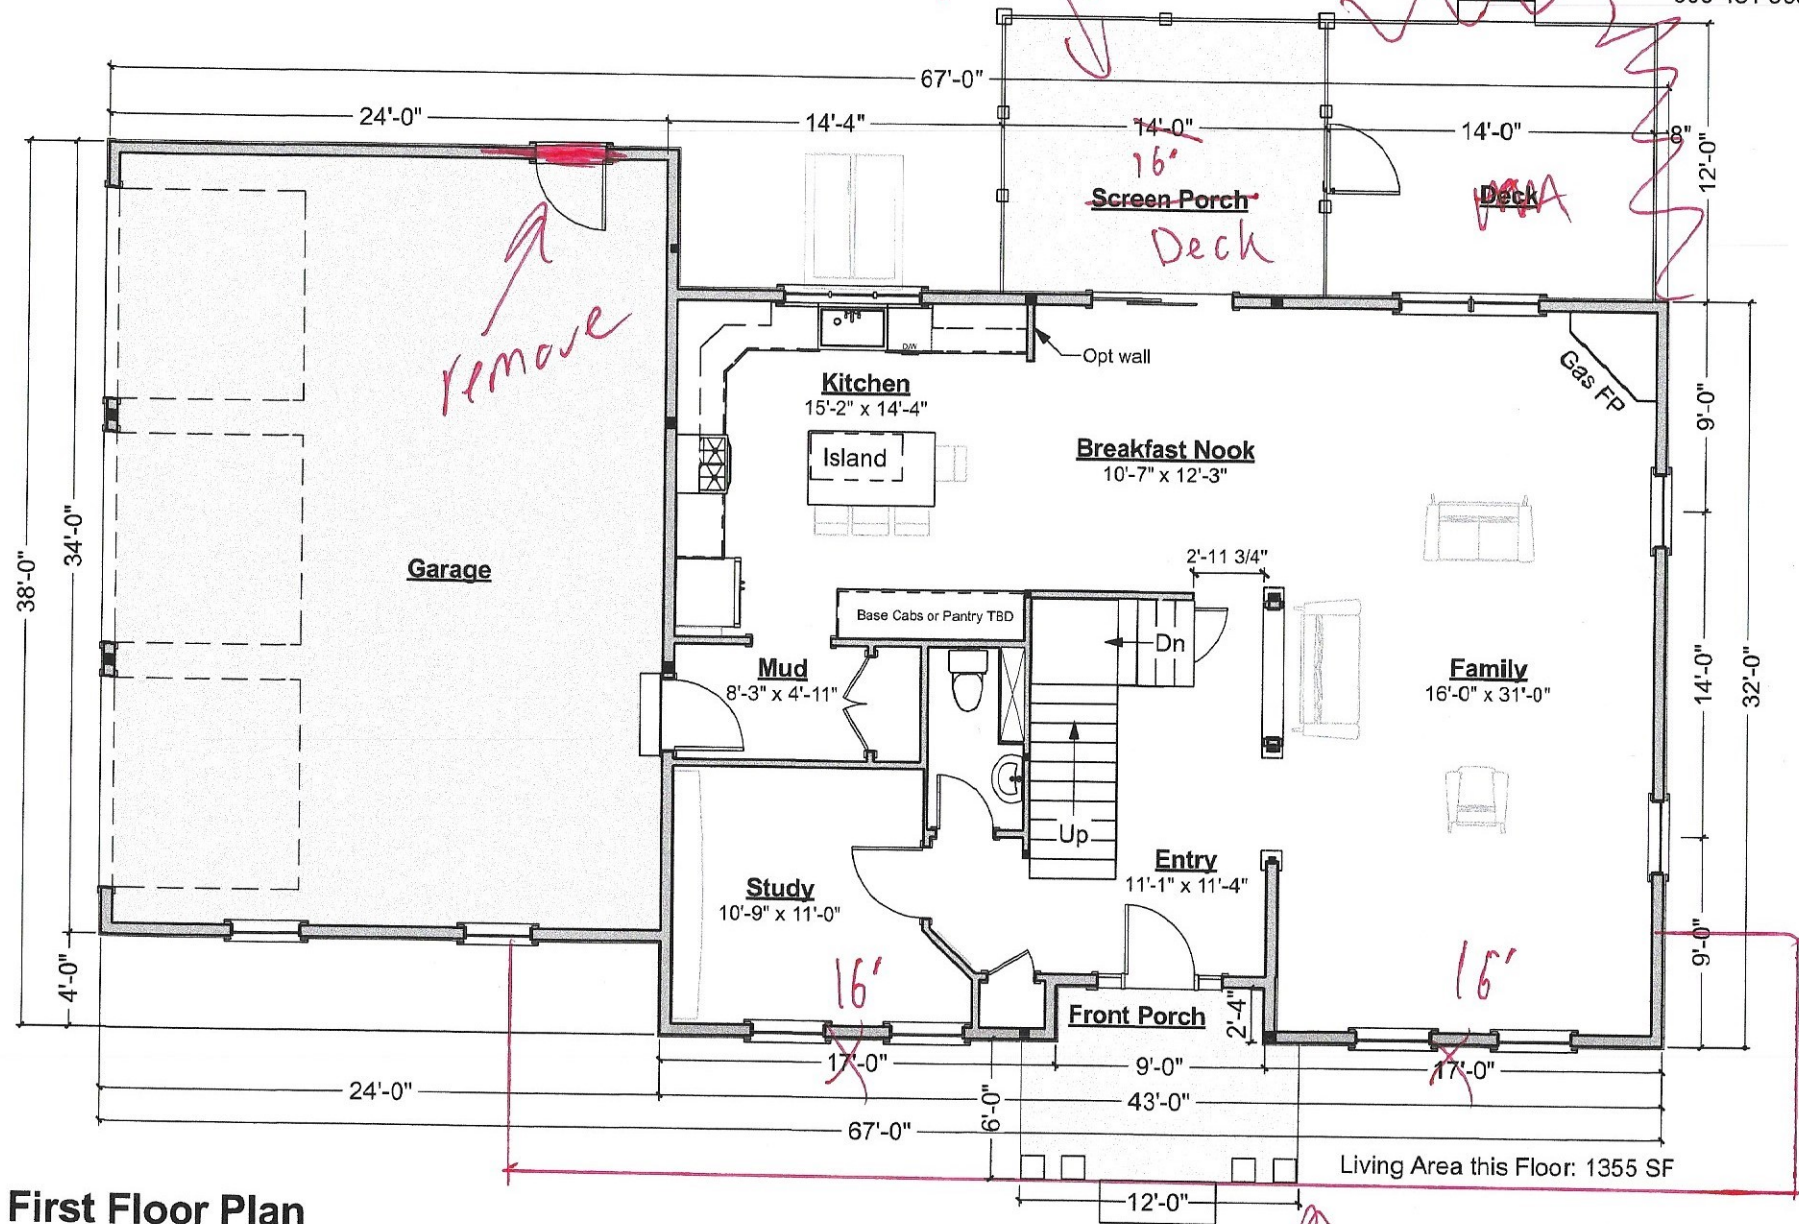

First Floor Plan

1/13/2015


Twin Peaks

442.124.v4

© 2015 Wendy Welton, all rights reserved. You may not build this design without purchasing a license, even if you make changes. This design may have geographic restrictions.

 **Artform Home Plans**

603-431-9559

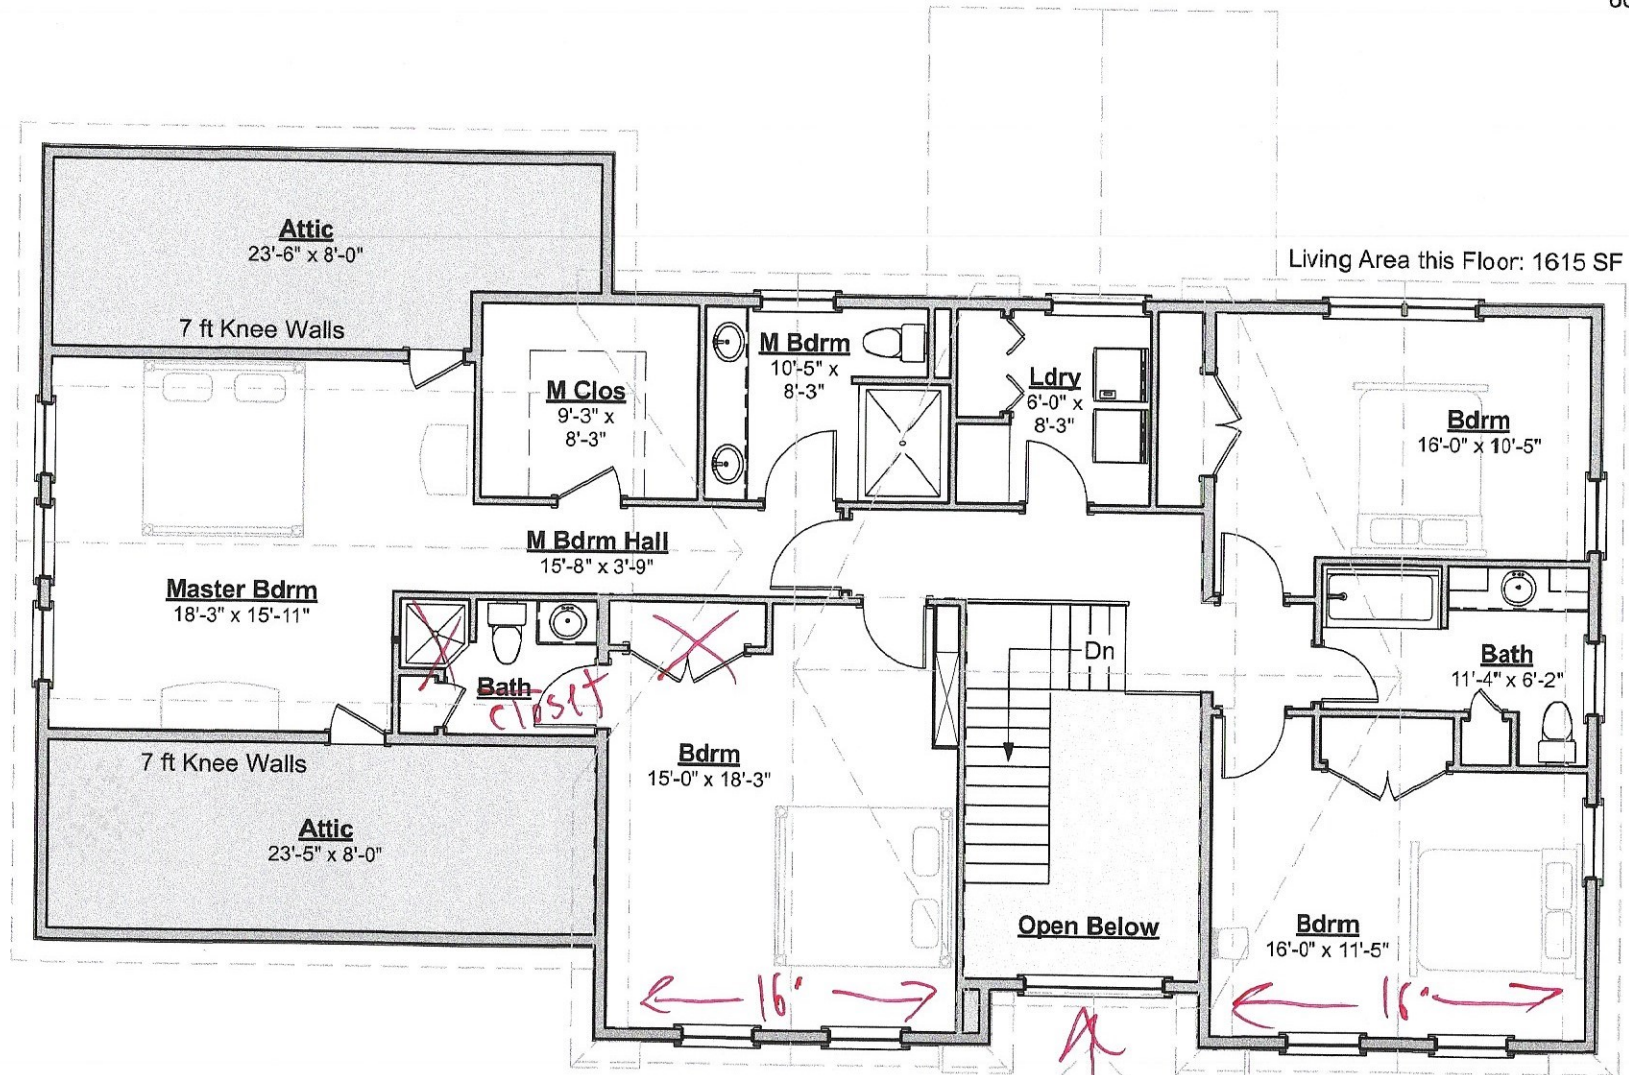

Second Floor Plan