
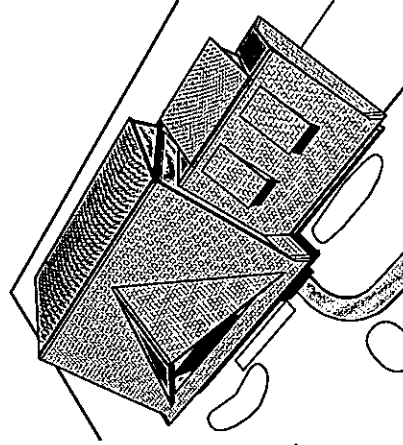


Gilligan Classic 398.002

© 2011-2013 Wendy Welton, all rights reserved. You may not build this design without purchasing a license, even with changes. Some Artform designs have geographic restrictions. Contact the Builder or RE Agent or call Artform at 603-431-9559


Artform Home Plans

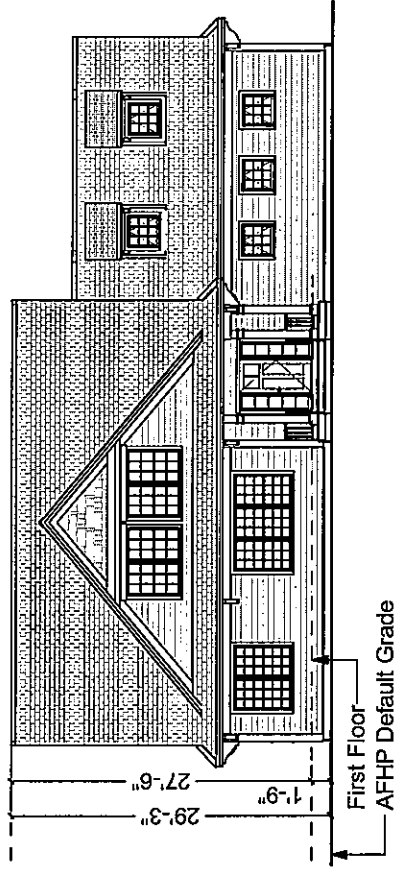

Builder's written specifications always govern. Some items shown are optional or may vary, including but not limited to:

- Gas fireplace and surround
- Kitchen - island, cabinet style & trim, counter material, etc.
- Bath - vanity size, number / style of sinks, tub or shower...
- Other built-ins.
- Door styles and trim
- Window grilles and trim, window treatments
- Stair balusters or low walls at stairs
- Lighting
- Material selections (flooring, siding, roofing, paint colors...)
- Landscaping, paving and walkways
- Gutters, shutters and other exterior trim components
- Deck - size, railing style, stair location, etc.
- Amount of exposed basement and/or wood framed walls at basement.

These images are not of any specific building site. Sun and view through windows will vary, as will the site surrounding the house and the slope of the land.

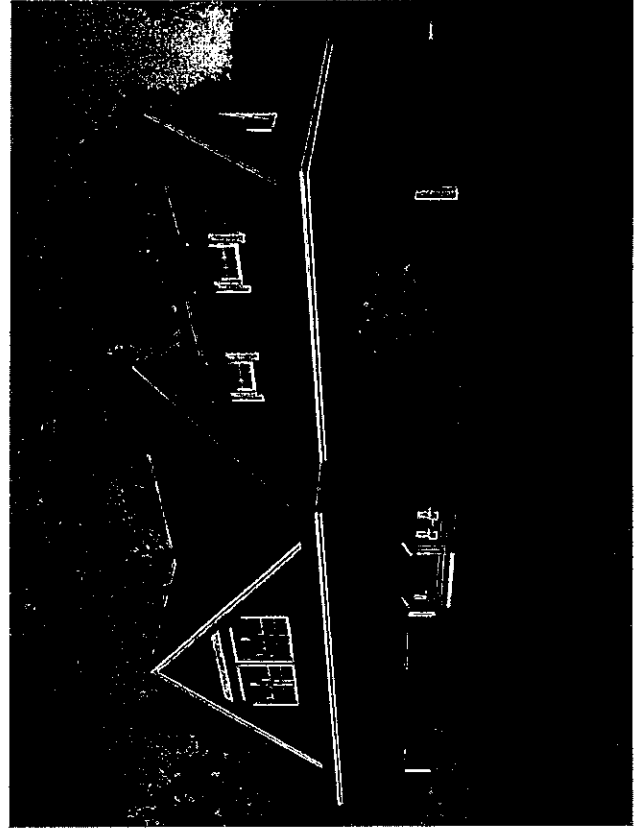


Gilligan Classic 398.002

© 2011-2013 Wendy Welton, all rights reserved. You may not build this design without purchasing a license, even with changes. Some Artform designs have geographic restrictions. Contact the Builder or RE Agent or call Artform at 603-431-9559



Second Floor

Remove chase

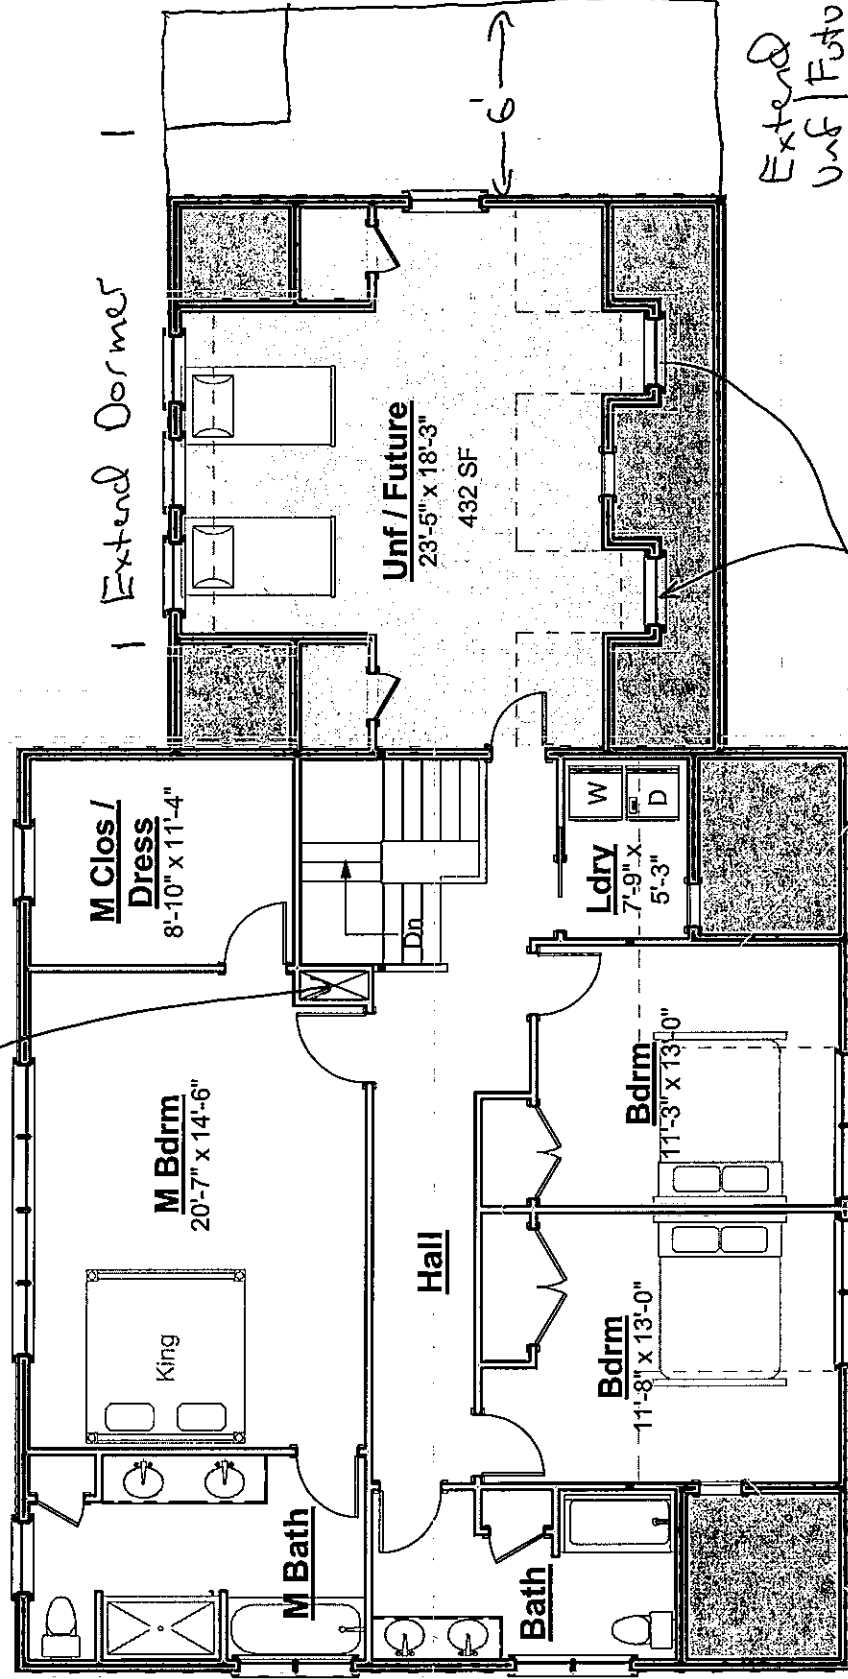

Living Area this Floor: 1332 SF

Reverse this Plan


Gilligan Classic

398.002

© 2011-2013 Wendy Welton, all rights reserved. You may not build this design without purchasing a license, even with changes. Some Artform designs have geographic restrictions. Contact the Builder or RE Agent or call Artform at 603-431-9559



First Floor

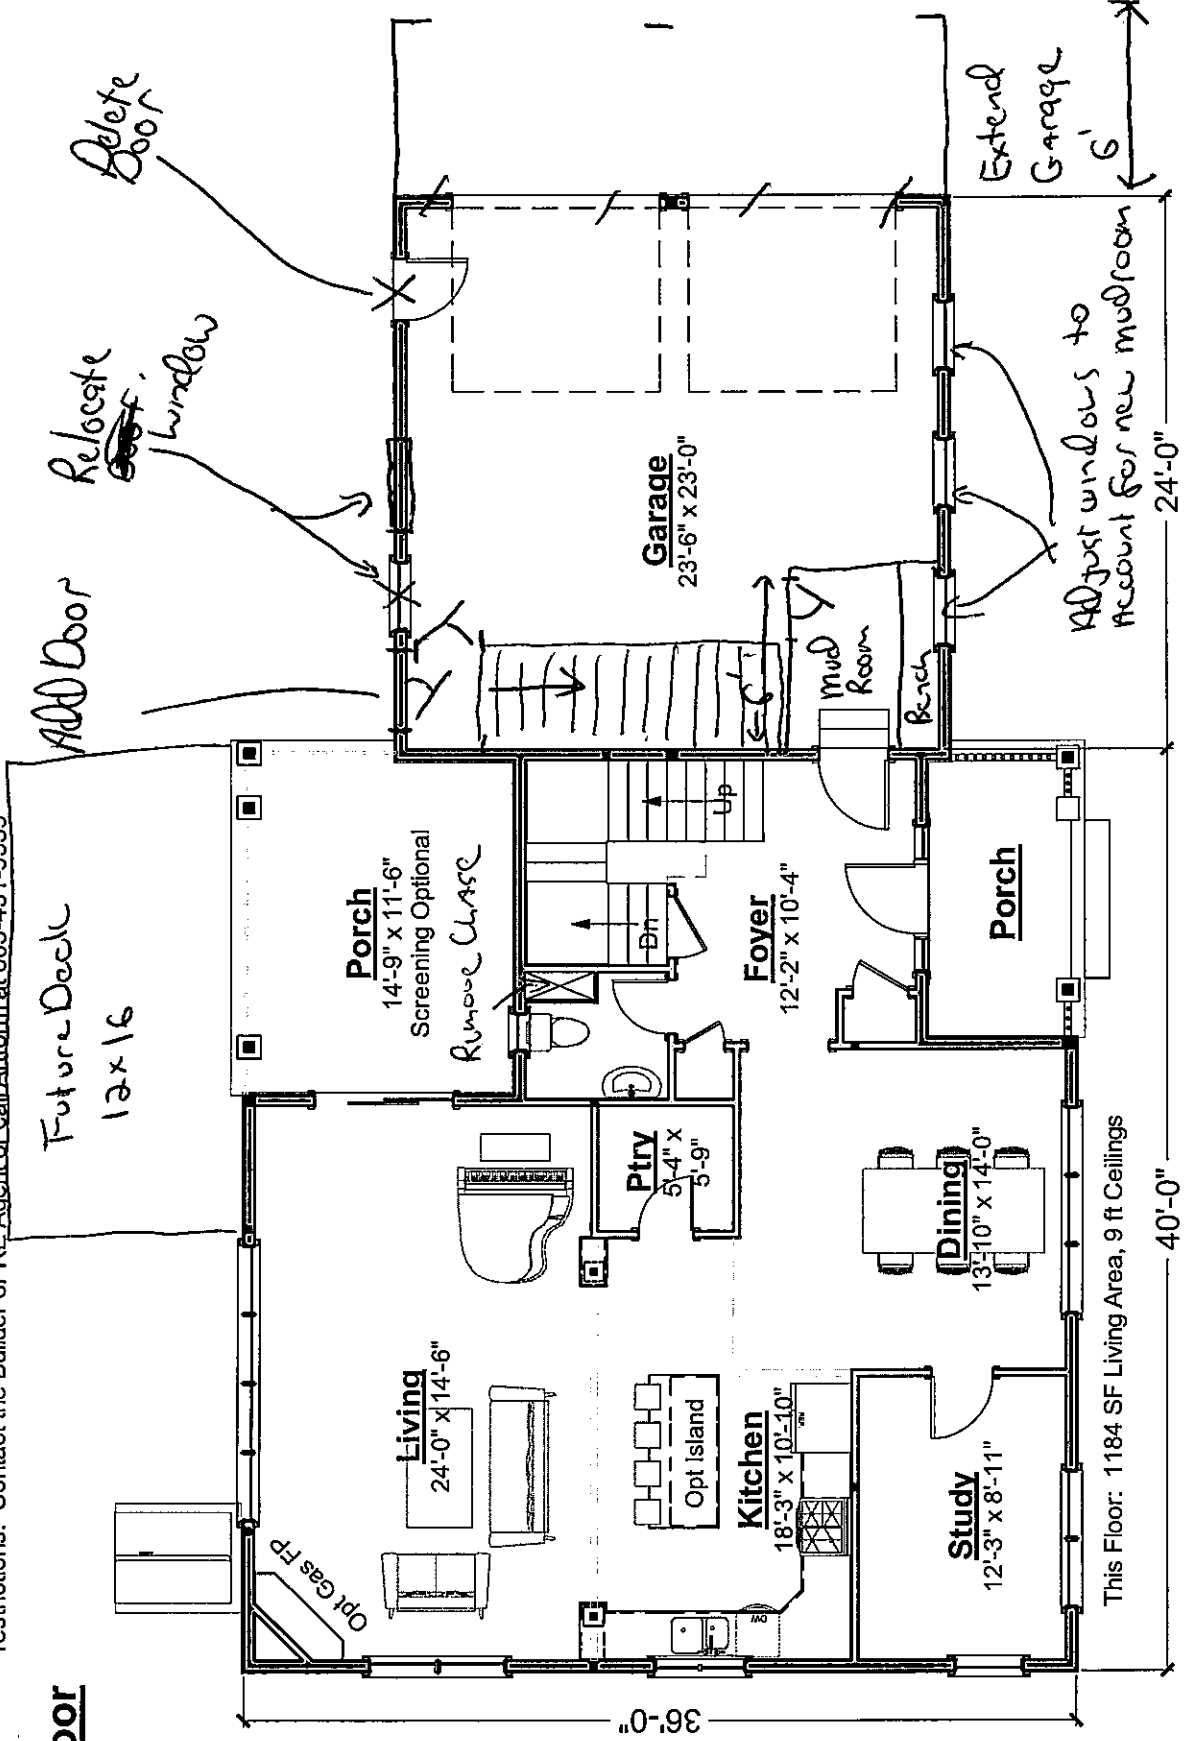

Reverse this plan